



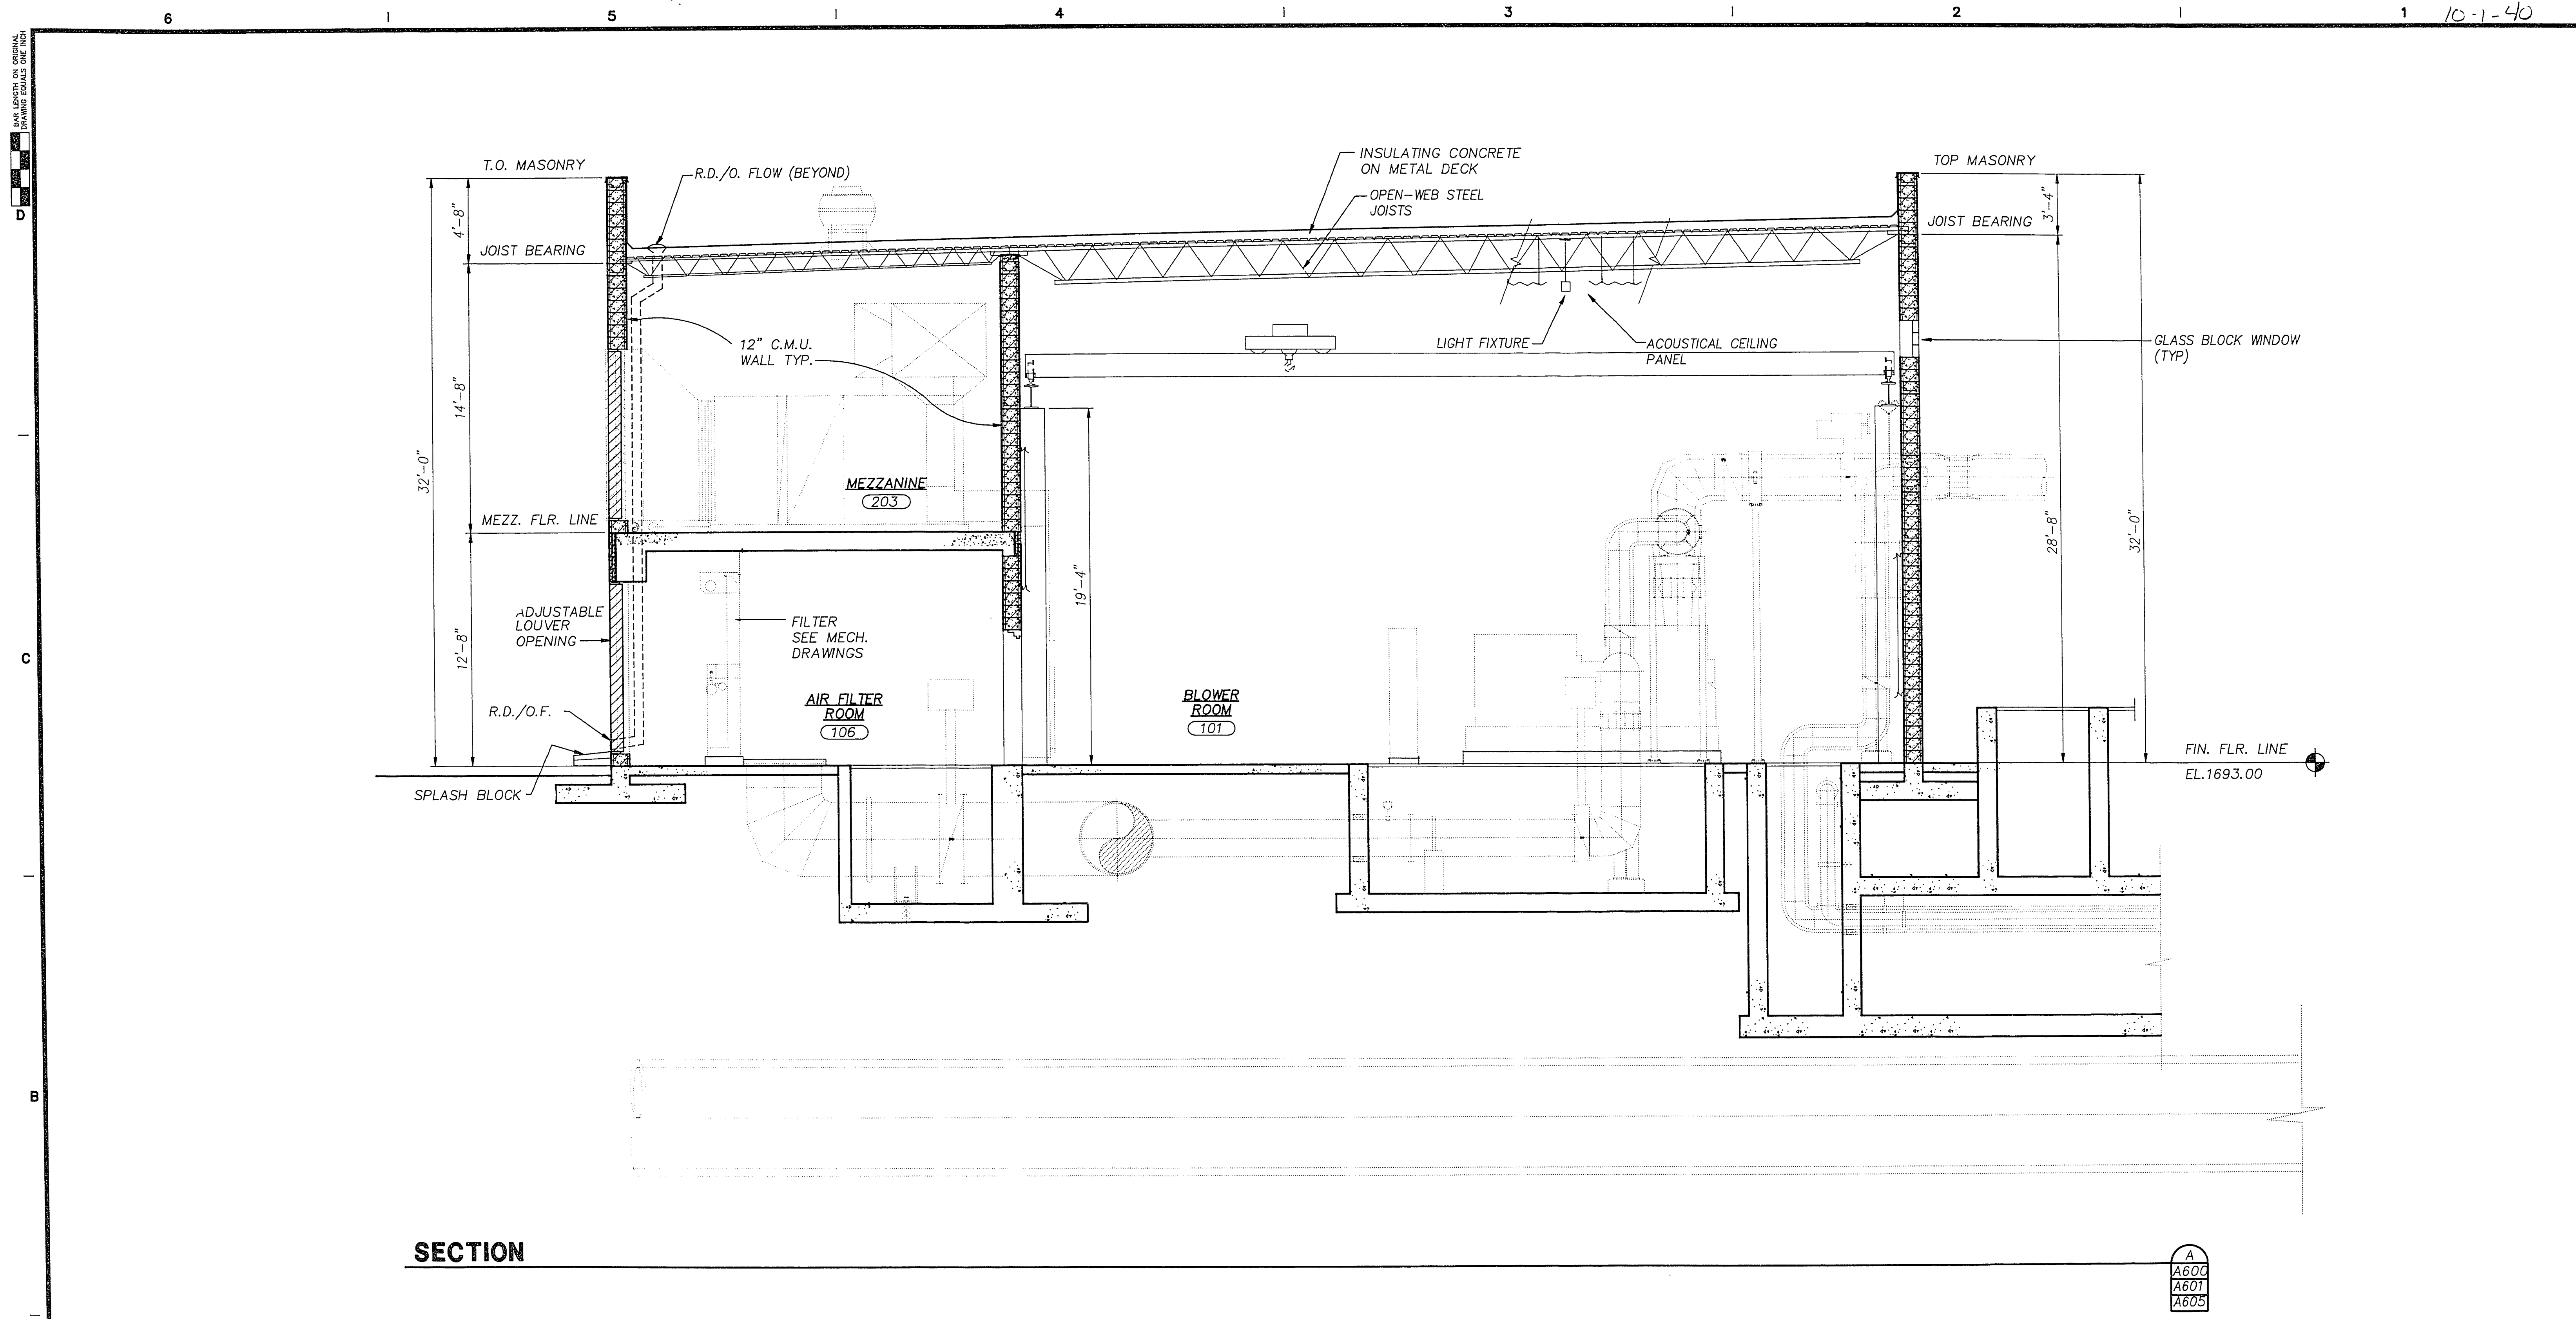


SECTION

A
A600
A601
A605

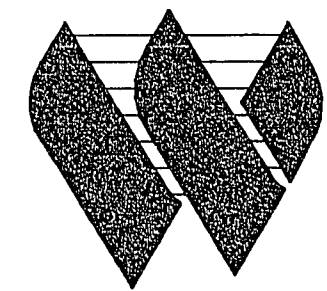


G.C. WALLACE, INC.
Engineering/Architecture

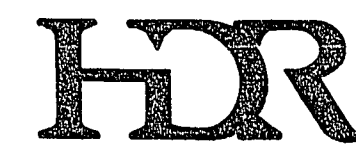

HDR Engineering, Inc.

Issue No.	Description	Date	Drawn	Checked	Responsible	Project Manager
1	CORRECTED ACCORDING TO CONSTRUCTION RECORD	1/95	RRL	EFH	MJH	JJC
0	ISSUED FOR CONSTRUCTION	8/20/92	DCL	DSD	DSD	JJC

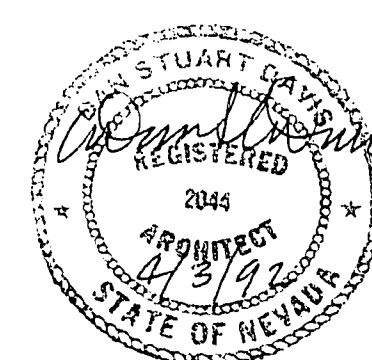

Project Manager	JOHN J. CHUEH
Architect	D. DAVIS
Civil	
Electrical	
Structural	
Drawn By	B. DeLUNA

City of Las Vegas
Water Pollution Control Facility
Nitrification / Filtration Facilities
Contract 17
NITRIFICATION COMPLEX

**BLOWER BUILDING
SECTION**

Date	APRIL 1992	Project No.	00120-084-141	Drawing No.	A-604	Sheet	1
Scale	1/4" = 1'-0"						