
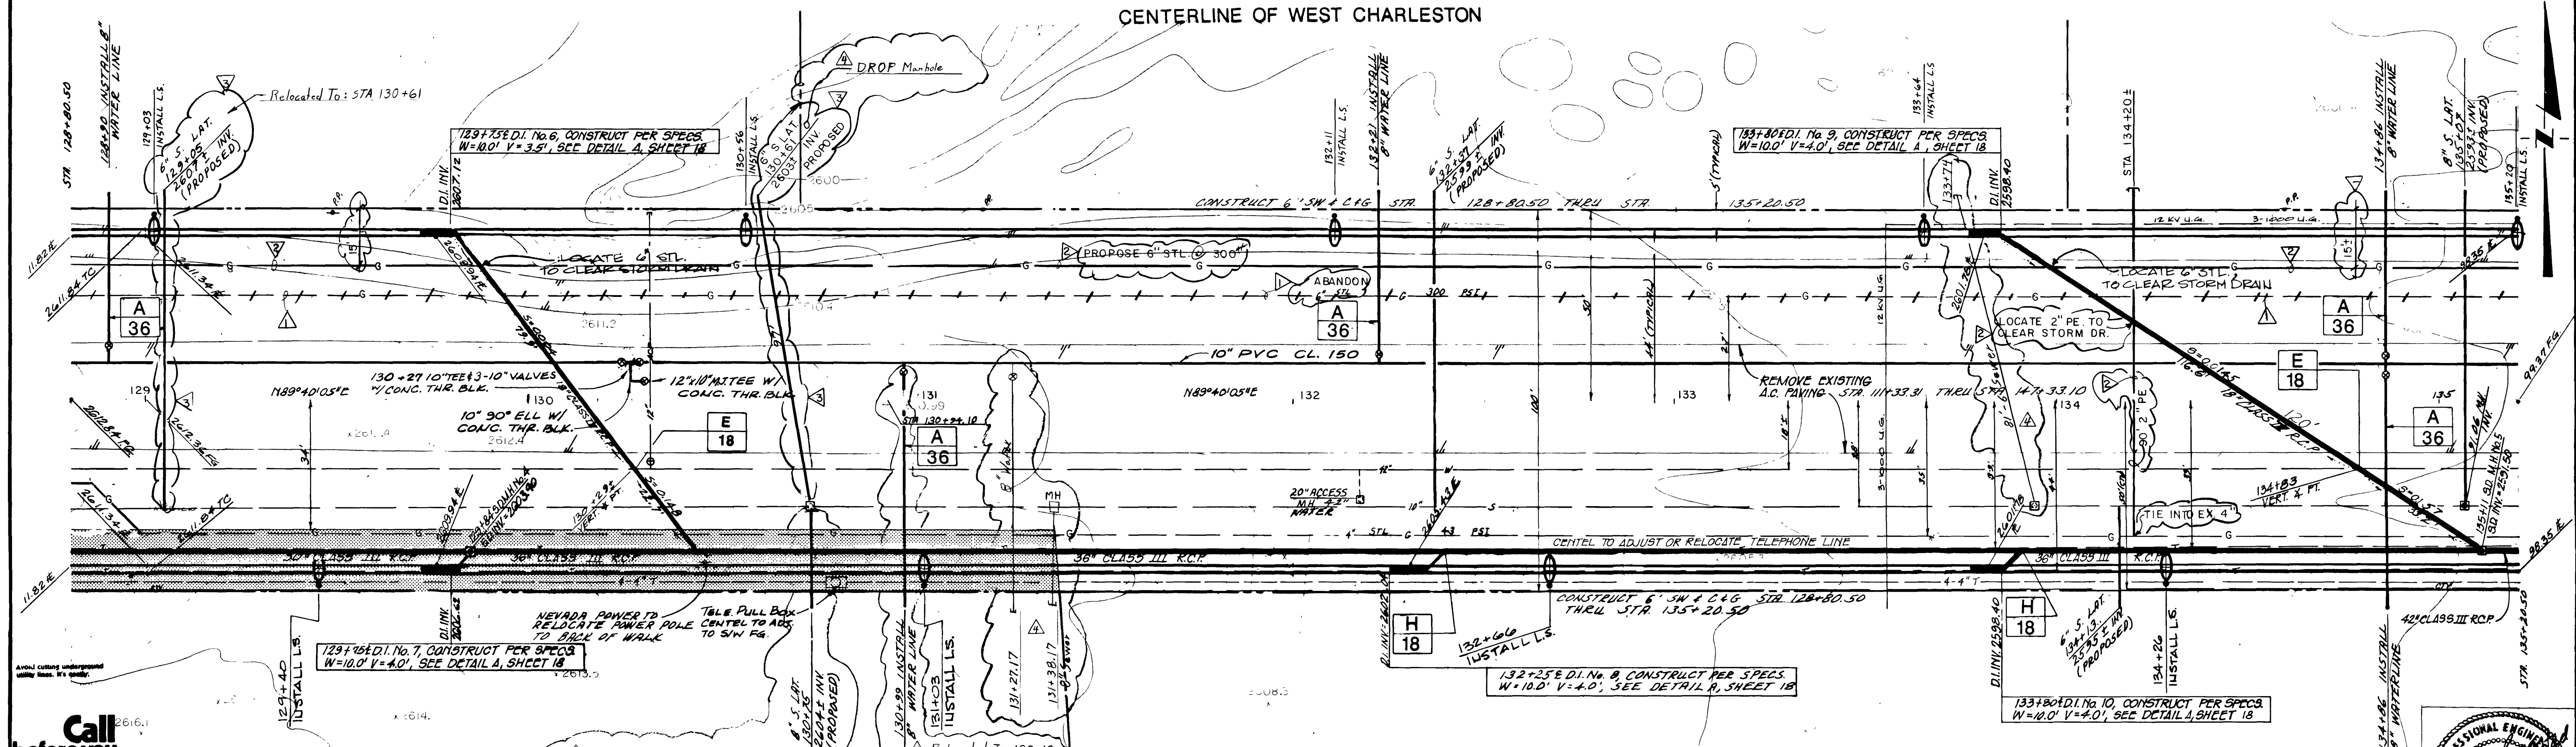


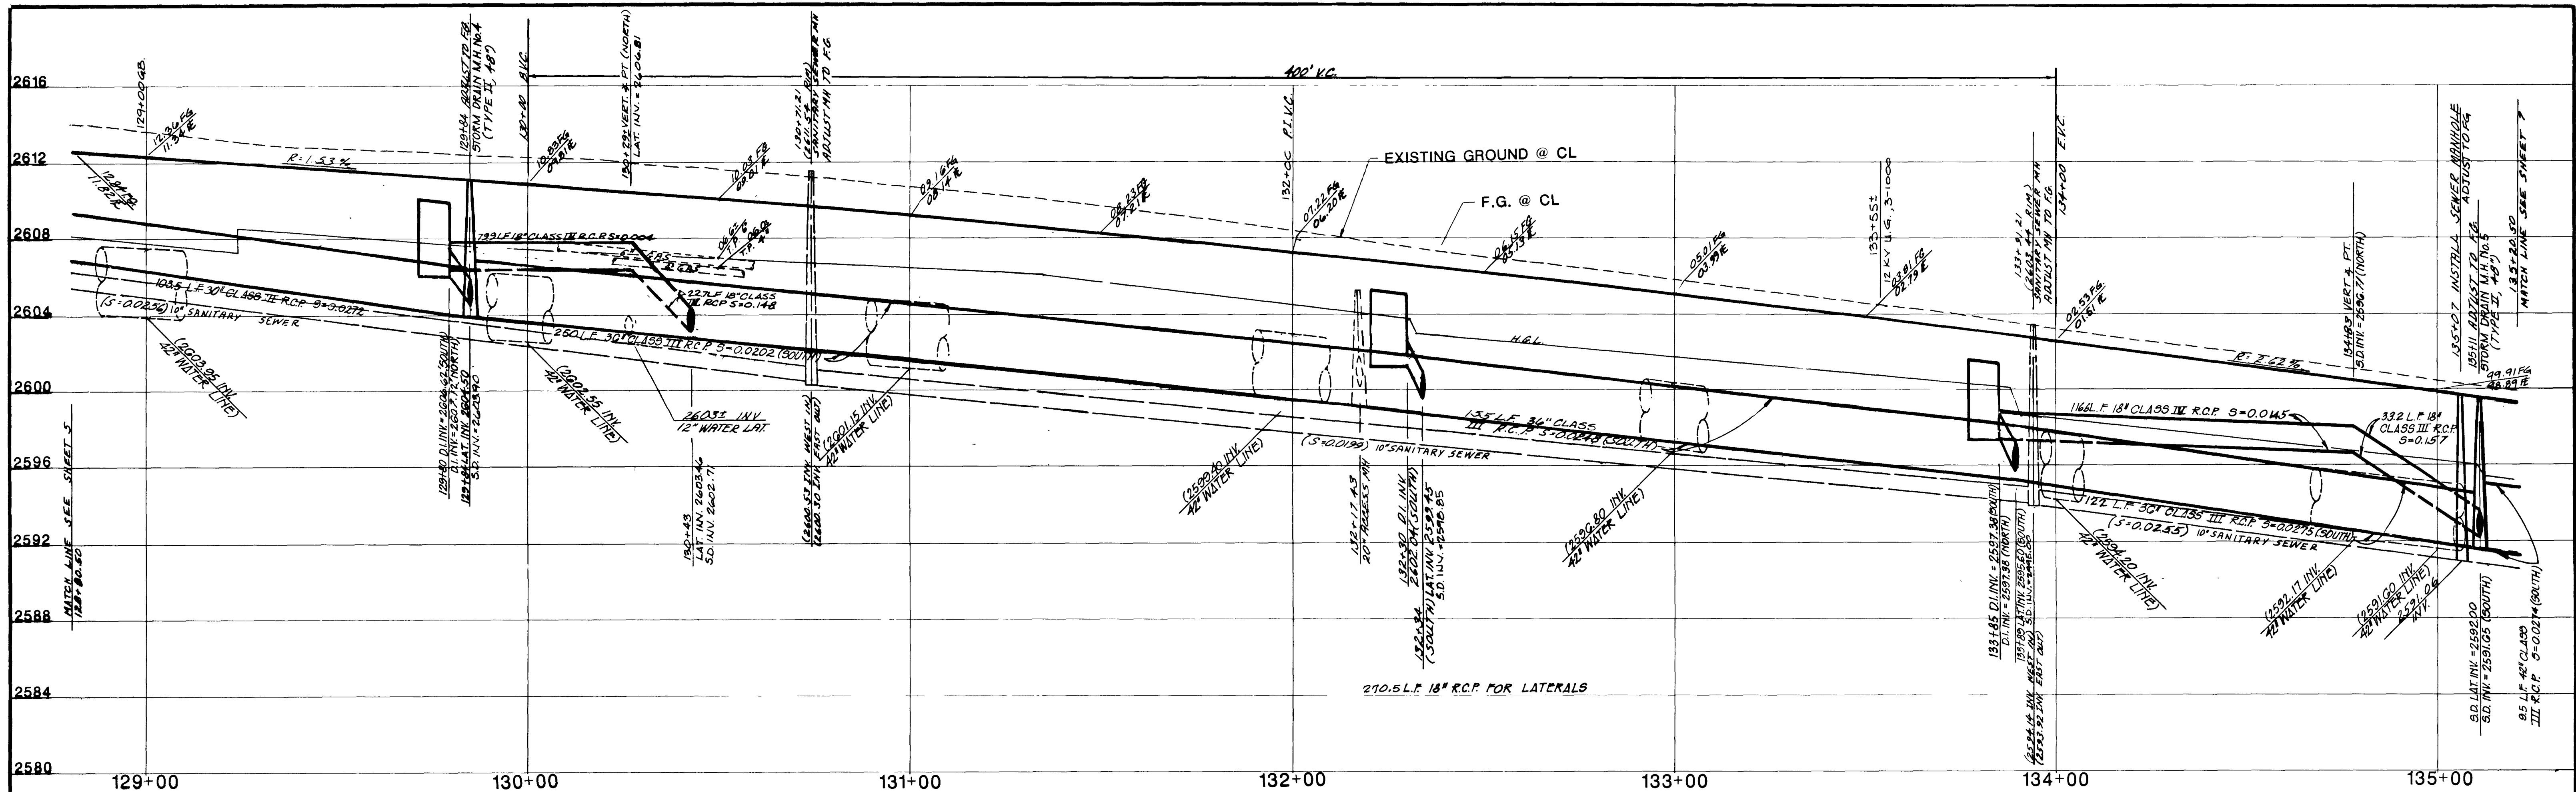

Call before you Dig.

1-800-227-2600

AS BUILT

NOTE: CONTRACTOR TO VERIFY EXACT DEPTH AND LOCATION OF EXISTING UTILITIES PRIOR TO EXCAVATION.

NOTE: ABOVE GROUND IMPROV IN SHADED PORTION TO BE CONSTRUCTED ONLY AFTER RELOCATION IS COMPLETE (SEE SPECS)

NOTE: HORIZ. ALIGNMENT DATA PROVIDED BY C.L.K.

PLAN COPY

FOR CONSTRUCTION REVISION ONLY

7/10 C.G. ABANDON EXIST. 6" STL. BY S.W. GAS 7/10 C.G. PROPOSED 2" PE 6" STL. BY S.W. GAS 7/13 C.G. RELOCATE 6" SEWER LATERAL FROM STA 129+05 TO STA 130+61 10/16 RT. AS BUILT	SCALE: HORIZONTAL 1" = 20' VERTICAL 1" = 4'	DESIGNED: J. EMERSON DRAWN: K. PATRICKSON CHECKED:	SUBMITTED: PROJECT ENGINEER RECOMMENDED: PROJECT ENGINEER JAMES M. MONTGOMERY CONSULTING ENGINEERS, INC.	APPROVED: DATE:	APPROVED: DATE:
---	--	--	--	-----------------	-----------------

JAMES M. MONTGOMERY CONSULTING ENGINEERS, INC.

2915 WEST CHARLESTON BLVD., LAS VEGAS, NEVADA 89102

CITY OF LAS VEGAS

WEST CHARLESTON BLVD.


PLAN AND PROFILE

128+80.50 TO 135+20.50

DWG. NO. 107-V1648

SHEET 6 OF 37

12-3-101

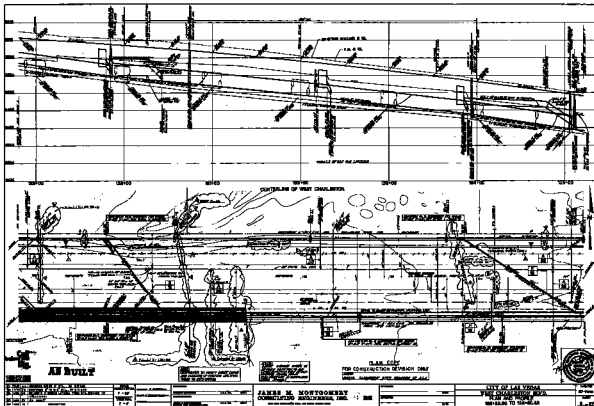

ALL BUILT 1. THE CONTRACTOR SHALL BE RESPONSIBLE FOR THE PROTECTION OF ALL EXISTING UTILITIES AND STRUCTURES AND FOR THE PROTECTION OF THE PUBLIC AND THE ENVIRONMENT. 2. THE CONTRACTOR SHALL BE RESPONSIBLE FOR THE PROTECTION OF ALL EXISTING UTILITIES AND STRUCTURES AND FOR THE PROTECTION OF THE PUBLIC AND THE ENVIRONMENT.	DATE: 10-1-10 BY: J. MONTGOMERY FOR: J. MONTGOMERY	1. THE CONTRACTOR SHALL BE RESPONSIBLE FOR THE PROTECTION OF ALL EXISTING UTILITIES AND STRUCTURES AND FOR THE PROTECTION OF THE PUBLIC AND THE ENVIRONMENT. 2. THE CONTRACTOR SHALL BE RESPONSIBLE FOR THE PROTECTION OF ALL EXISTING UTILITIES AND STRUCTURES AND FOR THE PROTECTION OF THE PUBLIC AND THE ENVIRONMENT.	JAMES M. MONTGOMERY CORPORATE ENGINEER, INC. 10-1-10	1. THE CONTRACTOR SHALL BE RESPONSIBLE FOR THE PROTECTION OF ALL EXISTING UTILITIES AND STRUCTURES AND FOR THE PROTECTION OF THE PUBLIC AND THE ENVIRONMENT. 2. THE CONTRACTOR SHALL BE RESPONSIBLE FOR THE PROTECTION OF ALL EXISTING UTILITIES AND STRUCTURES AND FOR THE PROTECTION OF THE PUBLIC AND THE ENVIRONMENT.	CITY OF LAS VEGAS WEST CHAULKWATER BRIDGE PLAN DECK 19-3-101
--	---	---	---	---	--