


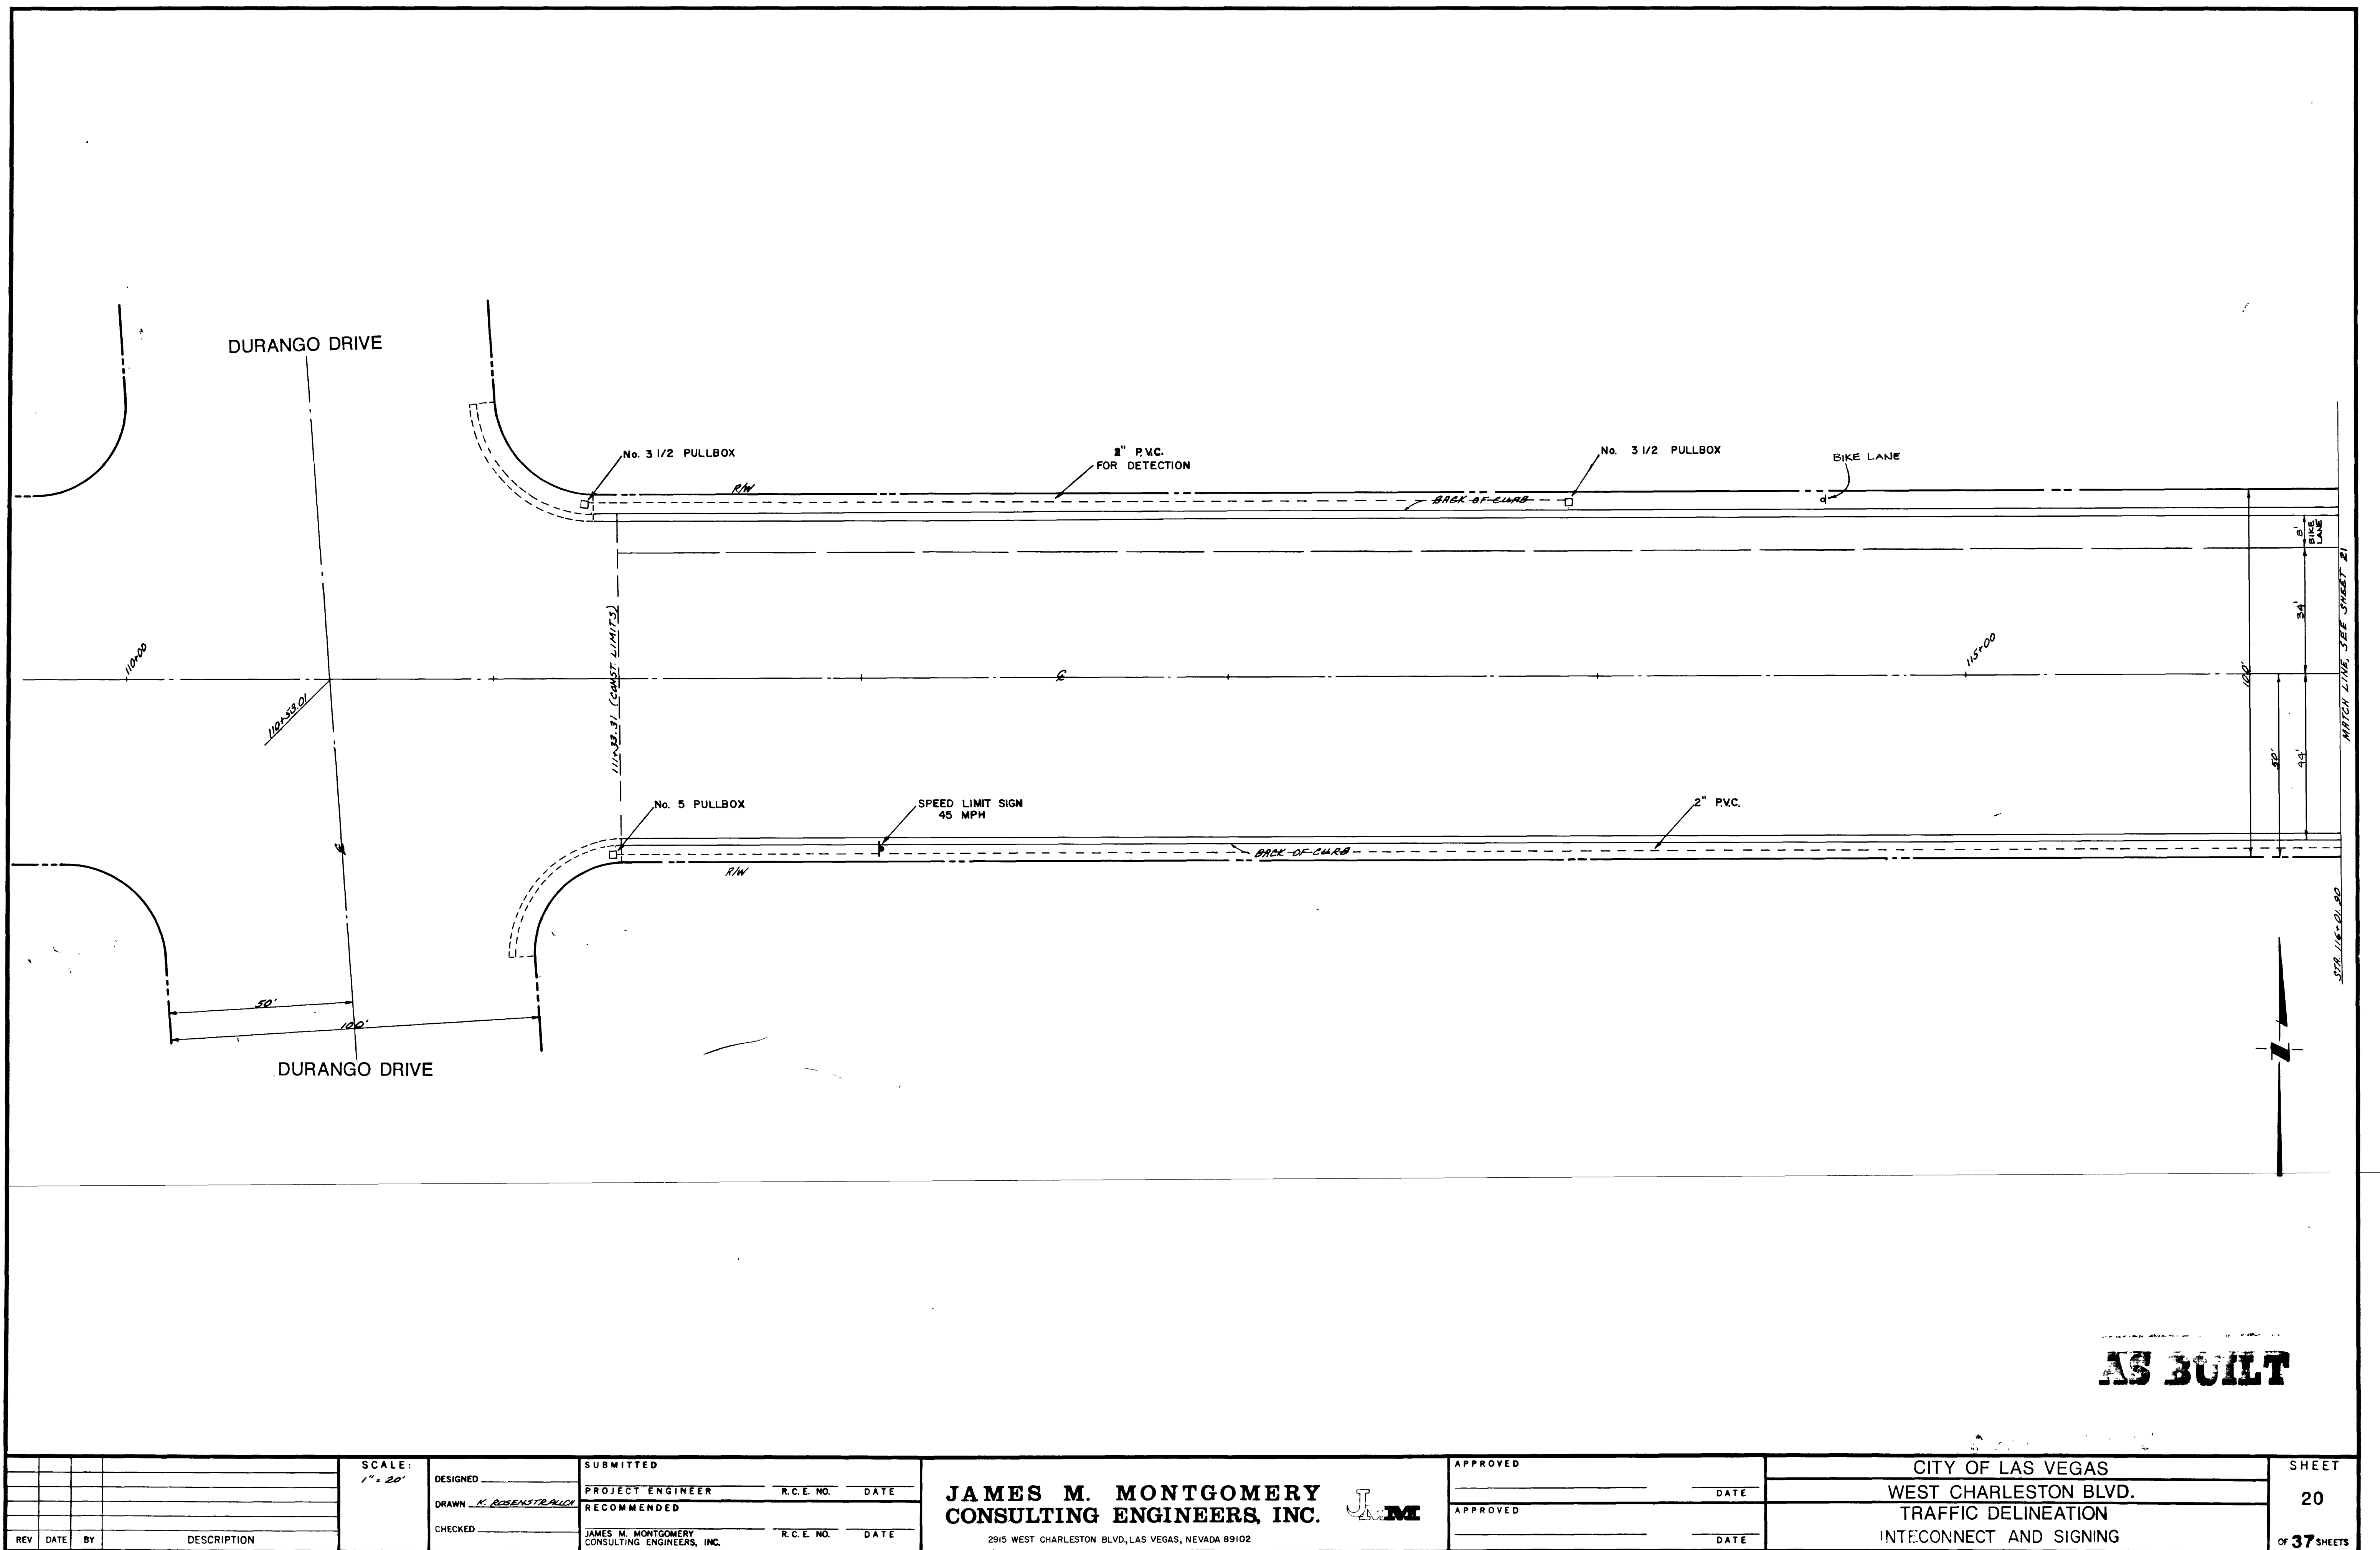


JOB NO. 1652-087 FILE CC

				SCALE: 1" = 20'		SUBMITTED				APPROVED				CITY OF LAS VEGAS				SHEET 20 OF 37 SHEETS
				DESIGNED _____		PROJECT ENGINEER _____ R.C.E. NO. _____ DATE _____				_____ DATE _____				WEST CHARLESTON BLVD.				
				DRAWN <u>K. ROSENSTRUCH</u>		RECOMMENDED _____				APPROVED _____				TRAFFIC DELINEATION				
REV	DATE	BY	DESCRIPTION	CHECKED _____		JAMES M. MONTGOMERY CONSULTING ENGINEERS, INC. R.C.E. NO. _____ DATE _____				_____ DATE _____				INTECONNECT AND SIGNING				

JAMES M. MONTGOMERY CONSULTING ENGINEERS, INC.
2915 WEST CHARLESTON BLVD, LAS VEGAS, NEVADA 89102



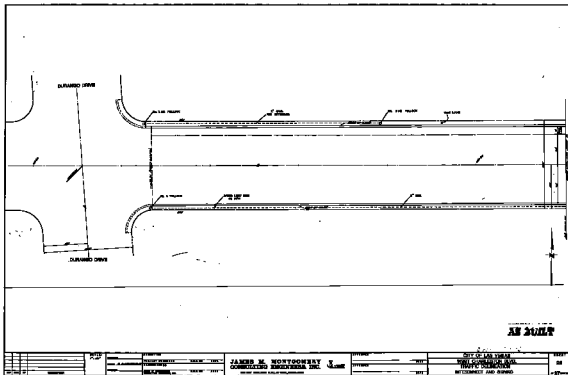

AS BUILT

SHEET 1 OF 1	DATE 1/1/11	PROJECT DURAND DRIVE 12' 10' 12' 10'	JAMES M. MONTGOMERY CONSULTING ENGINEERS INC. 12345 MAIN ST. SUITE 100 DALLAS, TEXAS 75201	DRAWN BY JMM	CITY OF LAS VEGAS TRAFFIC DIVISION 12345 MAIN ST.	12-1-11
-----------------	----------------	--	--	-----------------	---	---------