

**AS BUILT**


|   |      |   |             |  |  |   |  |                             |
|---|------|---|-------------|--|--|---|--|-----------------------------|
| SCALE: 1"=20'<br>DESIGNED: _____<br>DRAWN: <i>K. ROSENTRAUH</i><br>CHECKED: _____ |      | SUBMITTED<br>PROJECT ENGINEER: _____ R.C.E. NO. _____ DATE _____<br>RECOMMENDED<br>JAMES M. MONTGOMERY CONSULTING ENGINEERS, INC. R.C.E. NO. _____ DATE _____ |             | APPROVED _____ DATE _____<br>APPROVED _____ DATE _____ |  | CITY OF LAS VEGAS<br>WEST CHARLESTON BLVD.<br>TRAFFIC DELINEATION<br>INTERCONNECT AND SIGNING |  | SHEET<br>21<br>OF 37 SHEETS |
| REV   | DATE | BY  | DESCRIPTION |  |  |   |  |                             |

**JAMES M. MONTGOMERY CONSULTING ENGINEERS, INC.**  
 2915 WEST CHARLESTON BLVD., LAS VEGAS, NEVADA 89102



JOB NO. 1542-002 FILE CC

107-V1648  
12-3-116

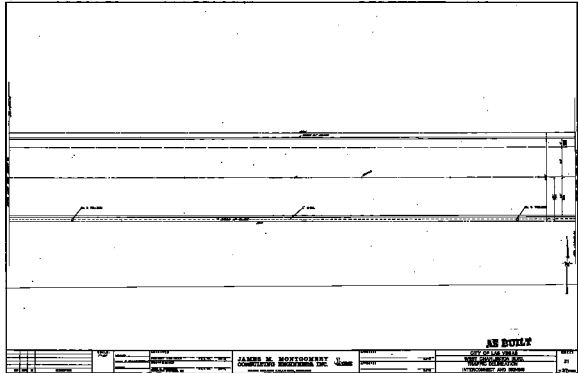

**AS BUILT**

|  |  |   |                                      |  |                        |
|--|--|---|--------------------------------------|--|------------------------|
| SHEET NO. _____ OF _____<br>DATE _____   |  | DRAWN BY _____<br>CHECKED BY _____<br>DATE _____  | PROJECT NO. _____<br>SHEET NO. _____ | CITY OF LOS ANGELES<br>WATER AND SEWER DIV.<br>INTERCONNECT AND REPAIR | DATE _____<br>BY _____ |
| CONTRACT NO. _____<br>PROJECT NAME _____ |  | ENGINEER<br><b>JAMES E. MONTGOMERY</b><br>CONSULTING ENGINEERS, INC.<br><small>1000 WEST 10TH STREET, LOS ANGELES, CALIF. 90057</small> | ARCHITECT<br>_____<br>_____          | CITY OF LOS ANGELES<br>WATER AND SEWER DIV.<br>INTERCONNECT AND REPAIR | DATE _____<br>BY _____ |