


JOB NO. 15742-0032 FILE CC

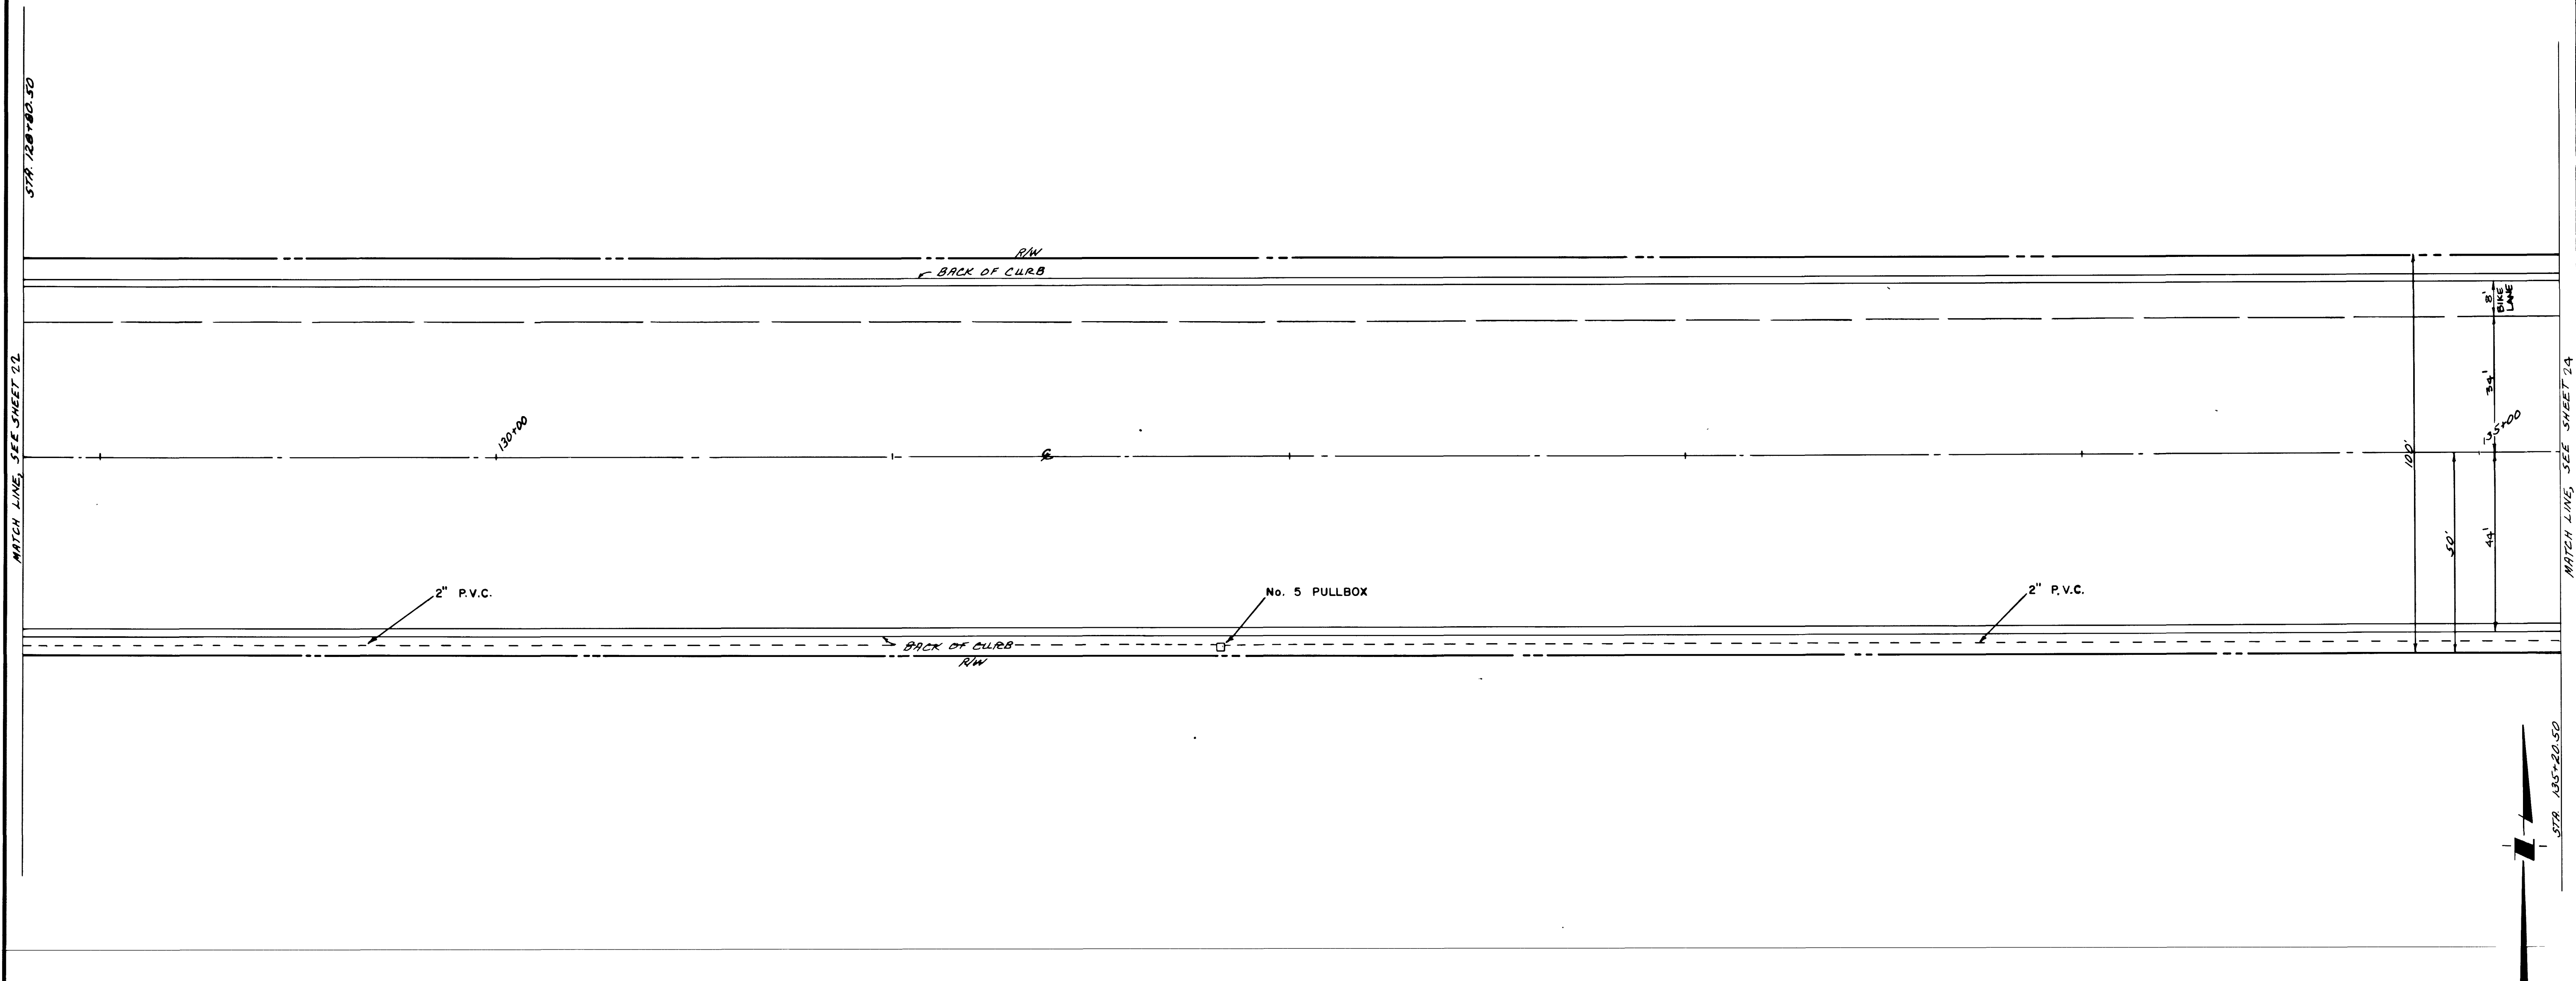

REV DATE BY DESCRIPTION				SCALE: 1" = 20'	DESIGNED _____		SUBMITTED _____		JAMES M. MONTGOMERY CONSULTING ENGINEERS, INC. 2915 WEST CHARLESTON BLVD., LAS VEGAS, NEVADA 89102	APPROVED _____ DATE _____		CITY OF LAS VEGAS		SHEET 23 OF 37 SHEETS
					DRAWN <i>K. ROSENSTRAUCH</i>		RECOMMENDED _____			APPROVED _____ DATE _____		WEST CHARLESTON BLVD. TRAFFIC DELINEATION INTERCONNECT AND SIGNING		

AS BUILT

		AS BUILT	
		DATE	
PROJECT CITY OF LAS VEGAS 2000 SUNSET BLVD TRAFFIC INTERCHANG	DATE 12-5-10	DESIGNED BY JAMES M. MONTGOMERY CONSULTING ENGINEERS, INC. 10000 LAS VEGAS BLVD.	DATE 12-5-10
PROJECT CITY OF LAS VEGAS 2000 SUNSET BLVD TRAFFIC INTERCHANG	DATE 12-5-10	DESIGNED BY JAMES M. MONTGOMERY CONSULTING ENGINEERS, INC. 10000 LAS VEGAS BLVD.	DATE 12-5-10