


JOB NO. 15410.00271 FILE _____ DC

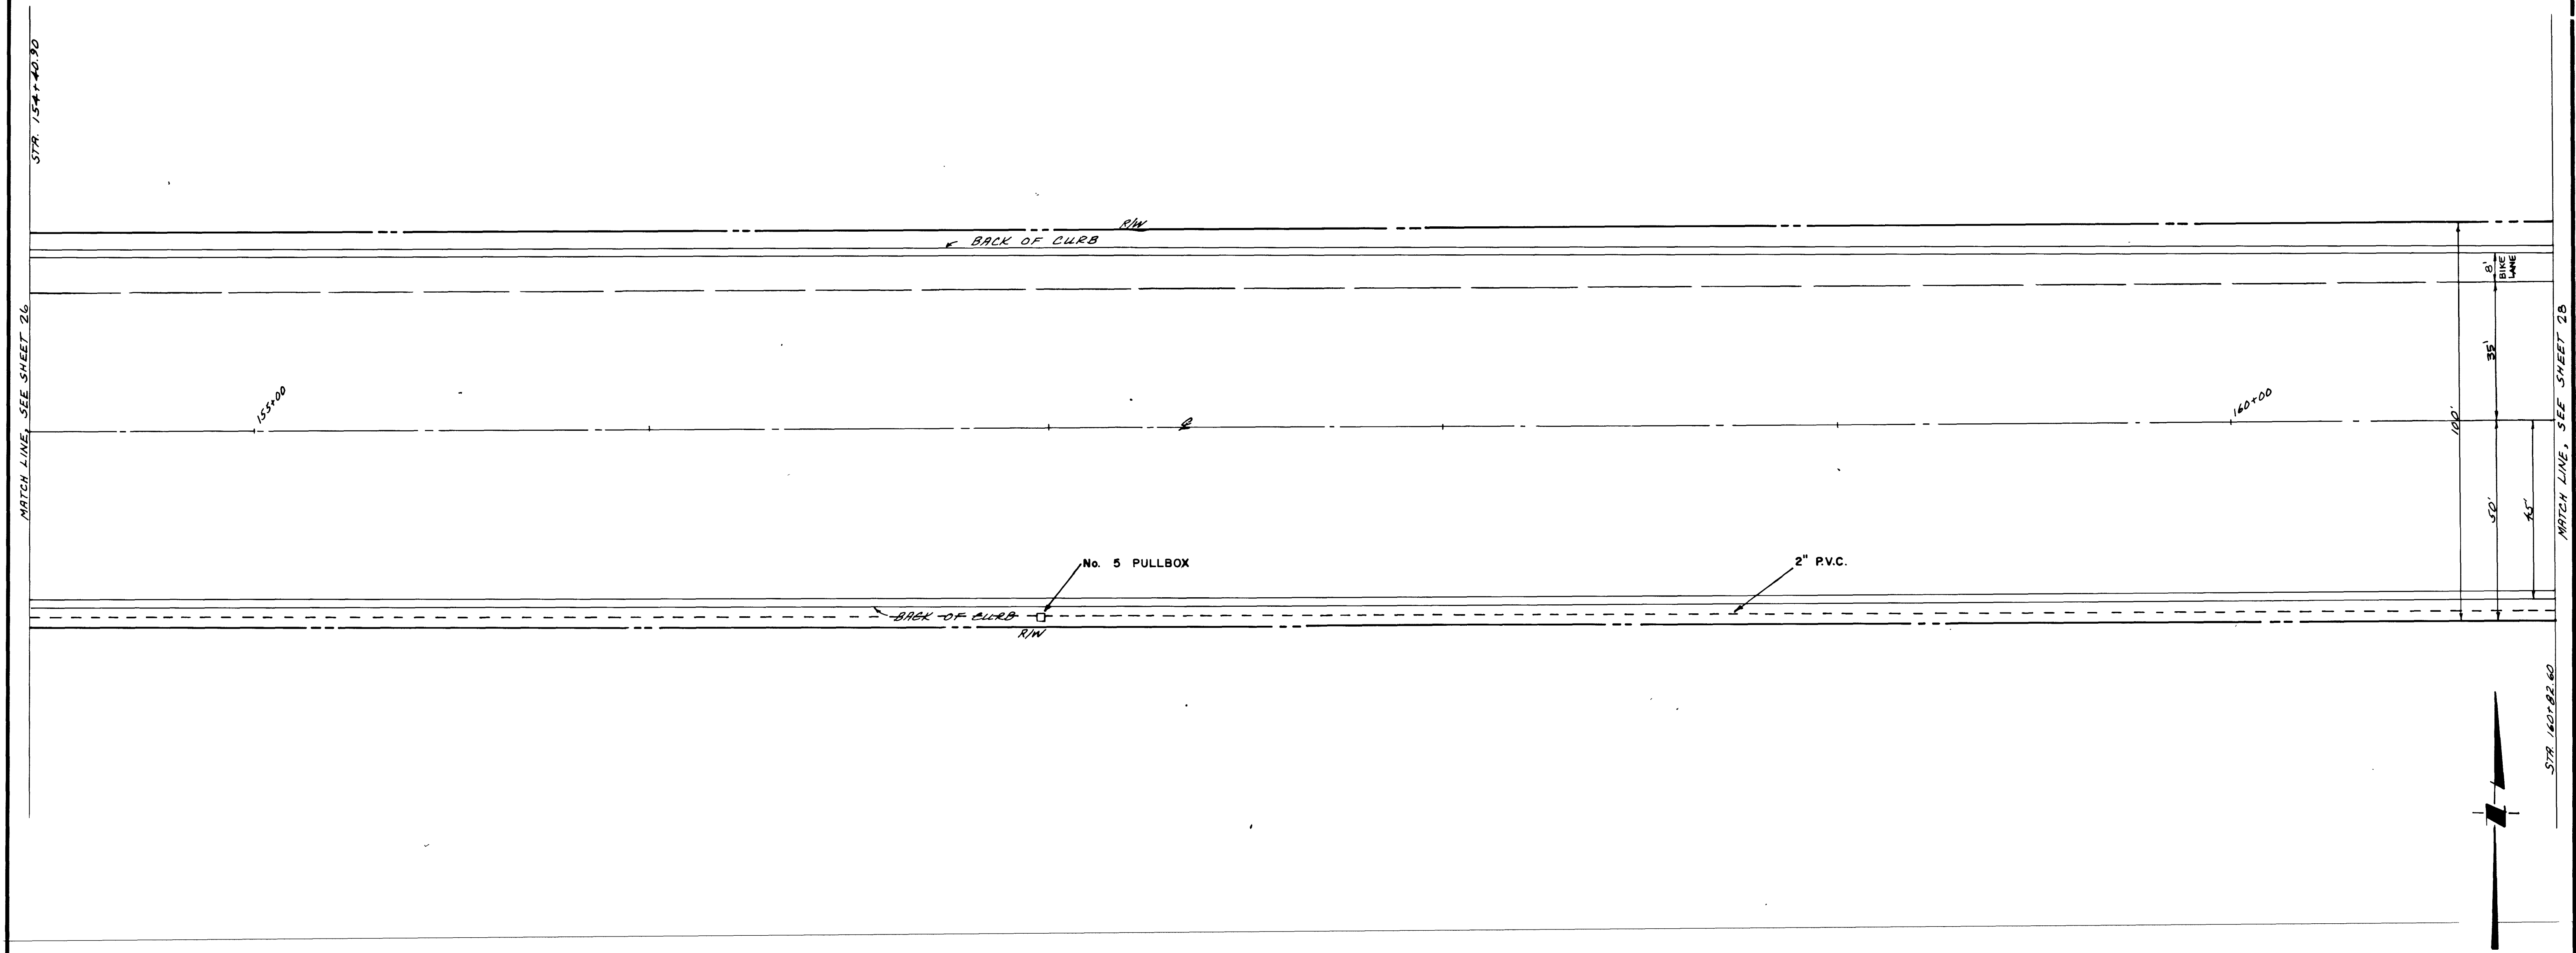

AS BUILT

				SCALE: 1" = 20'	DESIGNED _____		SUBMITTED _____		JAMES M. MONTGOMERY CONSULTING ENGINEERS, INC.  2915 WEST CHARLESTON BLVD., LAS VEGAS, NEVADA 89102	APPROVED _____		CITY OF LAS VEGAS		SHEET 27 OF 37 SHEETS	
					DRAWN <u>K. ROSENTHAL</u>		PROJECT ENGINEER _____ R.C.E. NO. _____ DATE _____			_____ DATE _____		WEST CHARLESTON BLVD.			
					CHECKED _____		RECOMMENDED _____			APPROVED _____		TRAFFIC DELINEATION			
REV DATE BY DESCRIPTION					JAMES M. MONTGOMERY CONSULTING ENGINEERS, INC.		R.C.E. NO. _____ DATE _____			_____ DATE _____		INTERCONNECT AND SIGNING			

107-V1648

12-3-122

10-3-72		CITY OF LOS ANGELES TRAFFIC DEPARTMENT		10-3-72	
		JAMES M. MONTGOMERY CONSULTING ENGINEERS, INC.		10-3-72	
10-3-72		10-3-72		10-3-72	