


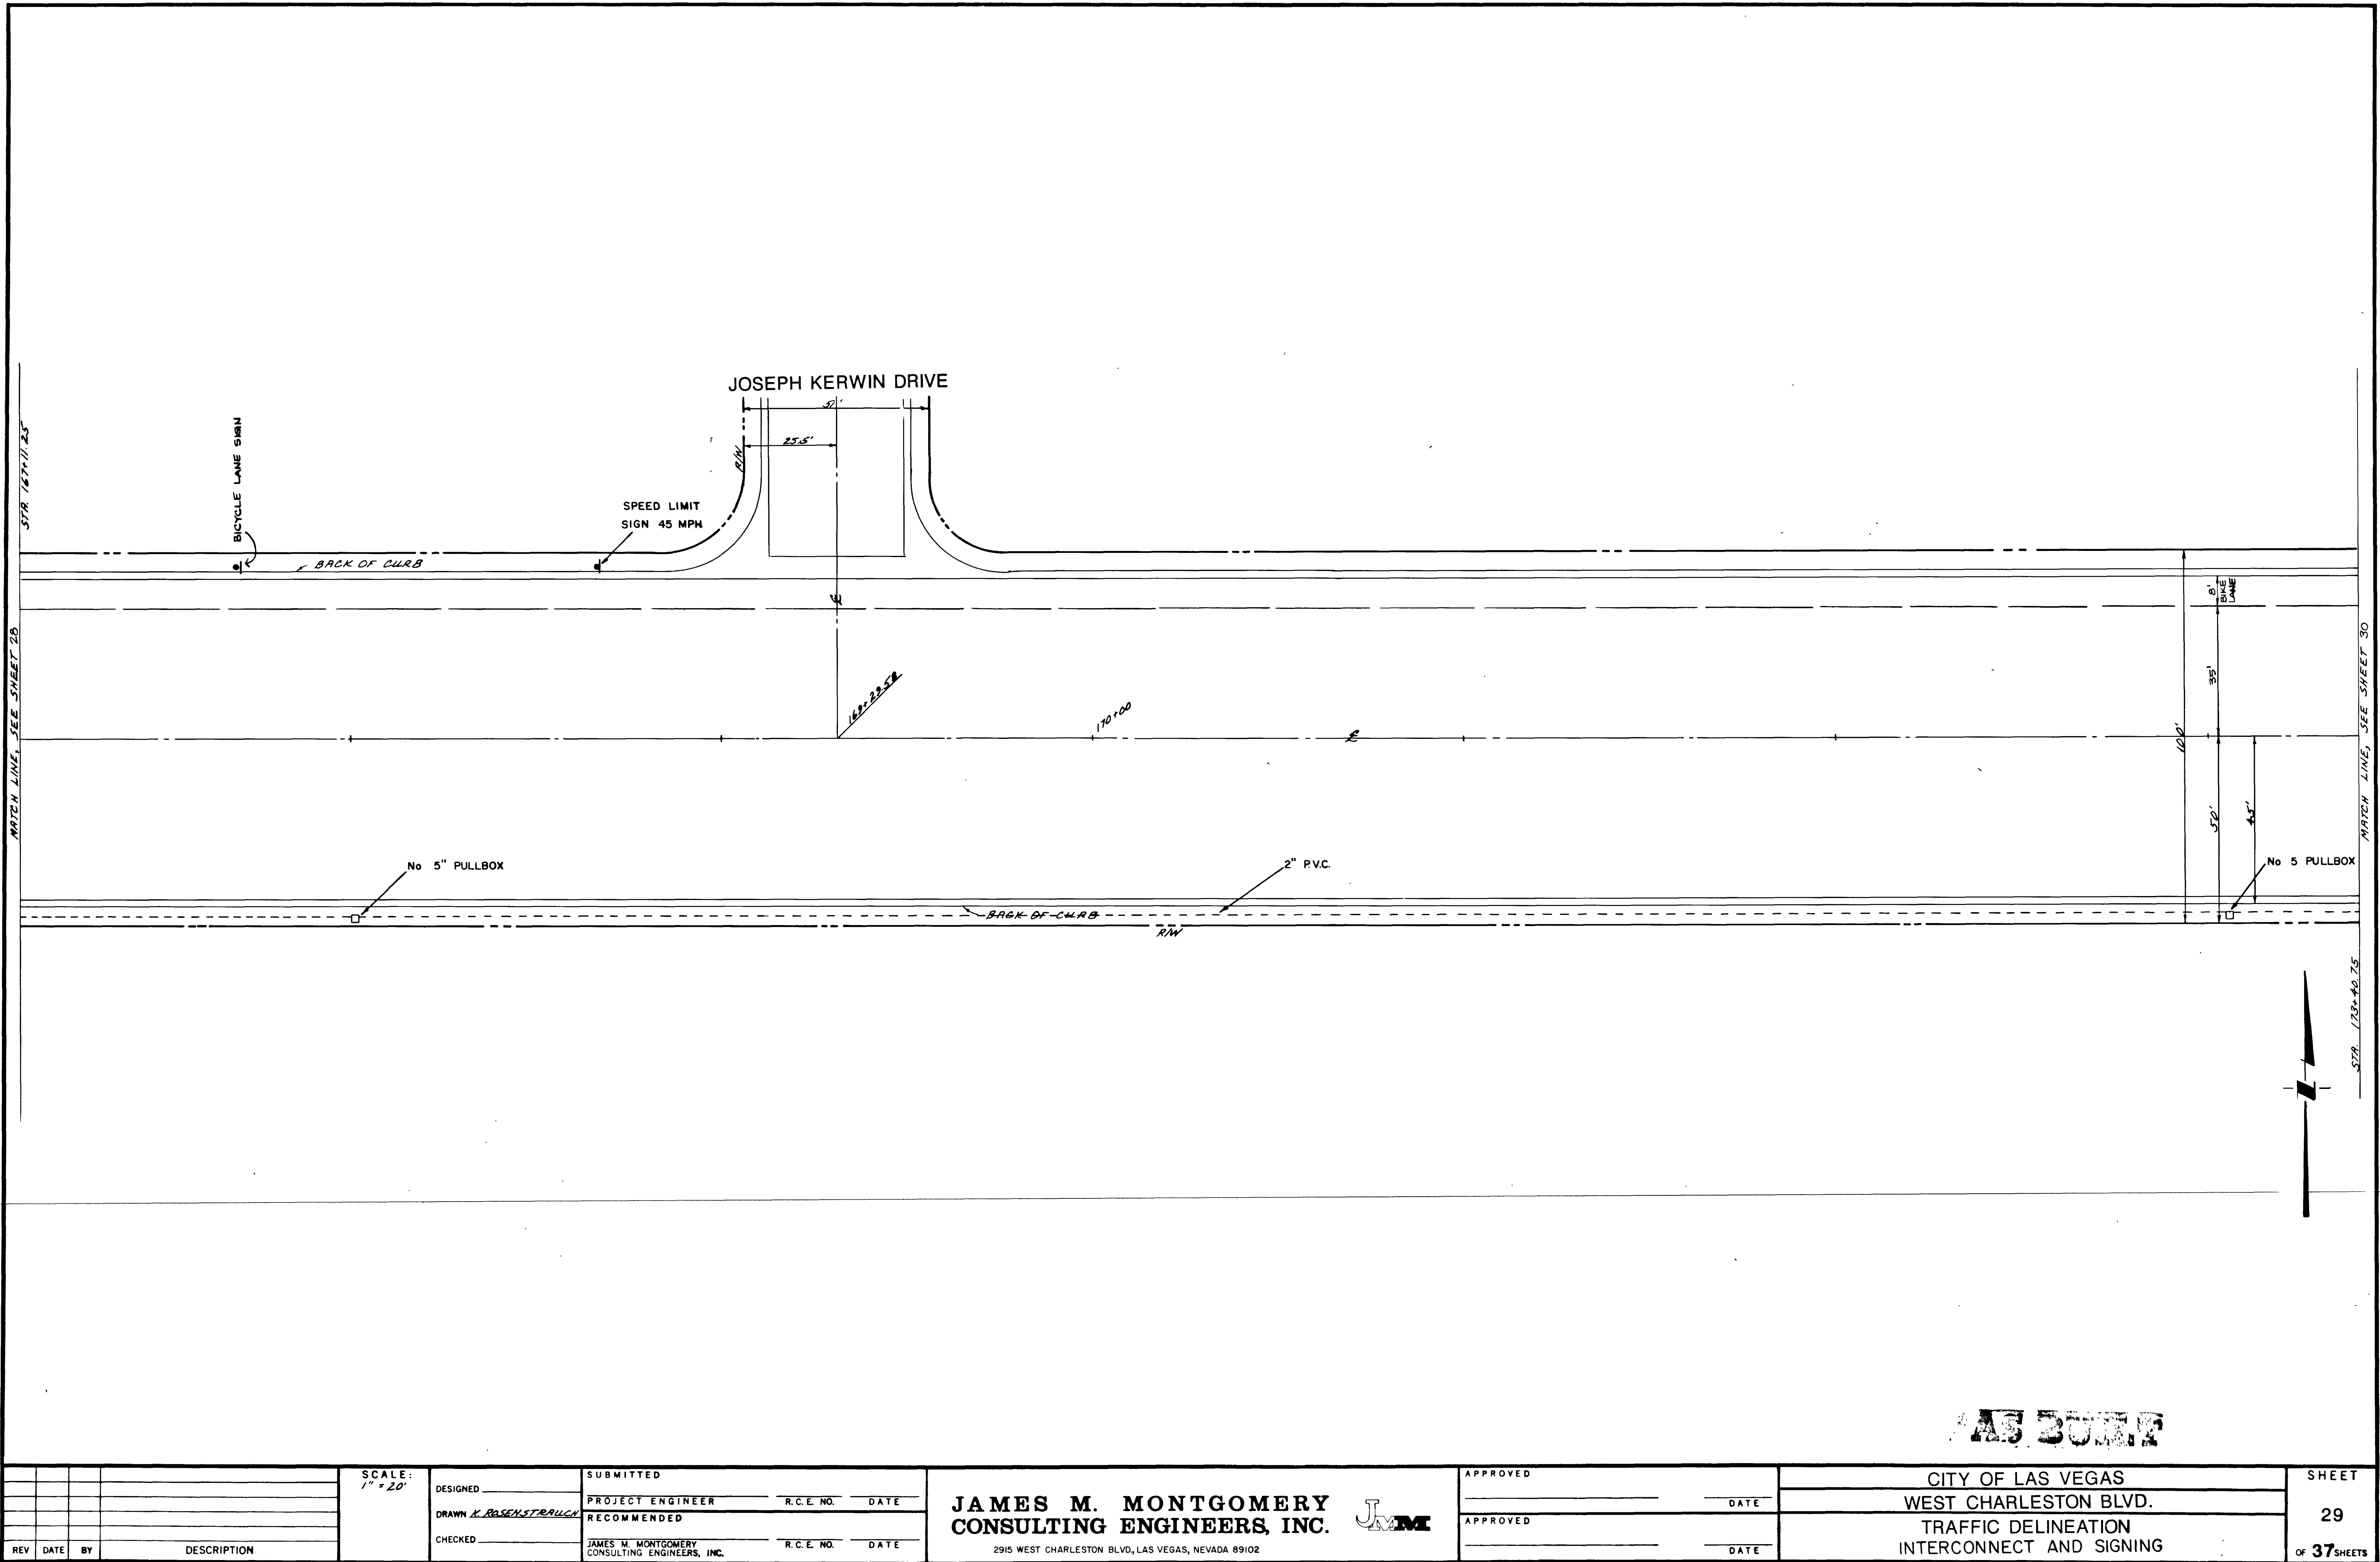

REV		DATE	BY	DESCRIPTION

SCALE: 1" = 20'	DESIGNED DRAWN <i>K. ROSENSTRAUER</i>	CHECKED
--------------------	--	---------

SUBMITTED	
PROJECT ENGINEER	R.C.E. NO. DATE
RECOMMENDED	
JAMES M. MONTGOMERY CONSULTING ENGINEERS, INC.	R.C.E. NO. DATE

APPROVED	
	DATE
APPROVED	
	DATE

CITY OF LAS VEGAS	
WEST CHARLESTON BLVD.	
TRAFFIC DELINEATION INTERCONNECT AND SIGNING	

SHEET
29
OF 37 SHEETS

**JAMES M. MONTGOMERY
CONSULTING ENGINEERS, INC.**


2915 WEST CHARLESTON BLVD., LAS VEGAS, NEVADA 89102

JMM

AS BUILT

JOB NO. 1648-0037 FILE 00

107-V1648
12-3-124

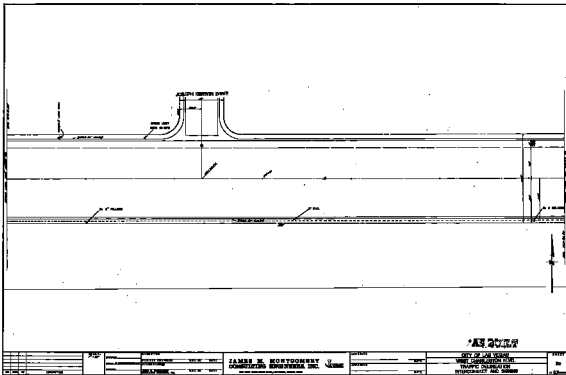

AS BUILT

DATE		12-9-12		BY		12-9-12		CHECKED		12-9-12		APPROVED		12-9-12		DATE		12-9-12		BY		12-9-12		CHECKED		12-9-12		APPROVED		12-9-12	
PROJECT		12-9-12		CONTRACT		12-9-12		DATE		12-9-12		BY		12-9-12		CITY OF SAN JUAN		12-9-12		STREET RECONSTRUCTION PLAN		12-9-12		TRAFFIC CALIBRATION		12-9-12		INTERSECTION AND SIGNAL		12-9-12	
JAMES H. MONTGOMERY		CONSULTING ENGINEERS, INC.		12-9-12		12-9-12		12-9-12		12-9-12		12-9-12		12-9-12		12-9-12		12-9-12		12-9-12		12-9-12		12-9-12		12-9-12		12-9-12		12-9-12	