

DISCLAIMER NOTE:

UTILITY LOCATIONS SHOWN HEREON ARE APPROXIMATE ONLY. IT SHALL BE THE CONTRACTOR'S RESPONSIBILITY TO DETERMINE THE EXACT HORIZONTAL AND VERTICAL LOCATION OF ALL EXISTING UNDERGROUND OR OVERHEAD UTILITIES PRIOR TO COMMENCING CONSTRUCTION. NO REPRESENTATION IS MADE THAT ALL EXISTING UTILITIES ARE SHOWN HEREON. THE ENGINEER ASSUMES NO RESPONSIBILITY FOR UTILITIES NOT SHOWN OR UTILITIES NOT SHOWN IN THEIR PROPER LOCATION. CONTRACTOR TO NOTIFY ENGINEER OF ANY CHANGES OR DISCREPANCIES.

Avoid overhead power line contact. If a costly.

Call before you dig
1-702-227-2929

Nevada Power
Environment and Safety
Services Department

Call before you dig
1-800-227-2600

CLARK COUNTY PUBLIC OPERATIONS
1-702-455-7544

BENCHMARK

CITY OF LAS VEGAS BENCHMARK GLV99 13W6

RIVET & PLATE TOP CURB NE CORNER SHAUMBER ROAD (LANSFORD ST.) AND FARM ROAD.

ELEVATION=915.085 METERS
ELEVATION=3002.24 U.S. SURVEY FEET
NAVD83 CITY OF LAS VEGAS 2009 VERTICAL ADJUSTMENT

BASIS OF BEARINGS

NORTH 88°47'20" EAST BEING THE BEARING OF THE NORTH LINE OF THE NORTHEAST QUARTER (NE 1/4) OF THE NORTHWEST QUARTER (NW 1/4) OF SECTION 12, TOWNSHIP 21 SOUTH, RANGE 60 EAST, W.D.M., CLARK COUNTY, NEVADA, AS SHOWN ON THAT CERTAIN MAP ON FILE IN THE CLARK COUNTY RECORDER'S OFFICE IN FILE 27 OF PARCEL MAPS, AT PAGE 94.

STREETLIGHT AND SVZ NOTE

REFER TO SHEET S-3 FOR PUBLIC STREETLIGHT CIRCUIT CAPACITY VERIFICATION TABLES AND SVZ LINE AND CURVE TABLES.

TRAFFIC CONSTRUCTION NOTES

SIGNS



- 1 - INSTALL 1-36" R1-1 STOP SIGN AND 2-12" STREET NAME SIGNS (PRIVATE STREET SIGNS WITH "PRIVATELY MAINTAINED" TO BE WHITE LETTERS ON BROWN BACKGROUND)
- 2 - INSTALL 1-30" R1-1 STOP SIGN AND 2-9" STREET NAME SIGNS (PRIVATE STREET SIGNS WITH "PRIVATELY MAINTAINED" TO BE WHITE LETTERS ON BROWN BACKGROUND)
- 3 - INSTALL R2-1 SPEED LIMITS SIGN POSTED "SPEED LIMIT 25"
- 4 - INSTALL W1-1 LEFT TURN SIGN

STREETLIGHTS

- 50 - INSTALL 100 HPS STREET LIGHT PER CLIFF'S EDGE DESIGN GUIDELINES SECTION 5 DETAIL 5-16 AND 5-17
- 51 - INSTALL 150 HPS STREET LIGHT PER CCAUSD No. 314, 320, AND 321
- 52 - INSTALL PRIVATE 125 AMP WALL MOUNTED SERVICE PEDESTAL
- 53 - INSTALL 1-1/4" PVC STREETLIGHT CONDUIT WITH 2-NO. 4 AND 1-NO. 8 GND THW
- 54 - INSTALL No. 3 1/2 PULL BOX PER CCAUSD No. 326
- 55 - REMOVE CAP AND CONNECT TO EXISTING 1 1/4" PVC STREETLIGHT CONDUIT. INSTALL 2-NO. 4 AND 8 GND THW IN EXISTING STREETLIGHT CONDUIT.



PAVEMENT MARKINGS AND MISCELLANEOUS

- 60 - INSTALL BLUE COLORED REFLECTIVE RAISED PAVEMENT MARKERS ADJACENT TO THE FIRE HYDRANT ON ALL IMPROVED FIRE APPARATUS ACCESS ROADWAYS WITH HARD SURFACE, INCLUDING BOTH PUBLIC AND PRIVATE ROADS, OR FIRE LANES
- 61 - PAINT CURB RED IN FRONT OF FIRE HYDRANT
- 62 - PAINT CURB RED IN FRONT OF FIRE DEPT EMERGENCY ACCESS

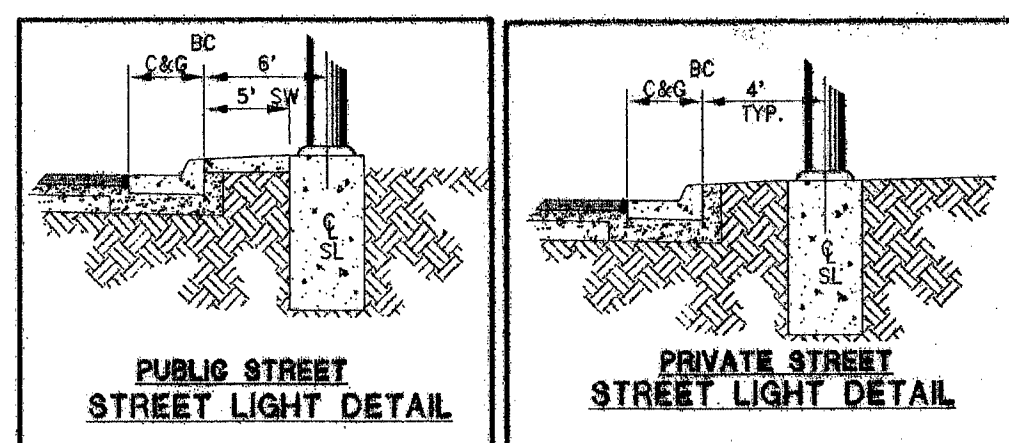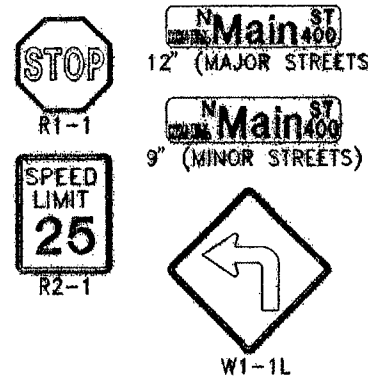

ASBUILT

WESTERN STATES CONTRACTING, INC.
4129 W. CHEYENNE AVE. SUITE B
N. LAS VEGAS, NV 89032

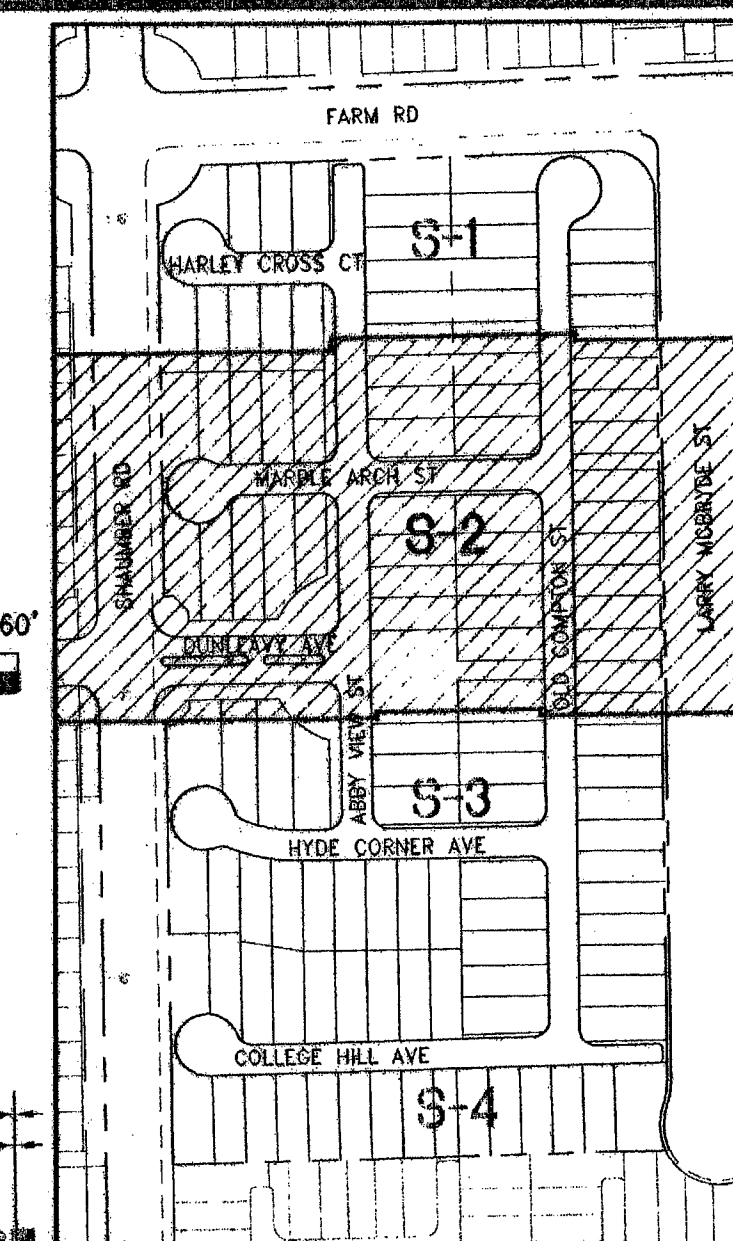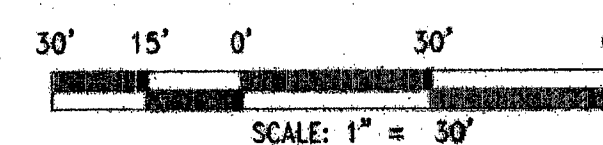

DATE: 03/28/2013
HORIZ. SCALE: 1"=30'
VERT. SCALE: 1"=5'
DRAWN BY: CR
DESIGNED BY: CR
CHECKED BY: CR
APPROVED BY: CR
PROJECT #: 3040.0032


LENNAR
2400 ASSESSOR VERDE PARKWAY SUITE 130 HENDERSON, NV 89074
PHONE: (702) 796-6100 FAX: (702) 796-9300
RCI Engineering
3281 South Highland Drive, Suite B10, Las Vegas, NV 89109
PH: 702.453.0800 FAX: 702.453.0801

IMPROVEMENT PLANS FOR
WEST END (AKA FARM AND SHAUMBER)
CLIFFS EDGE POD 208
STREET LIGHT, SIGNAGE AND STRIPING PLAN
(SHEET 2 OF 4)

CITY OF LAS VEGAS
SCHOOL BOARD OF TRUSTEES
APN #128-13-301-018

10-29-13
DRAWING
S-2
SHT 38 OF 40
CLV DRAWING NUMBER
H 45096
10744985

CLV PROJECT NUMBER 50965

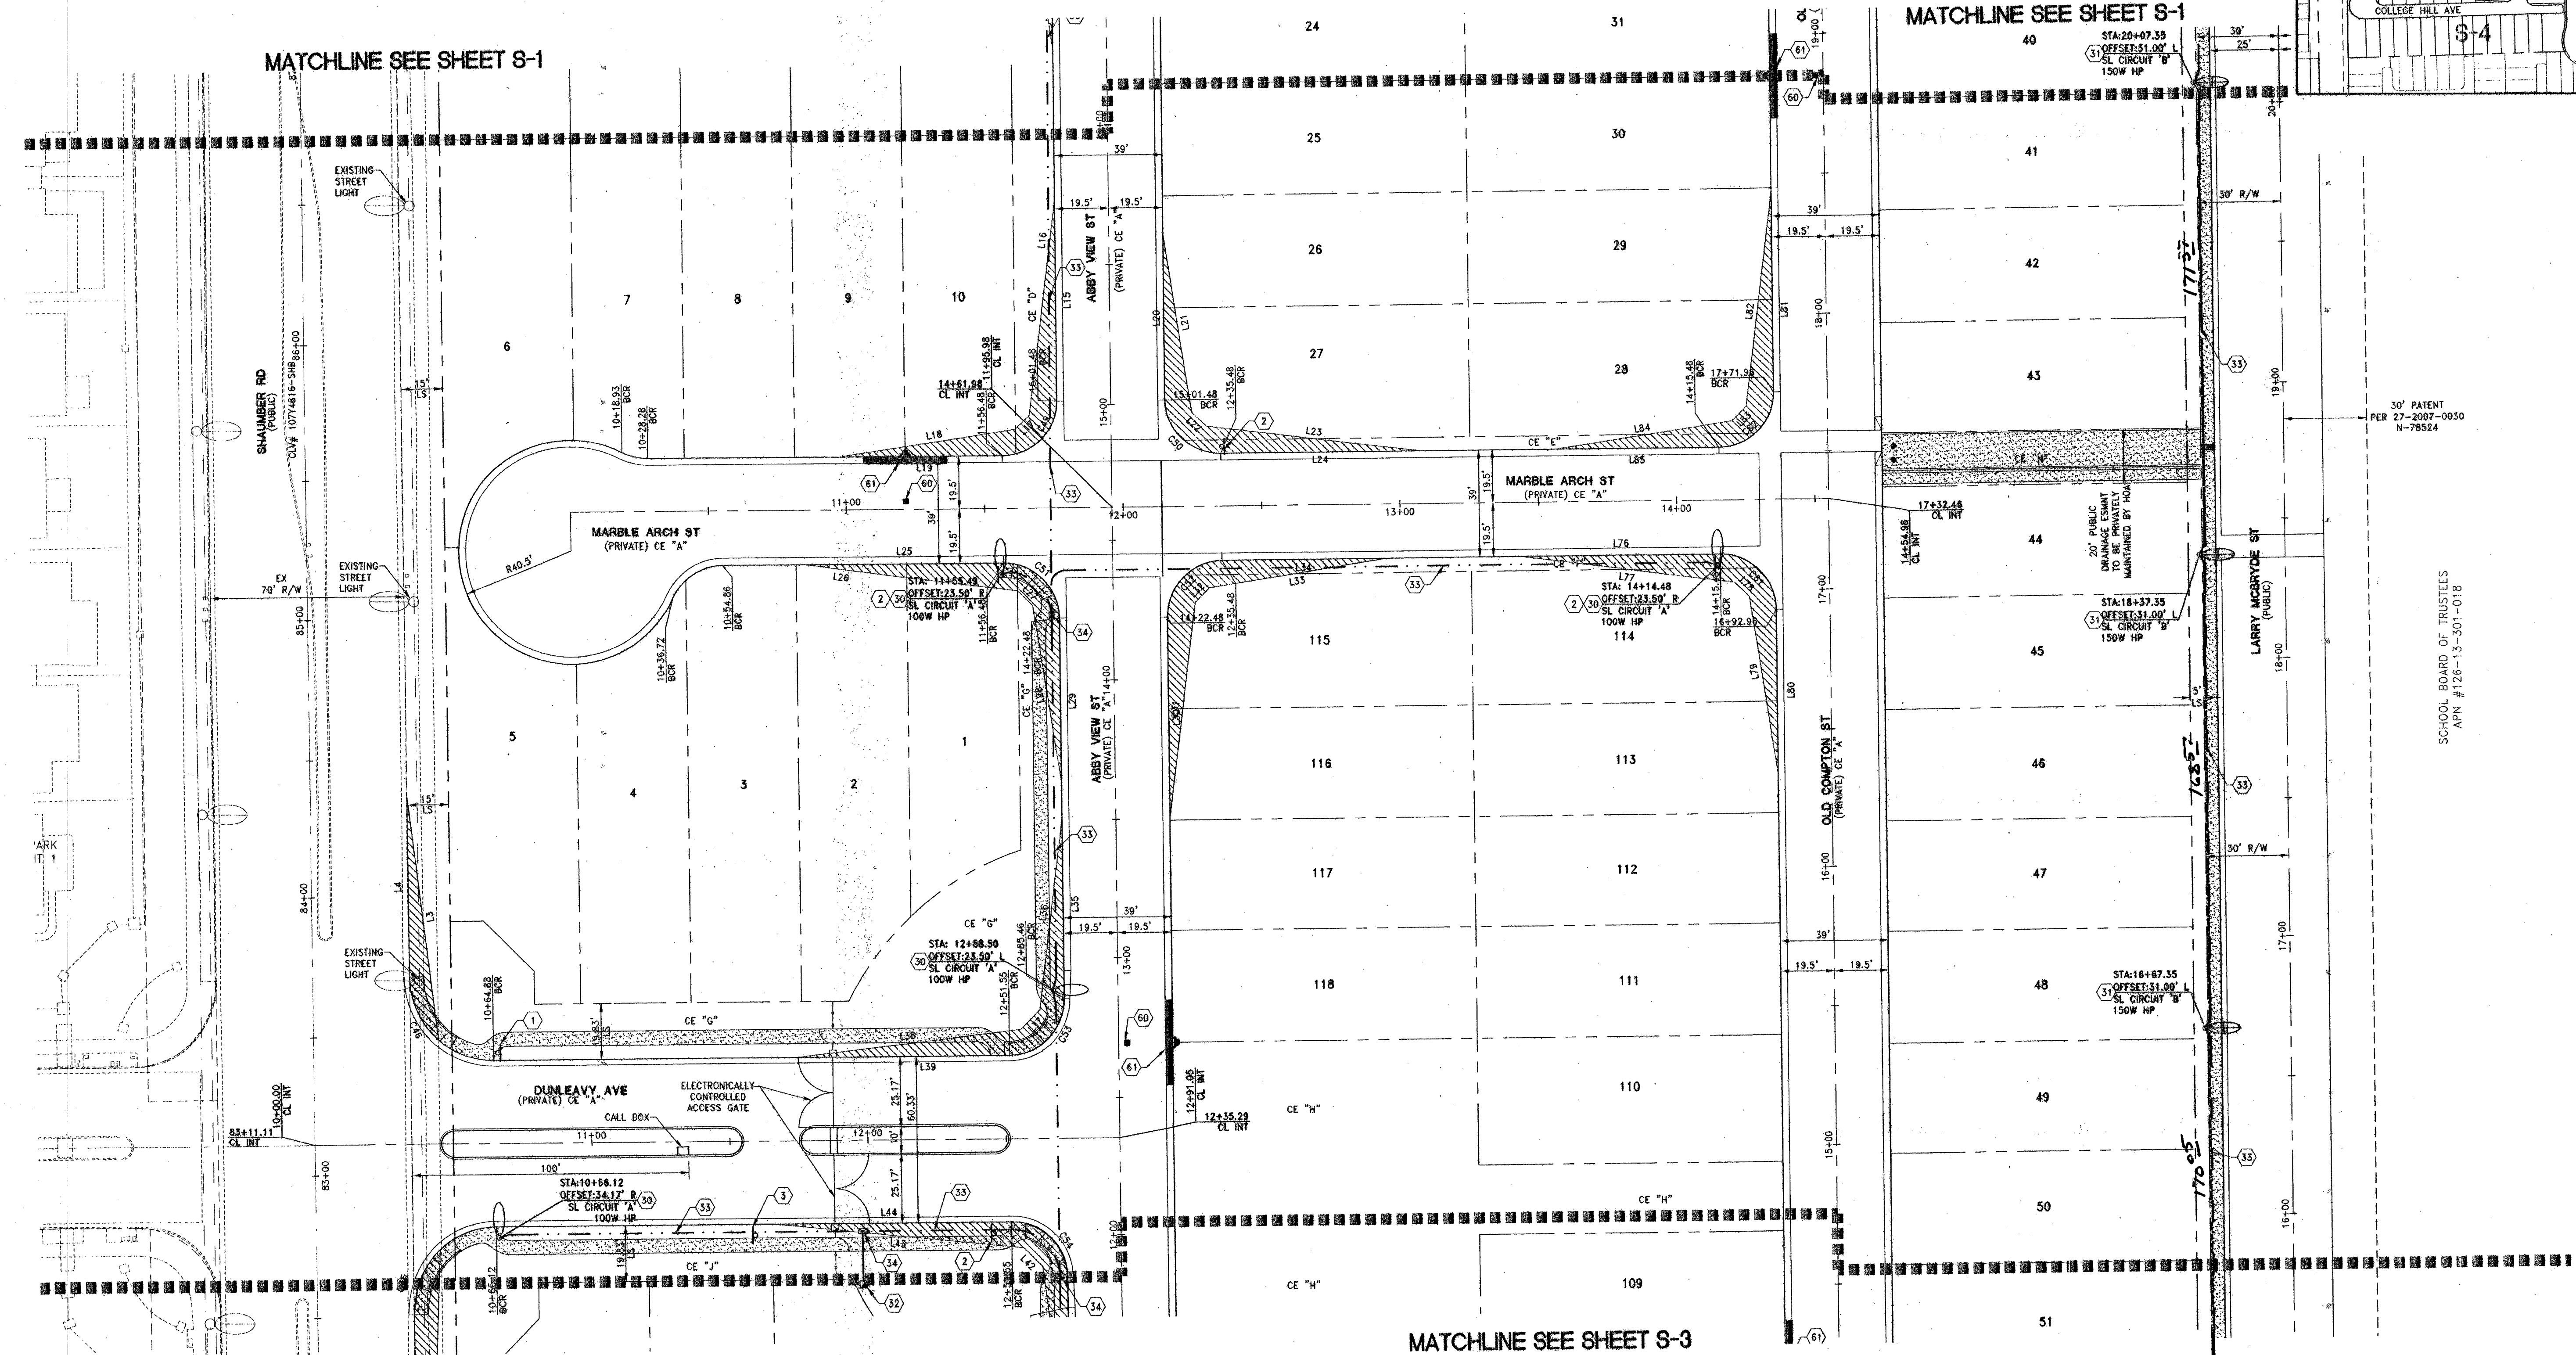

MATCHLINE SEE SHEET S-3

MATCHLINE SEE SHEET S-3

MATCHLINE SEE SHEET S-1

ASBUILT