



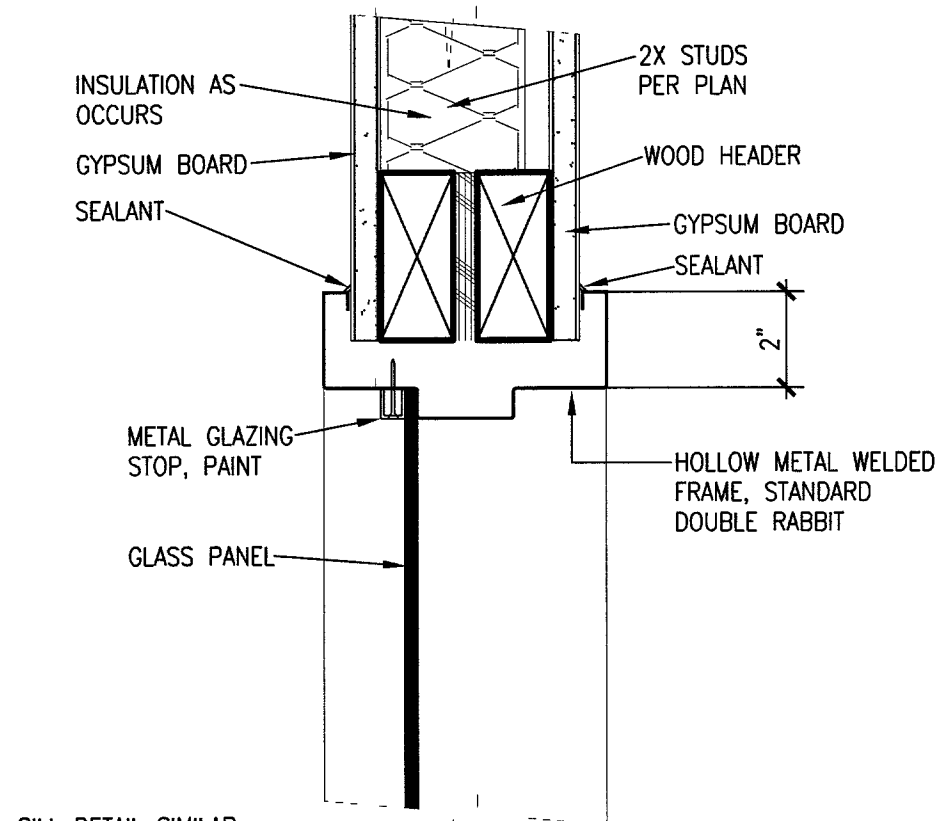

SILL DETAIL SIMILAR
INTERIOR WINDOW HEAD
SCALE: 3" = 1'-0"

0509-WN01

10

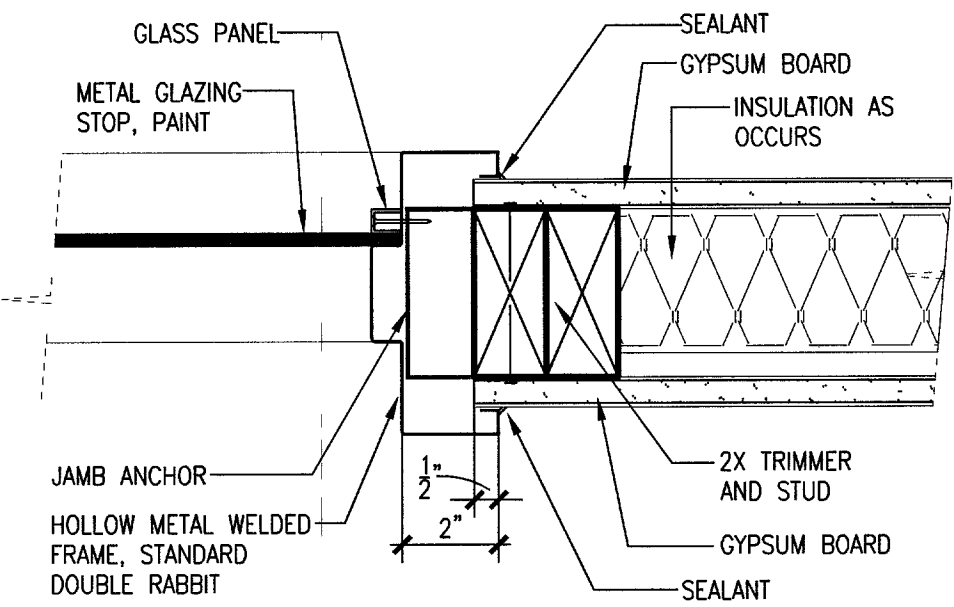

INTERIOR WINDOW JAMB
SCALE: 3" = 1'-0"

0509-DR03

9


RECORD DRAWING

THIS RECORD DRAWING, DATED September 14, 2006, HAS BEEN PREPARED BASED UPON INFORMATION FURNISHED BY THE CONTRACTOR ON THEIR AS-BUILT DRAWINGS. RECORD DRAWING REVISIONS ARE CLOUDED, AND NOTED WITH A DELTA "Δ".

WHILE THIS INFORMATION IS BELIEVED TO BE RELIABLE, THOSE RELYING ON THIS RECORD DOCUMENT ARE ADVISED TO OBTAIN AN INDEPENDENT VERIFICATION OF THE ACCURACY BEFORE APPLYING IT TO ANY PURPOSE.

THIS RECORD DRAWING DOES NOT REPRESENT THAT THE BUILDING HAS BEEN CONSTRUCTED AS SHOWN OR THAT THIS DOCUMENT IS AN 'AS-BUILT'. THE PREPARER OF THIS DOCUMENT DID NOT INSPECT THE CONSTRUCTION OF THE BUILDING BY THE GENERAL CONTRACTOR.


ARCHITECTURAL RECORD DRAWINGS PREPARED BY:
HCA INC.

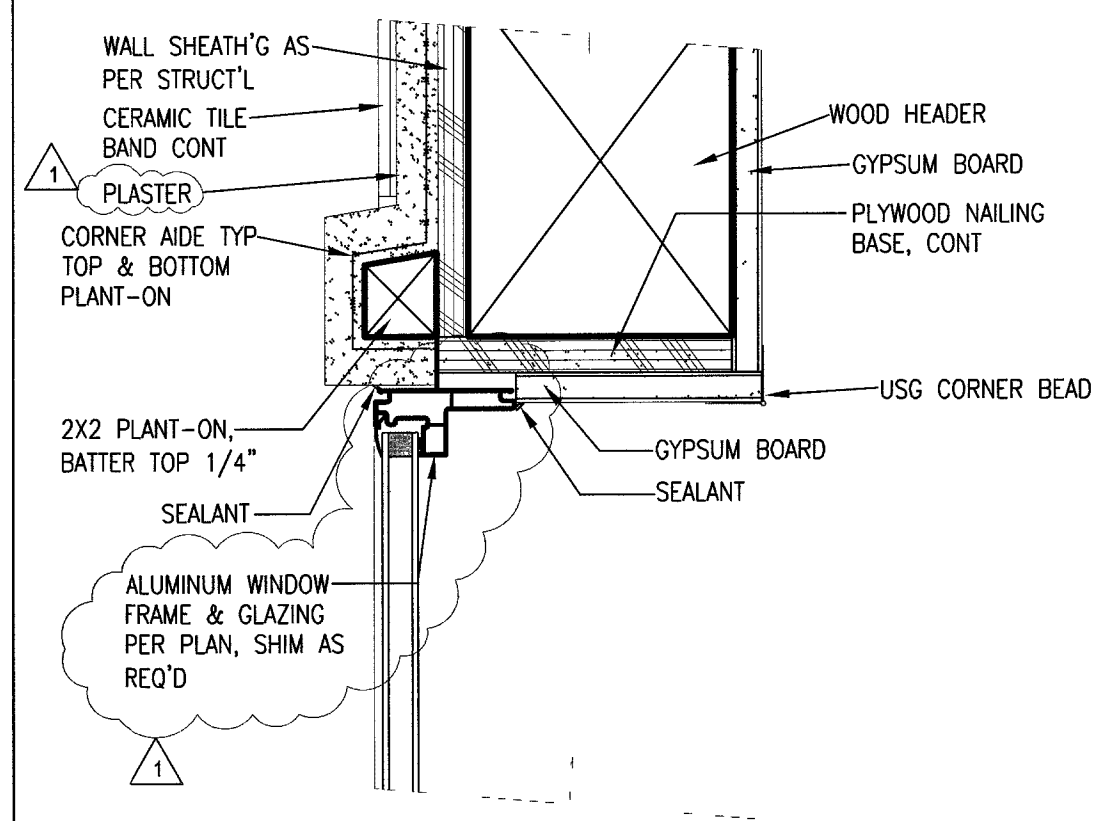

EXTERIOR WINDOW HEAD
SCALE: 3" = 1'-0"

0509-WN03


8

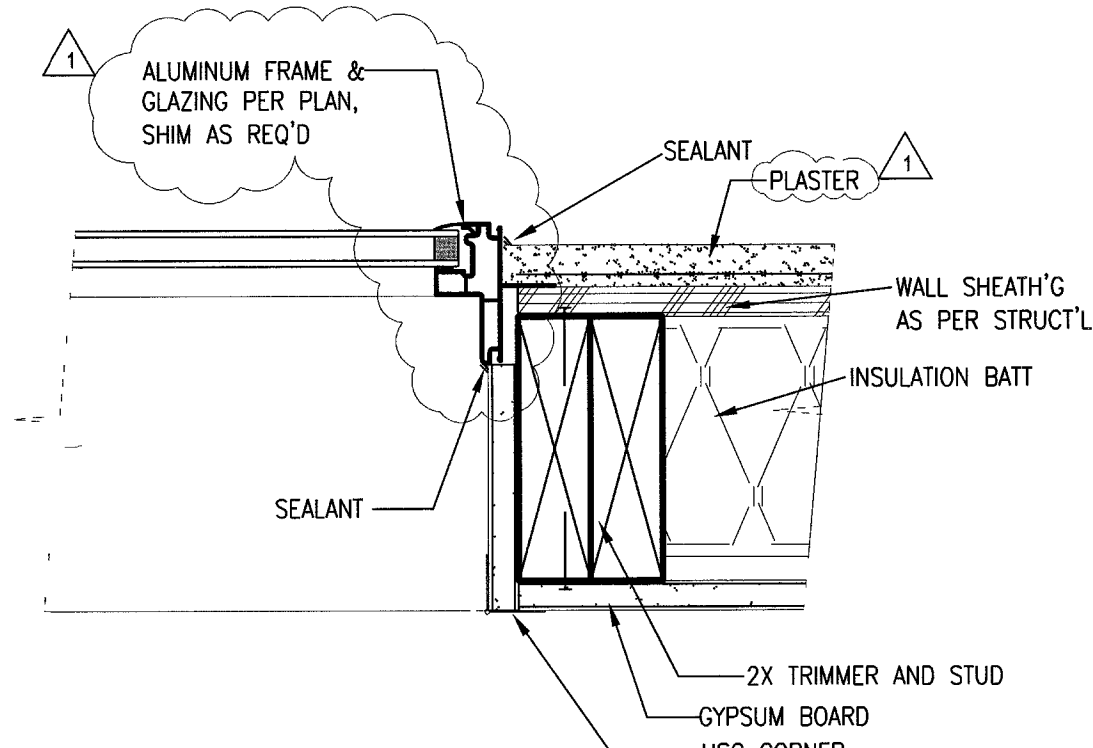

EXTERIOR WINDOW JAMB
SCALE: 3" = 1'-0"

0509-WN05


7

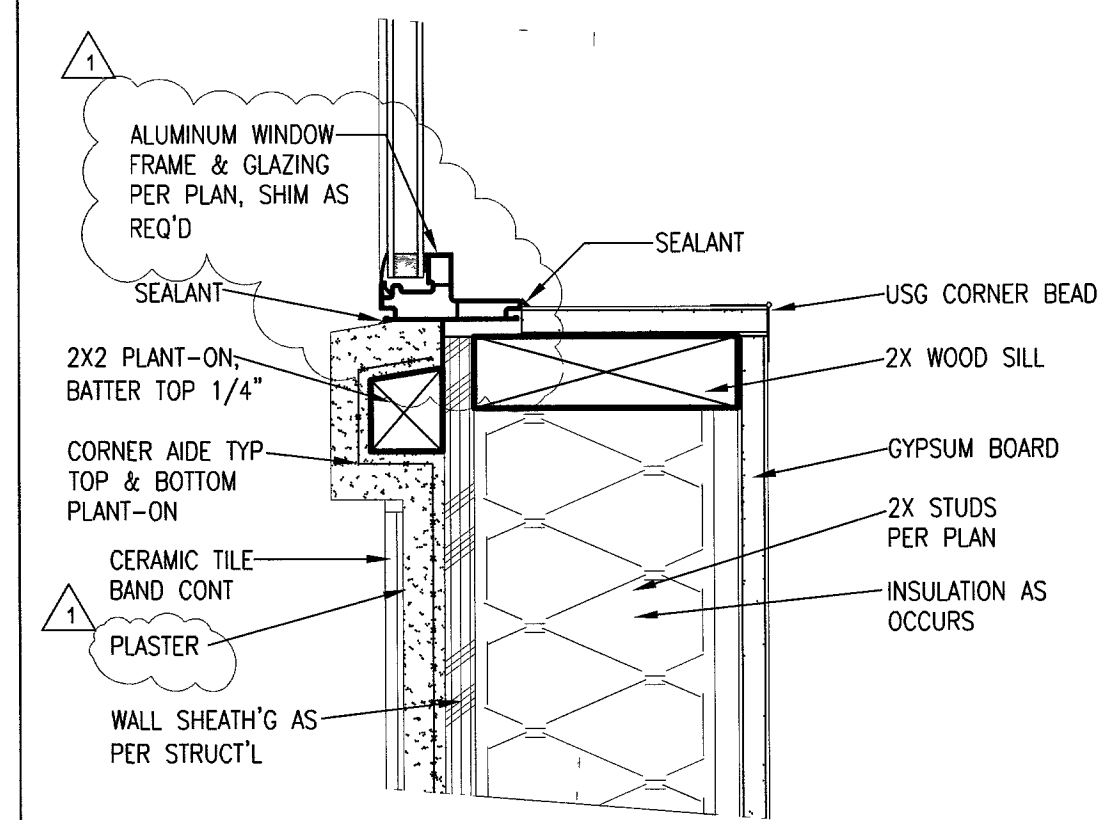

EXTERIOR WINDOW SILL
SCALE: 3" = 1'-0"

0509-WN04


6

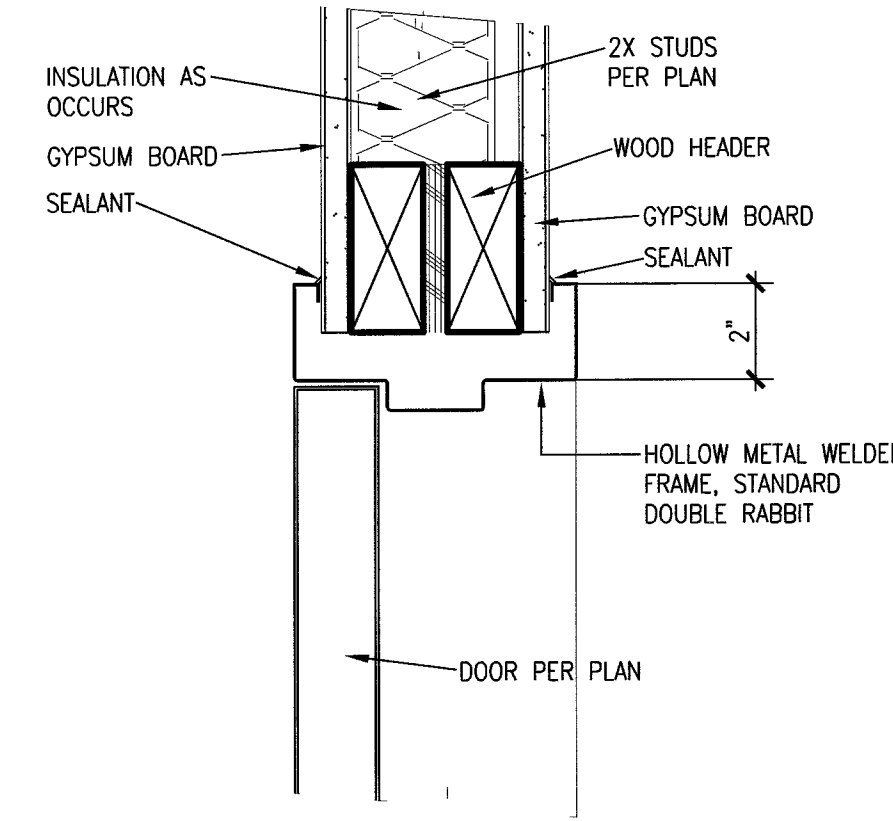

INTERIOR DOOR HEAD
SCALE: 3" = 1'-0"

0509-DR03


5

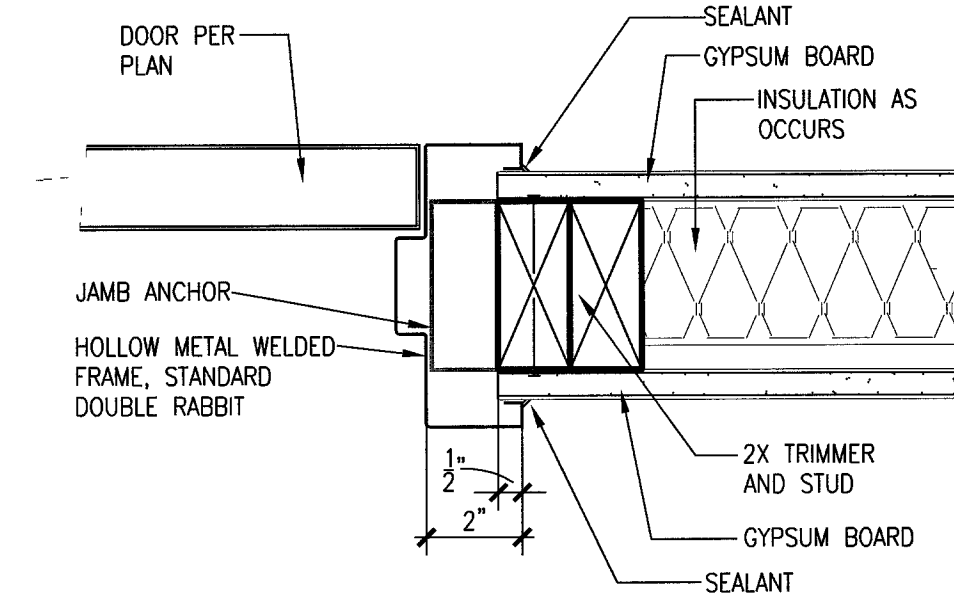

INTERIOR DOOR JAMB
SCALE: 3" = 1'-0"

0509-DR03


4

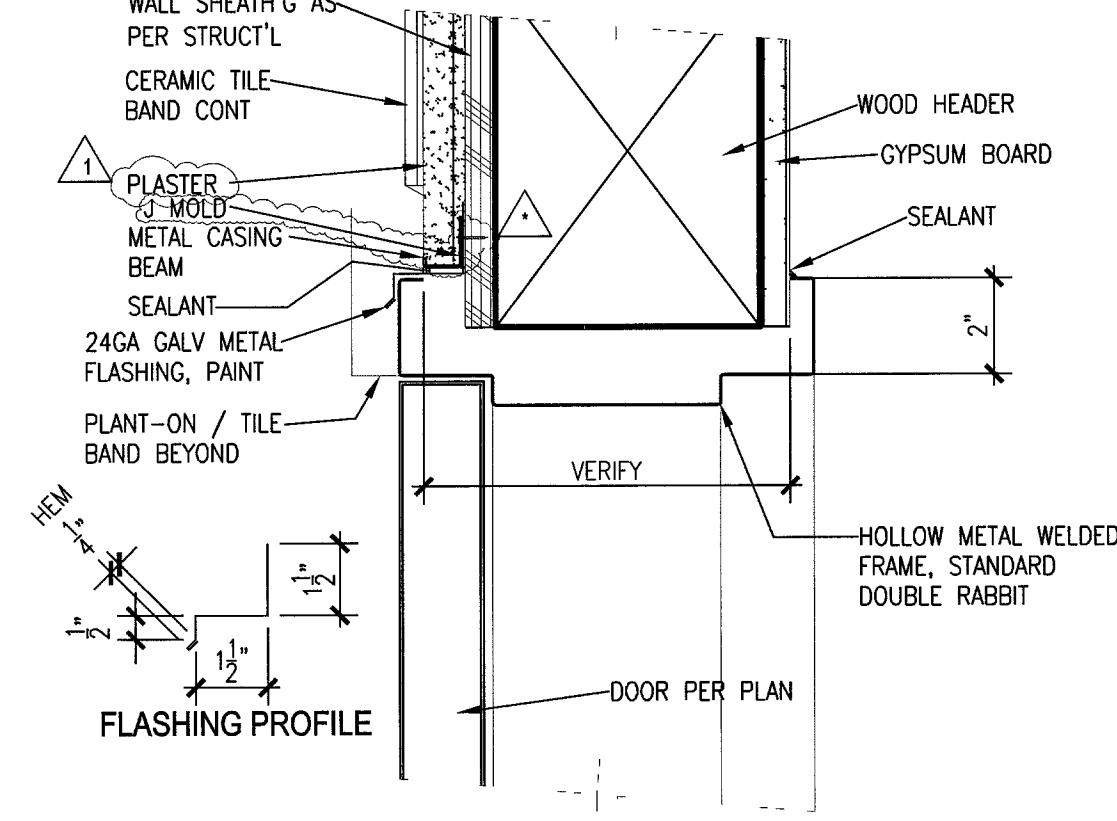

EXTERIOR DOOR HEAD
SCALE: 3" = 1'-0"

0509-DR01


3

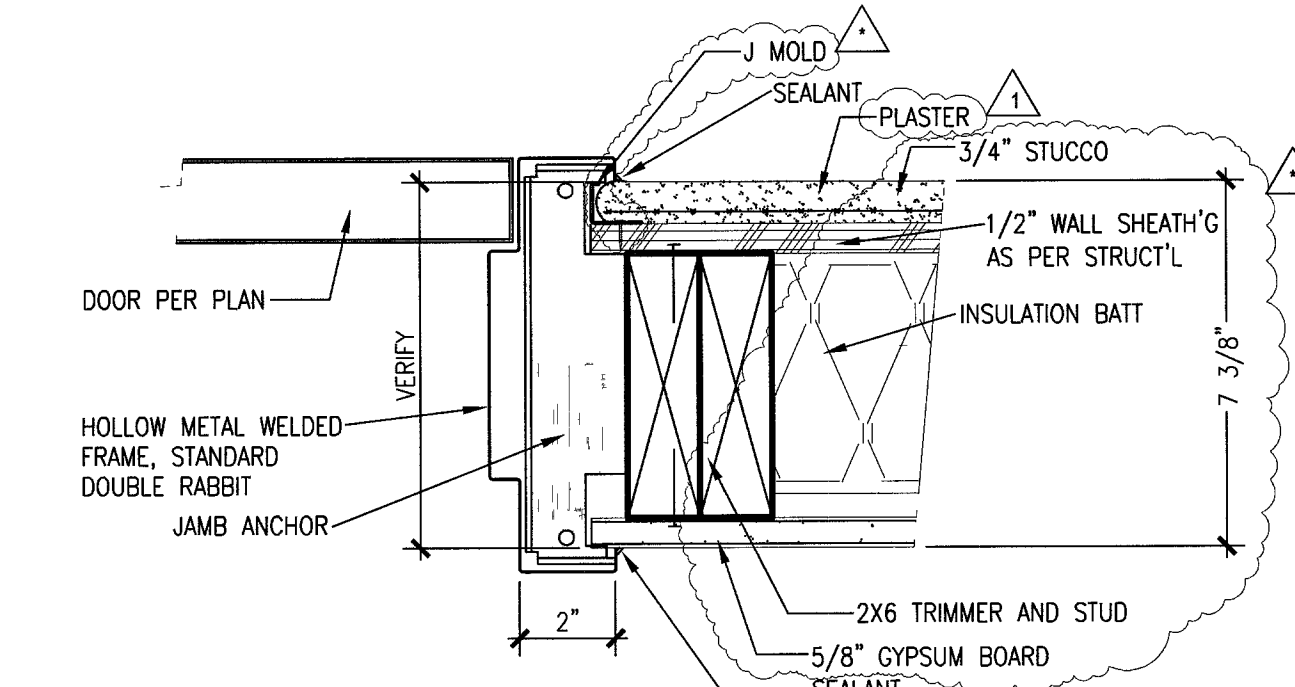

EXTERIOR DOOR JAMB
SCALE: 3" = 1'-0"

0509-DR02

2

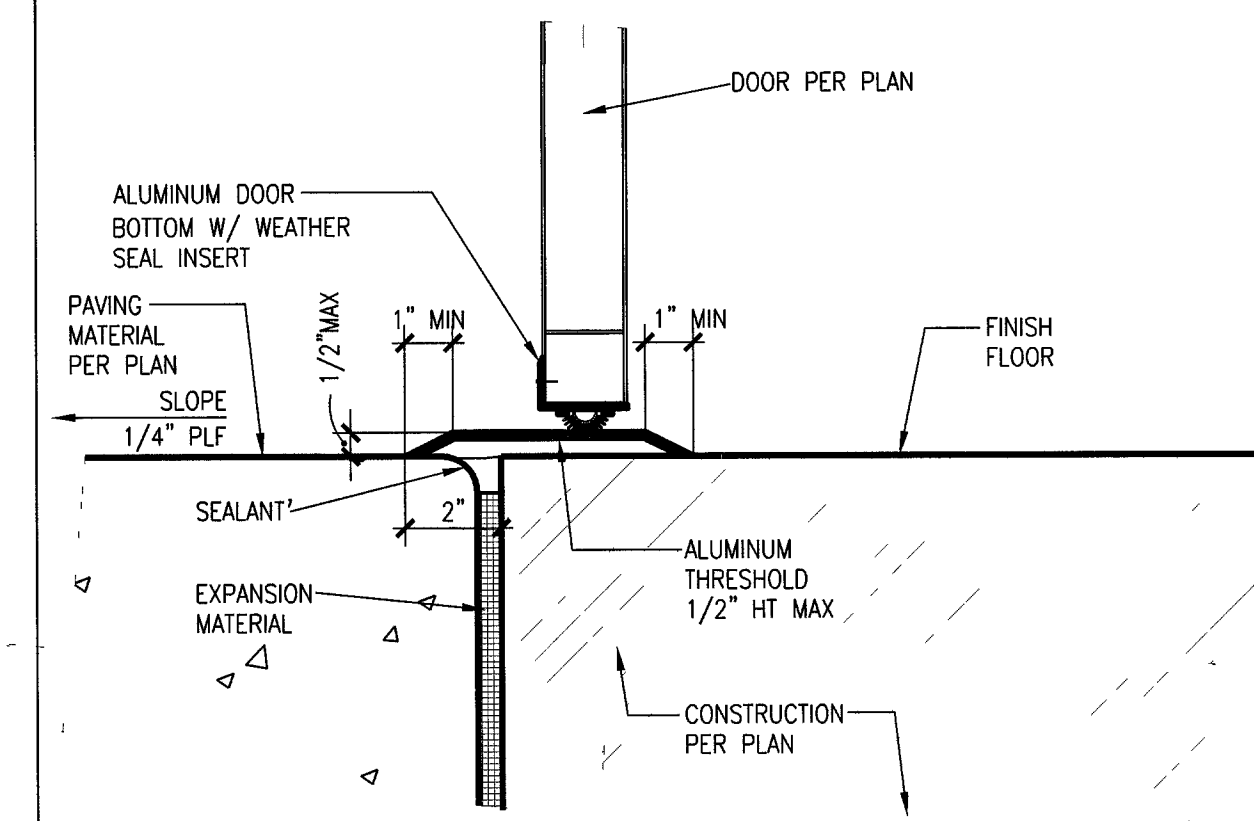

ACCESSIBLE DOOR THRESHOLD
SCALE: 3" = 1'-0"

0509-DR05

1

REVISIONS	CLV/PERMIT	COORD.	DATE
Δ	AS-BUILT INFO		09/14/06
Δ	CLV/PERMIT		07/29/05
CONSULTANT			
ARCHITECTS 2121 East Tropicana Ave., Suite 2 Las Vegas, NV 89119 (702) 331-0266			

WEST SERVICE CENTER
BUILDING & SAFETY INSPECTION EXPANSION
CITY OF LAS VEGAS

DOOR, & WINDOW DETAILS

STAMP	
OWNER: CITY OF LAS VEGAS DEPARTMENT OF PUBLIC WORKS ARCHITECTURAL SERVICES	
400 EAST STEWART AVENUE LAS VEGAS, NEVADA 89103 PHONE: (702) 229-5533 FAX: (702) 386-9108 TDD: (702) 386-9108	
DESIGN	GDF
FILE	A6.11
DATE	8/24/05
SCALE	AS NOTED
BID NO	05.15341.05
CLV DWG NO	522-V52-1
	2004026.00
SHT NO	30/31
	A6.11

REVISED 8/27/03

REVISED 8/27/03