



ROOF FRAMING PLAN

- COLOR CODE: RED.
- SEE SHEET J2 FOR FRAMING SECTIONS.
- JOIST CHORDS ARE TYPICALLY NOT DESIGNED FOR CONCENTRATED LOADS BETWEEN PANEL POINTS. IF POINT LOADS ARE NOT SPECIFICALLY DIMENSIONED ON THE PLAN, THEN PLACE THE LOADS AT PANEL POINTS OR FIELD WELD AN EXTRA MEMBER FROM POINT LOAD TO NEAREST PANEL POINT ON OPPOSITE CHORD AT NO EXPENSE TO JOIST SUPPLIER. SEE DETAIL 'AA' ON SHEET J2.
- HORIZONTAL BRIDGING TO BE: L1.1/2 x 1.1/2 x 7/64 MARK-A SHIPPED IN 20'-0" LENGTHS AND FIELD CUT AS REQD. ROWS OF BRIDGING INDICATED THUS (-----).
- CONTRACTOR NOTE & COORDINATE: JOIST SUPPORTING MECHANICAL UNITS ARE DESIGNED WITH ADLOAD CAPACITY SHOWN. PLACE MECHANICAL UNITS ONLY ON JOIST WITH ADLOADS. NOTE 3 IS APPLICABLE.

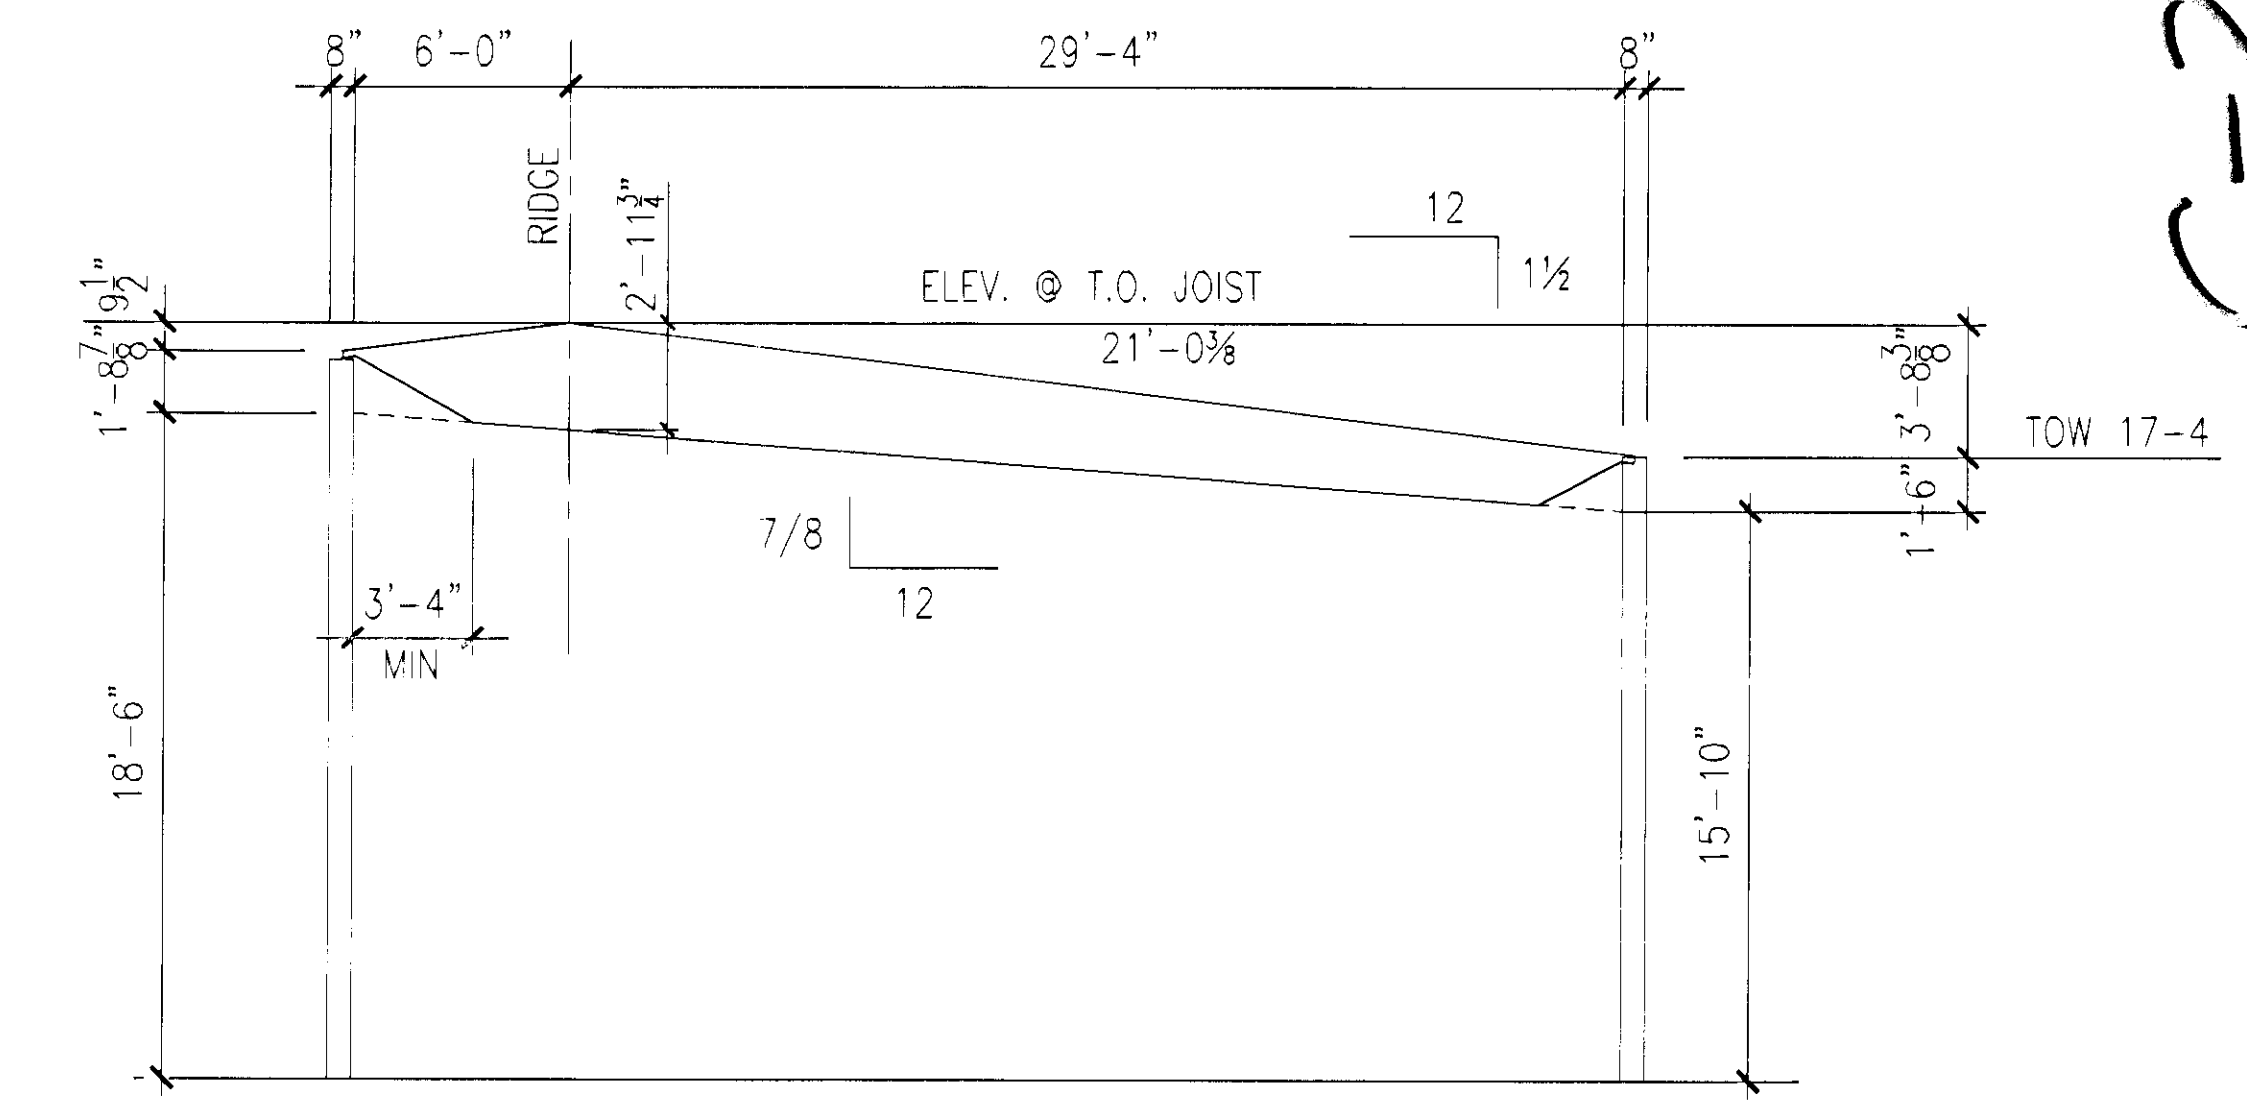

SECTION XX

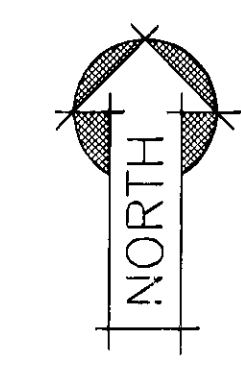

ERECTOR NOTE
PLACE JOIST WITH TAGGED END IN THE SOUTH DIRECTION UNLESS NOTED BY ⊕ ON PLAN.

POGGEMEYER DESIGN GROUP
SUBMITTAL REVIEW
PDG Project Name: 1099 H
The submittal has been reviewed only for performance with the project design concept and compliance with the contract documents. No review of construction means or methods is intended, including formwork, shoring, temporary bracing or additional reinforcement for construction unless specifically included in the contract documents. All dimensions, quantities, and field conditions are to be verified by the contractor.
 Reviewed, No Exceptions Noted
 Reviewed, Comply With Notes, Exceptions & Shop Plans
 Reviewed, Comply With Notes, Exceptions, Revise and Resubmit
 Reviewed, Rejected, New Submittal Required
Reviewed by: M92
For Poggemeyer Design Group
Date: 9-24-03 Log Item # 05210-032,2

FINAL PLANS FOR FIELD USE
BACKCHARGES WILL NOT BE HONORED WITHOUT AUTHORIZATION BY STEEL ENCOUNTERERS, INC.

UJB
9/30/03

RECEIVED
SEP 25 2003
CITY OF LAS VEGAS PERMITS

RECEIVED
SEP 22 2003
TARGET GENERAL INC. OF NV

573266

JOIST QUANTITIES:		2	04-25-03	FP	PER RESUBMITAL / REL FOR FAB	
GIRDER	0	1	03-17-03	FP	PER APPR'L / FINAL RESUBMITAL	
LH-SERIES	12	0	02-14-03	FP	FOR APPROVAL	
K-SERIES	12					
VS-SUBSTITUTES	0	REV.	DATE	BY	DESCRIPTION	
#	DATE	FOR				
7/1	02-14-03	APPR'L				
7/1	03-17-03	APPR'L				
8	04-25-03	FINAL				
1	04-25-03	VULC				
DRAWN BY		FELIX P.	DATE	01-20-03	CHECKED BY	GV
DESCRIPTION		ROOF FRAMING PLAN				
JOB		WCS FIELD OPERATIONS				
LOCATION		LAS VEGAS, NEVADA				
ARCHITECT		TATE SNYDER KIMSEY				
CUSTOMER		TARGET GENERAL				
VULCRAFT FILE NUMBER	JOB NUMBER	DRAWING NUMBER	REV #			
S76-02-0973	5328	J1 of 2	2			

(1) S/C GRAY PAINT

C-241-02