



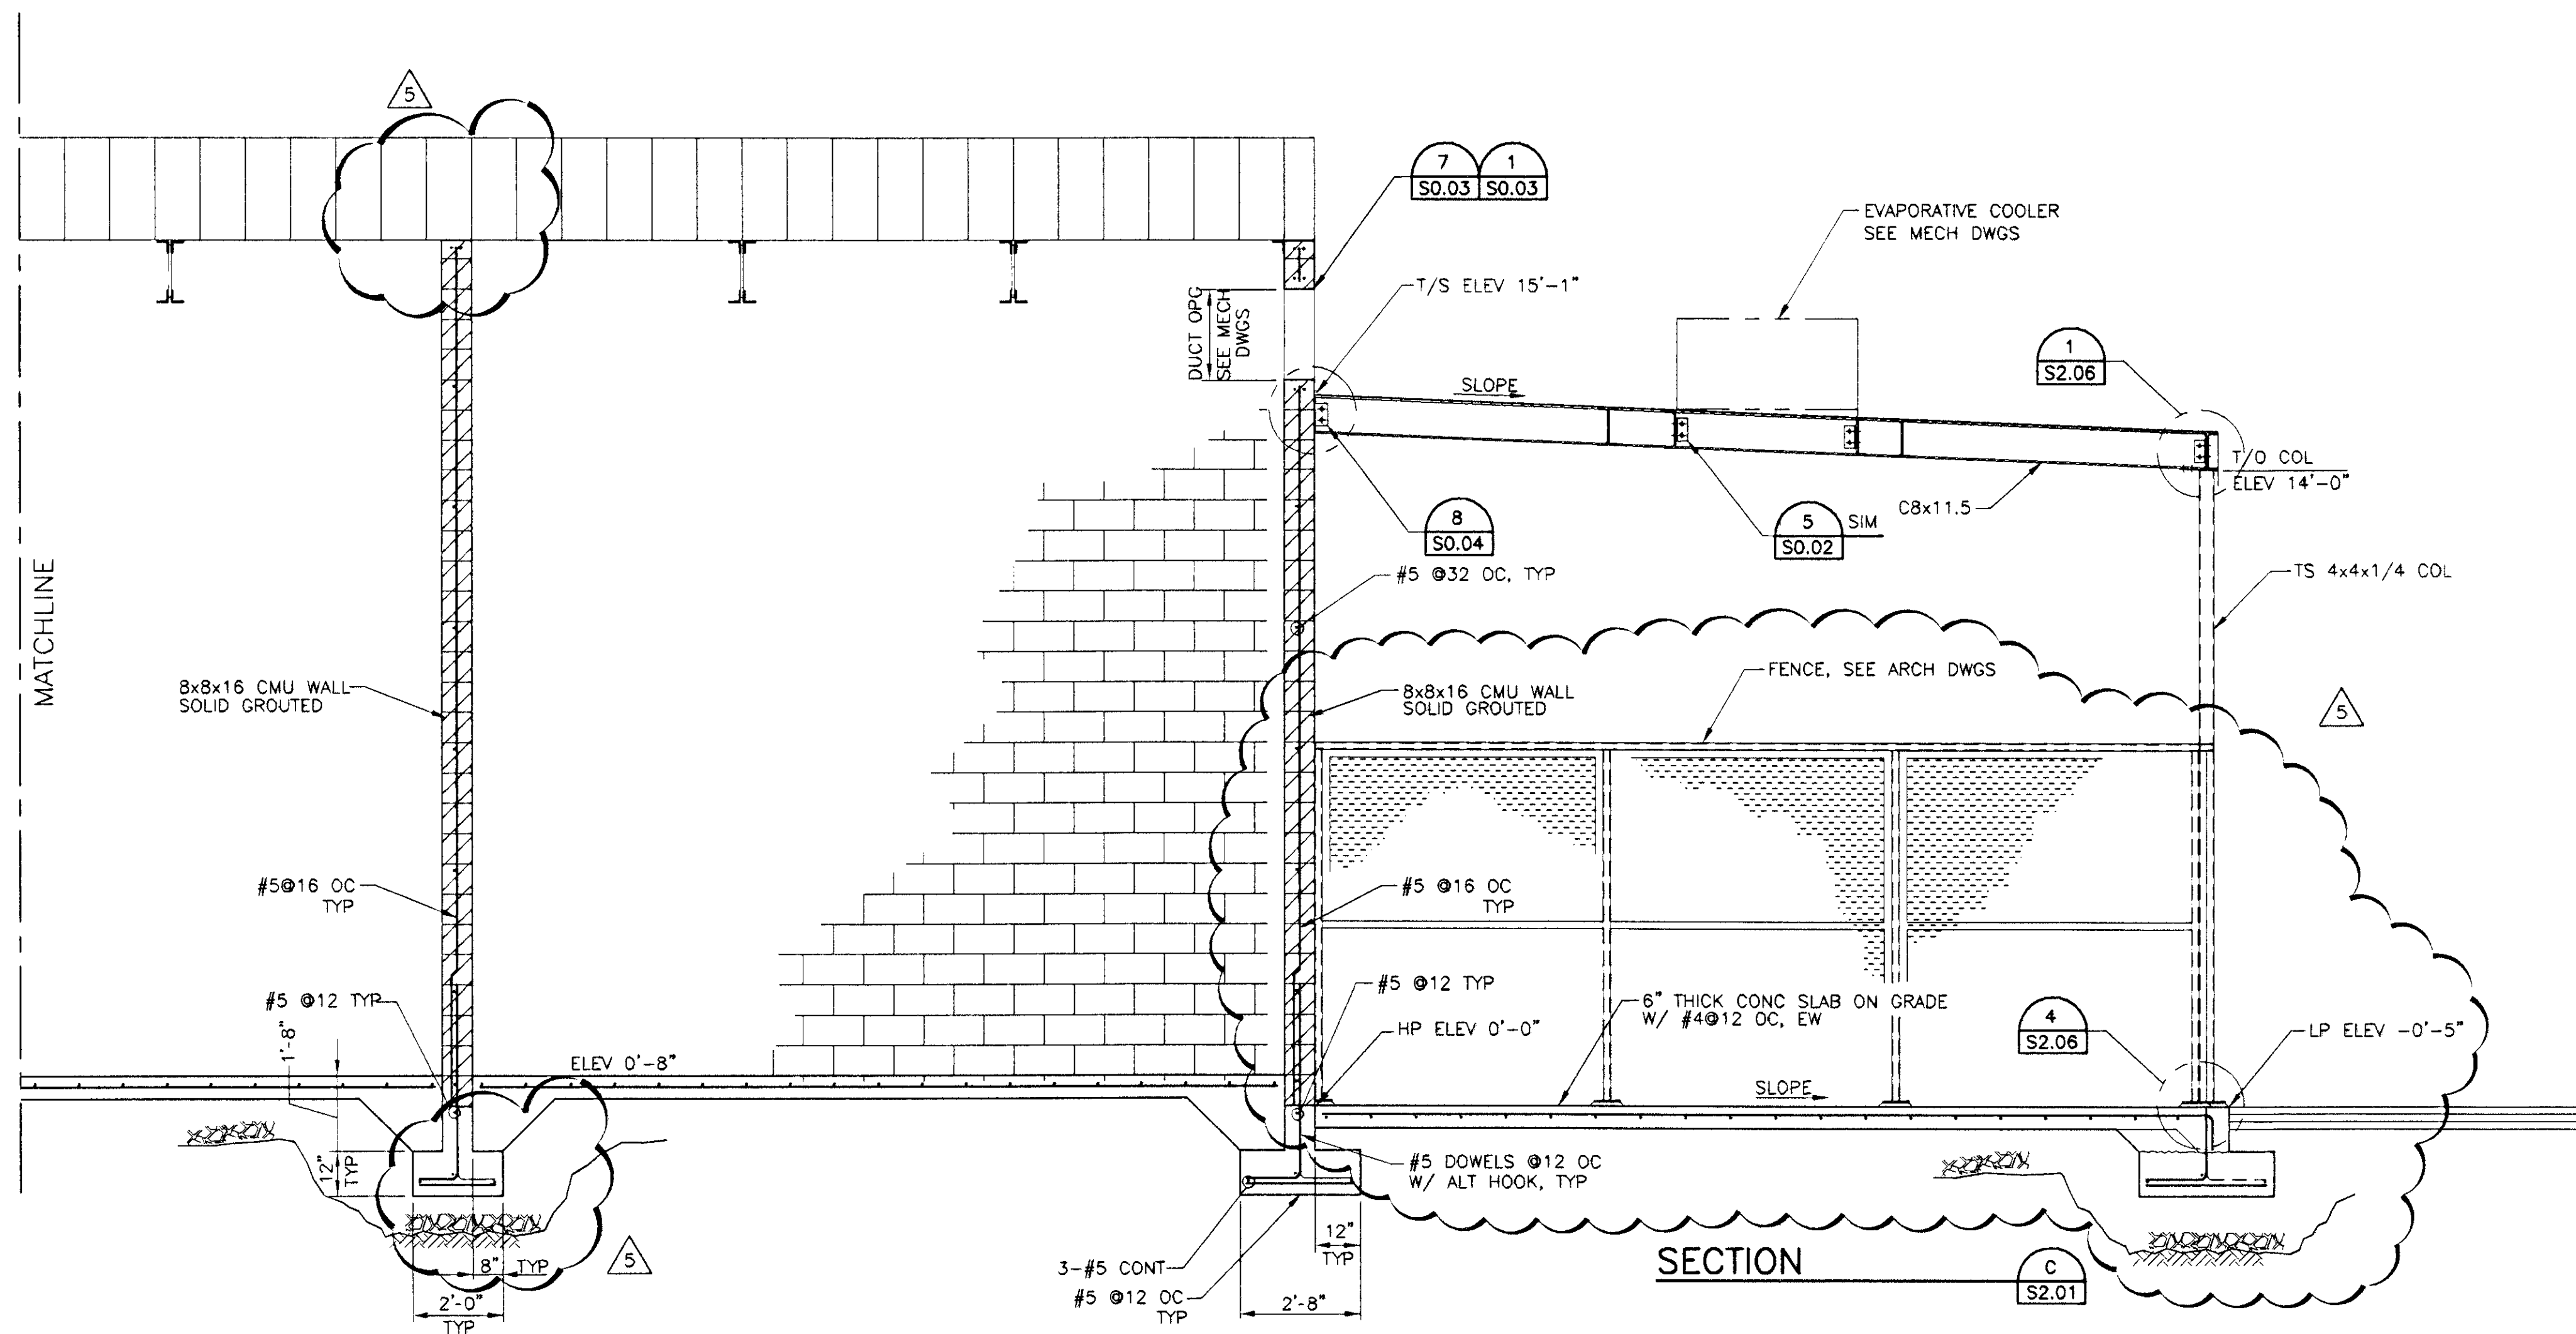

584262

RECEIVED
MAR 18 2003
CITY OF LAS VEGAS
PERMITS

APPROVAL IS FOR CLOUDY
AREAS OR LATEST REVISION
ONLY SEE ORIGINALS
FOR OTHER REQUIREMENTS

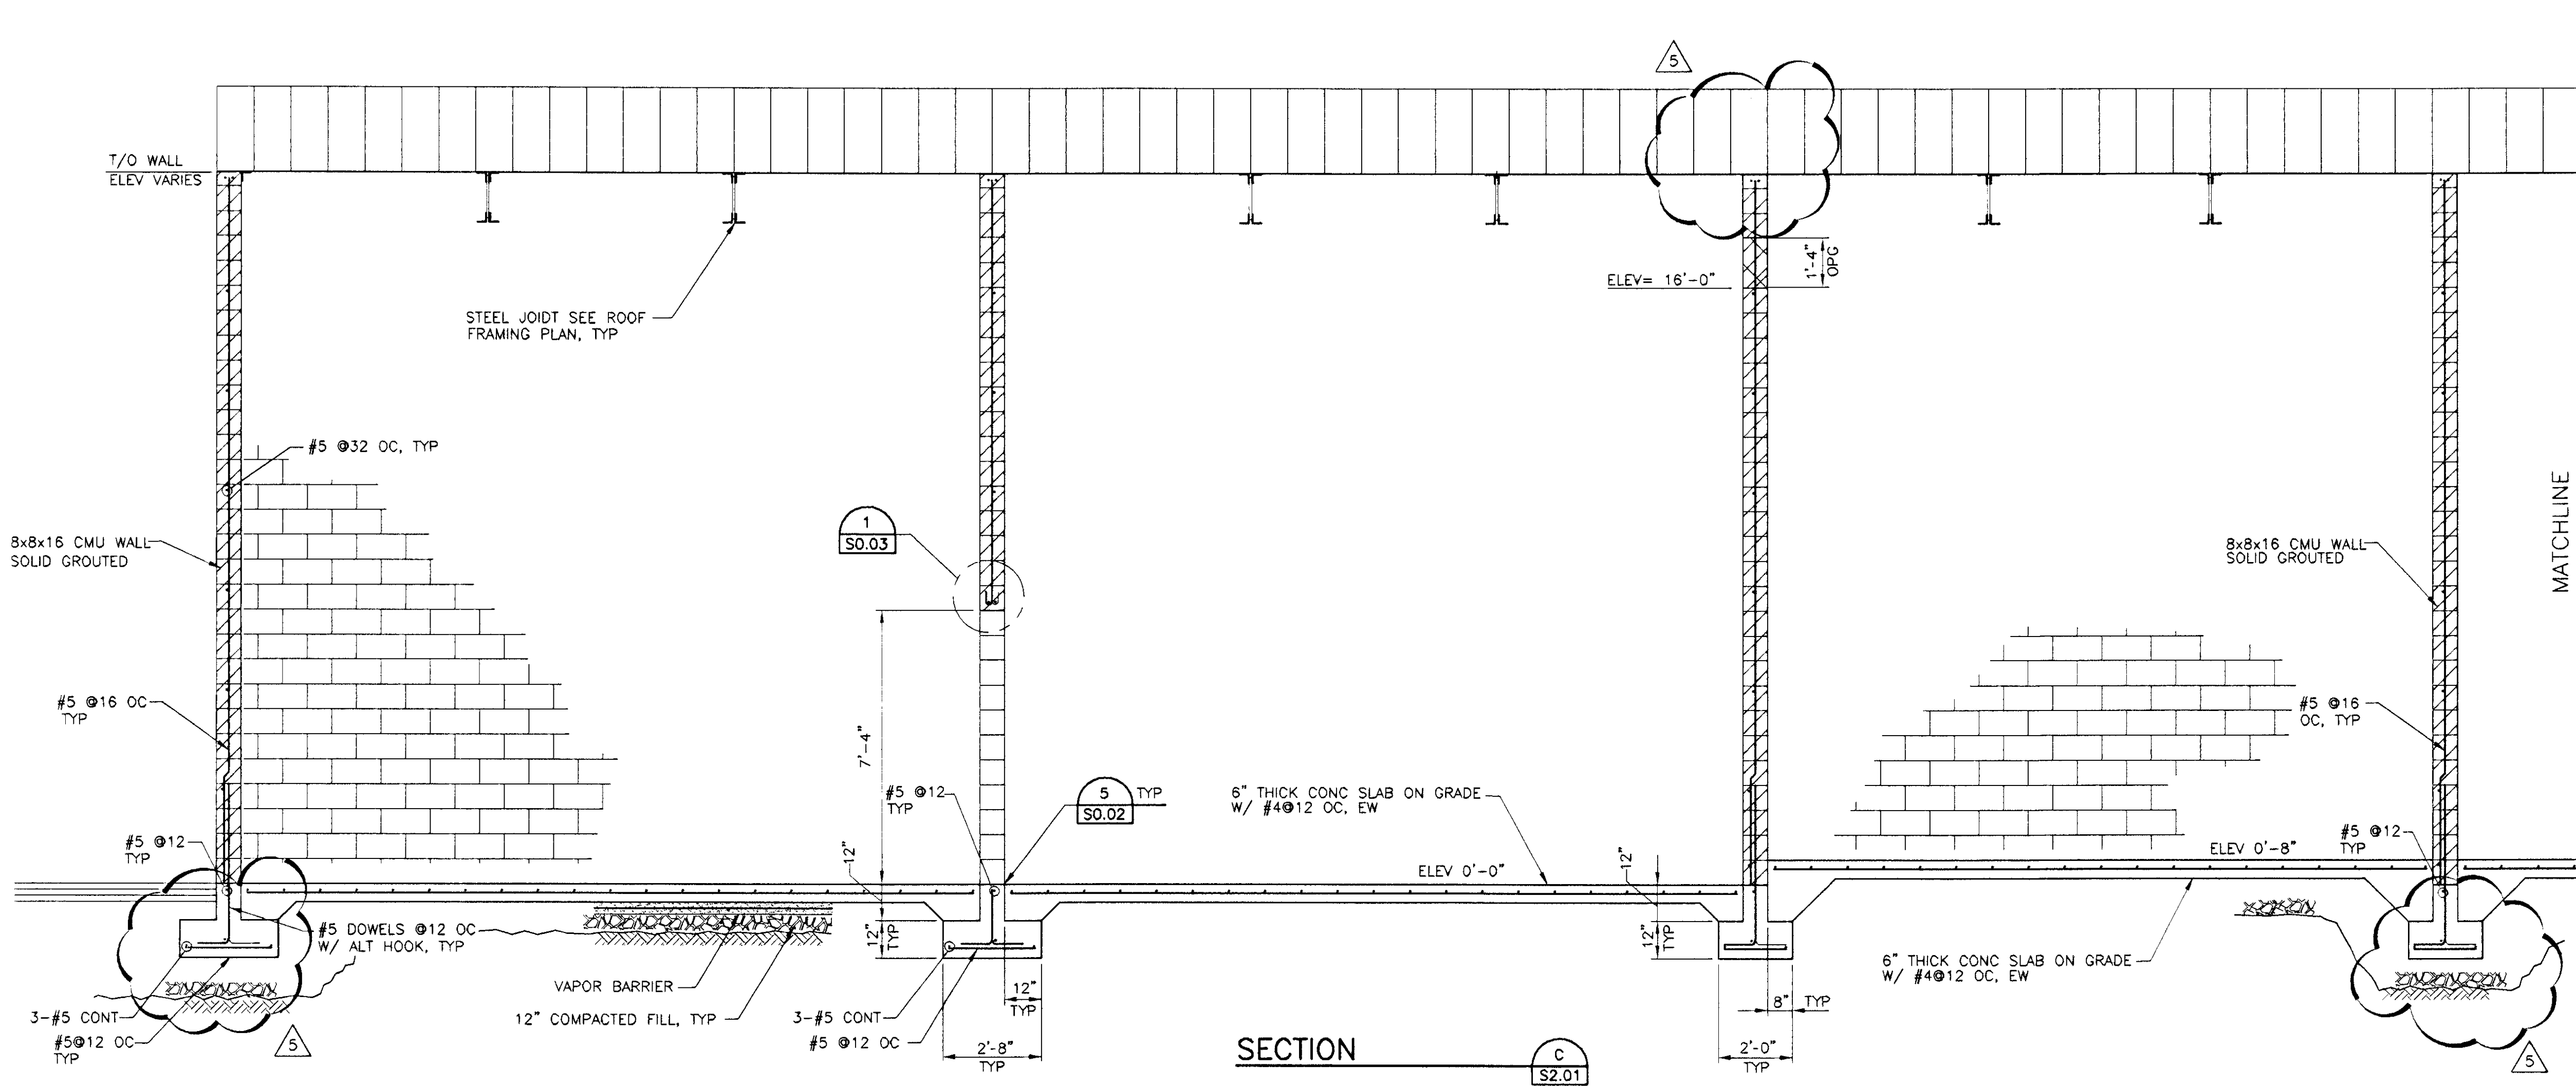


REVISIONS
5 03.14.03

CONSULTANT
poggemeyer
design group, inc.
ARCHITECTS
2800 North Durango Way, Las Vegas, NV 89128 • P 702.258.8100 • F 702.258.8175

CITY OF LAS VEGAS WEST SERVICE YARD
BUFFALO DRIVE AND PEAK ROAD
LAS VEGAS, NEVADA
SECTION
FIELD MAINTENANCE BUILDING

APPROVED
STRUCTURAL
ENGINEER
APR 10 2003

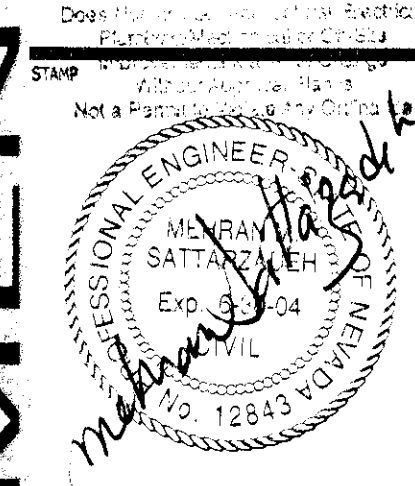

OWNER: CITY OF LAS VEGAS
DEPARTMENT OF PUBLIC WORKS
ARCHITECTURAL SERVICES

400 EAST STEWART AVENUE
LAS VEGAS, NEVADA 89101
PHONE: (702) 225-6335
FAX: (702) 386-3232
DD: (702) 386-9108

DRAWN: SHK
FILE: 0475205
DATE: 03.14.03
SCALE: 3/8"=1'-0"
SHEET NO: 02.15341.09
CITY DWG NO: 107.V3548

SHEET NO
S2.05
OF