


**NOTES**

① INSTALL HIGH ON WALL.

**FLOOR PLAN**  
SCALE: 1/8" = 1'-0"

A

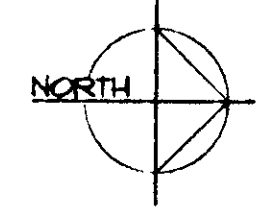

APPROVAL IS FOR CLOUDED  
AREAS  
ONLY. SEE ORIGINALS  
FOR OTHER REQUIREMENTS

584262  
RECEIVED  
MAR 18 2003  
CITY OF LAS VEGAS  
PERMITS

PLANS APPROVED  
PLUMBING/MECHANICAL  
Submittal - State of Nevada  
City of Las Vegas  
JCF  
MAR 23 2003  
Not include Architectural, Electrical  
Structural or Civil  
Improvements Scale No Change  
Without Approval From us  
Not a Firm to Update Any Circulation




REVISION  
PLAN CHECK  
FEBRUARY 24, 2003

CONSULTANT

DATE SIGNED: KIMSEY  
[Signature]

CITY OF LAS VEGAS WEST SERVICE YARD  
BUFFALO DRIVE AND PEAK ROAD  
LAS VEGAS, NEVADA  
FLOOR PLAN  
MATERIALS HANDLING BUILDING

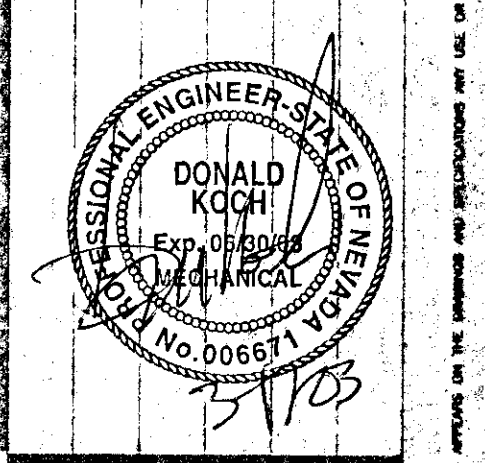

OWNER: CITY OF LAS VEGAS  
DEPARTMENT OF PUBLIC WORKS  
ARCHITECTURAL SERVICES

400 EAST STEWART AVENUE  
LAS VEGAS, NEVADA 89101  
PHONE: (702) 229-2535  
FAX: (702) 362-2232  
(702) 366-9108

OWNER	DD
FILE	6431112.DWG
DATE	03.15.02
SCALE	1/8" = 1'-0"
ADD NO	02.15341.09
CITY DWG NO	107-V3548
SHEET NO	M1.12

**CONSULTING ENGINEERS**

**jba**

3048 WEST EDNA  
LAS VEGAS  
NEVADA 89146  
(702) 362-1208

3070 BRISTOL STREET  
SUITE 200  
DUBLIN, CALIFORNIA 94568  
(916) 735-3324