


UBC APP. 12 TABLE A-12-A CALC		
SQ. FT.	OSA CFM (S.F.)	CFM OSA REQ.
134	(.14)	= 19
131	(.14)	= 18
134	(.14)	= 19
126	(.05)	= 6
		= 62 CFM REQ'D
HP1B		= 100 CFM OSA PROVIDED

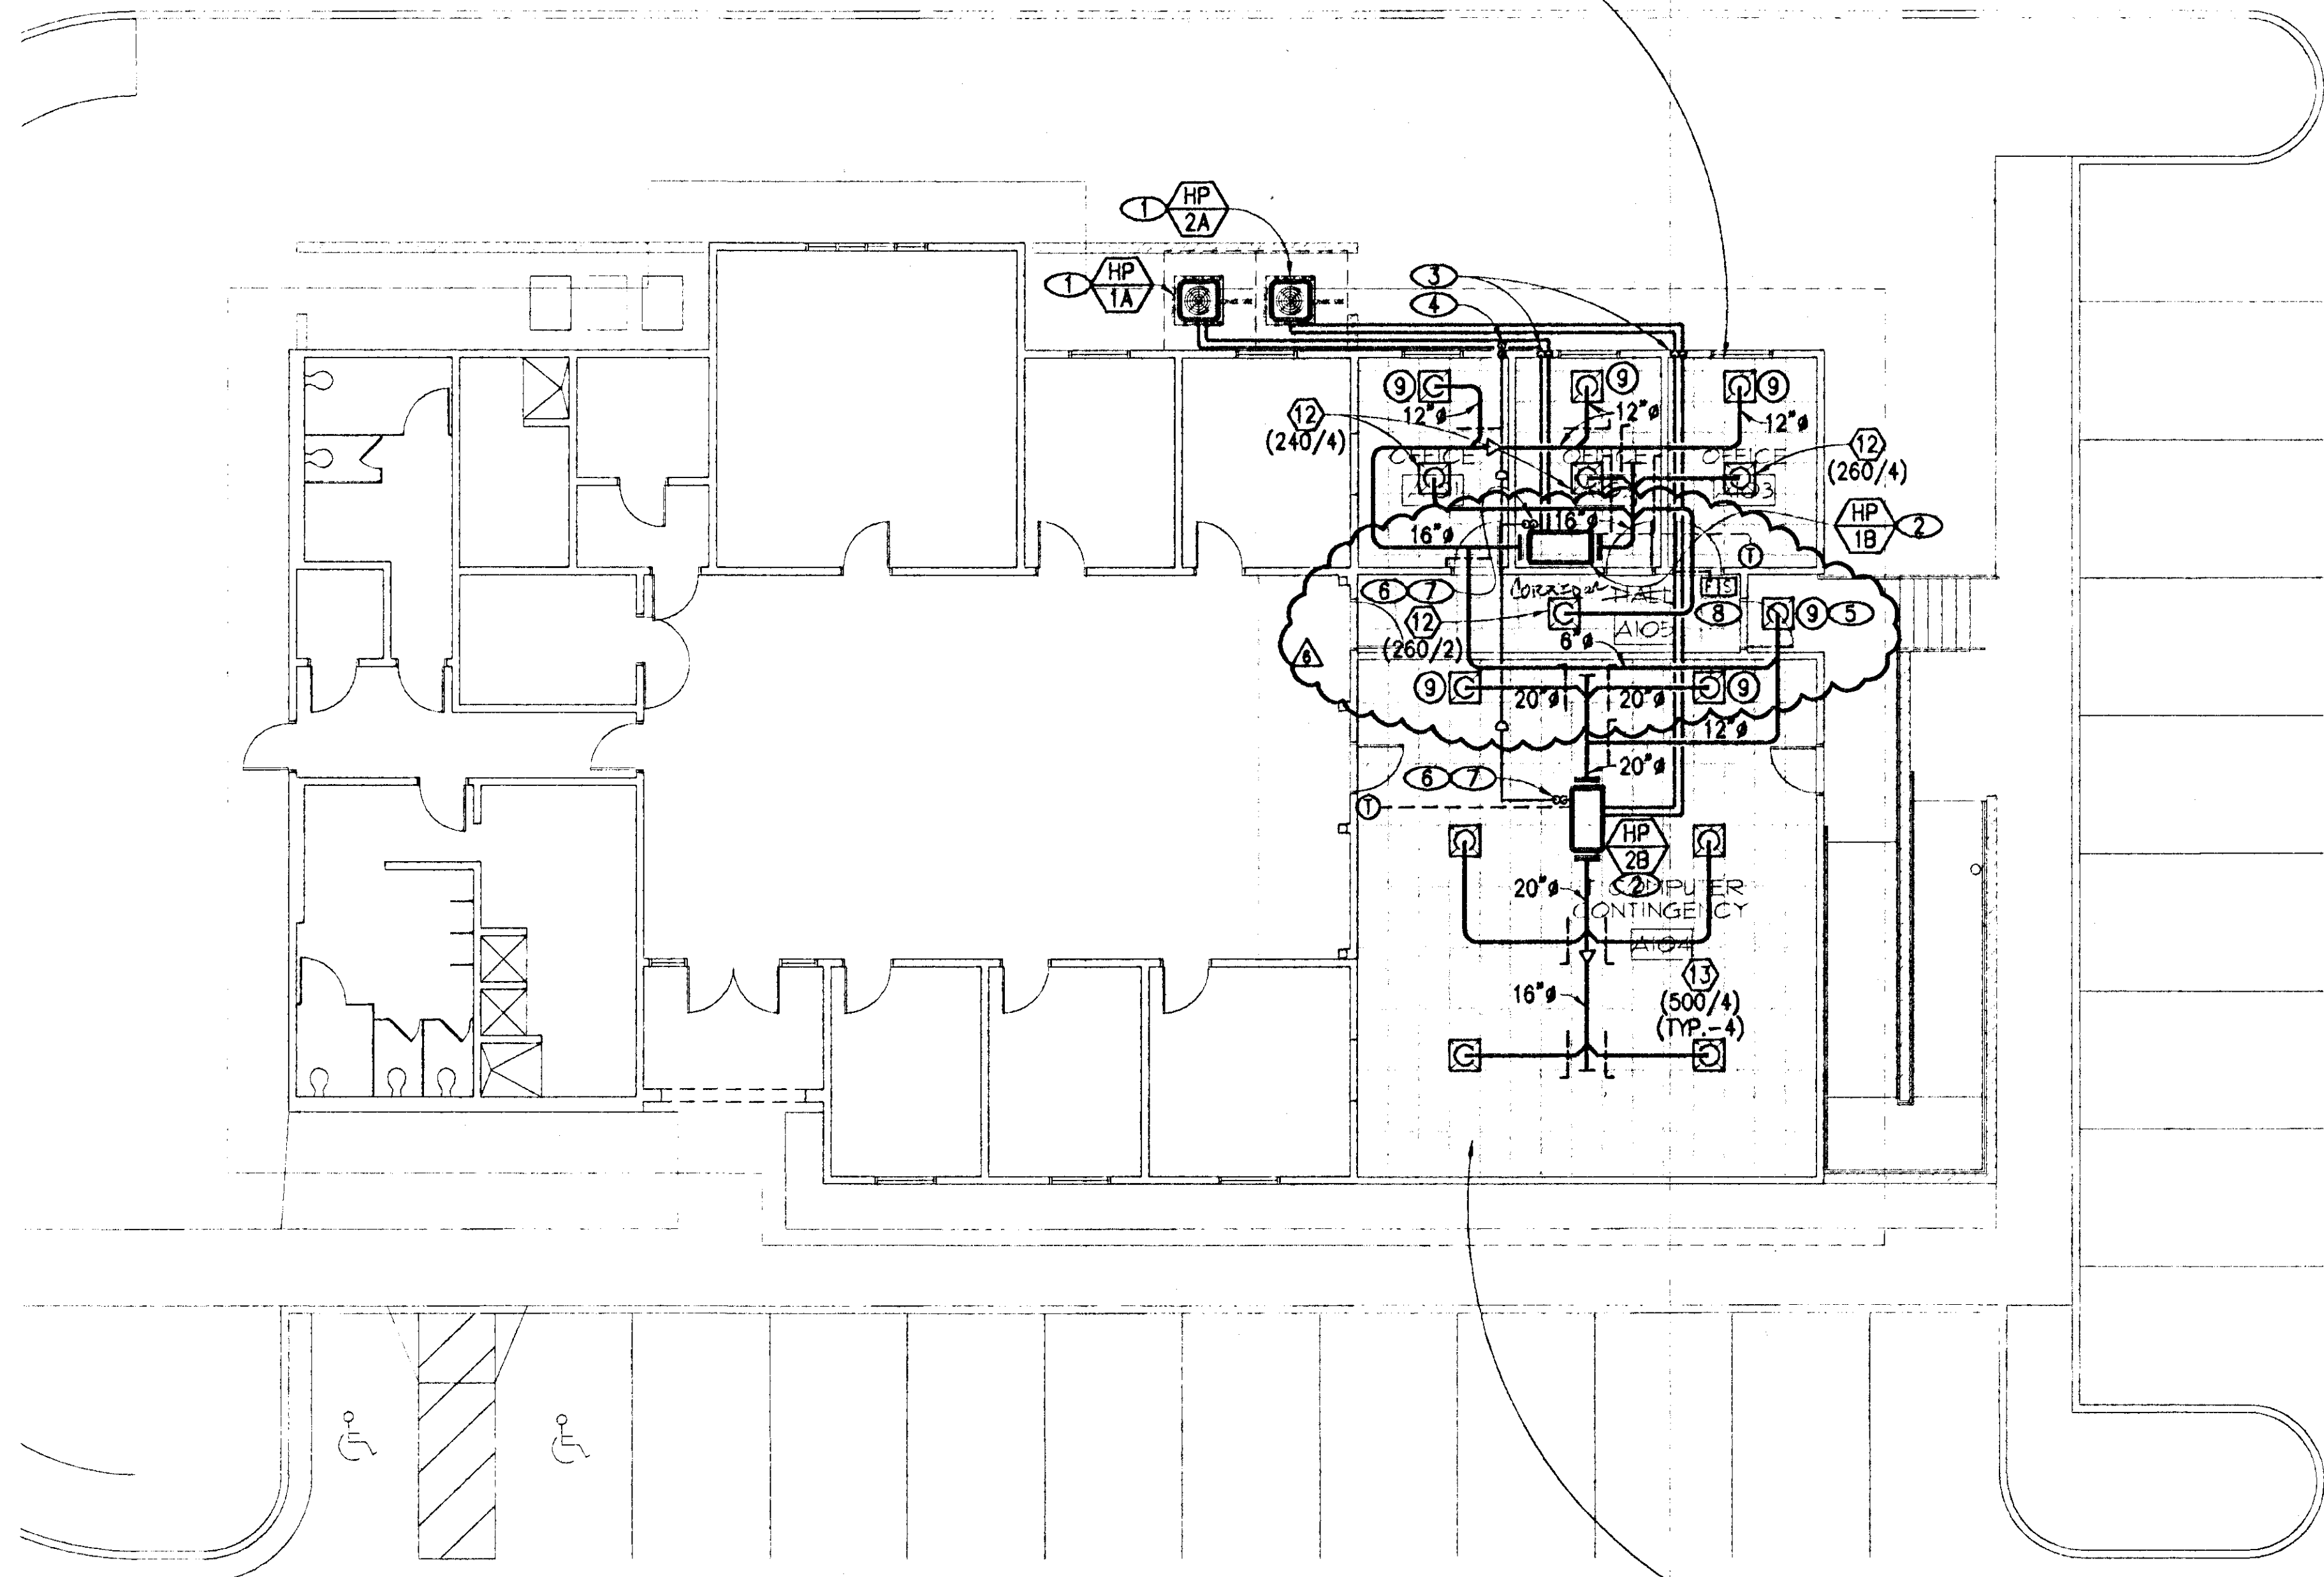

**FLOOR PLAN**  
SCALE: 1/8" = 1'-0"

UBC APP. 12 TABLE A-12-A CALC		
SQ. FT.	OSA CFM (S.F.)	CFM OSA REQ.
1017	(.14)	= 142
HP2B		= 400 CFM OSA PROVIDED

- NOTES**
- ① 4" CONCRETE PAD.
  - ② SEE MOUNTING DETAIL <sup>2</sup> M3.07.
  - ③ REFRIGERANT LINES DOWN IN WALL, SIZE PER MANUFACTURER'S RECOMMENDATIONS.
  - ④ 3/4" D. DOWN IN WALL, TERMINATE 18" A.F.F. WITH 90° ELL. DOWN.
  - ⑤ PROVIDE W/ 2" FILTER FRAME, (1) 20"x20"x2" CARBON IMPREGNATED DISPOSABLE FILTER.
  - ⑥ 3/4" D. WITH VENTED P-TRAP.
  - ⑦ PROVIDE OVERFLOW DRAIN PIPING SYSTEM PARALLEL TO DRAIN DRAIN SYSTEM, TERMINATE ADJACENT TO DRAIN PIPING.
  - ⑧ SEE FIRE/SMOKE DAMPER DETAIL <sup>5</sup> M3.07.

APPROVAL IS FOR CLOUDED AREAS OR LATEST REVISIONS ONLY. SEE ORIGINALS FOR OTHER REQUIREMENTS.

PLANS APPROVED  
PLUMBING/MECHANICAL  
Building & Safety Dept.  
City of Las Vegas, Nevada  
APR 10 2003  
Not Not Include Architectural, Electrical, Structural or Civil Site Improvements Make No Change Without Approval Plan is Not a Permit to Violate Any Ordinance



REVISIONS  
① PLAN CHECK FEBRUARY 24, 2003  
② CLV COMMENT RESPONSE APRIL 2, 2003

CONSULTANT  
TATE SNYDER KIMBLEY  
Professional Engineer  
No. 00661111  
Las Vegas, Nevada

CITY OF LAS VEGAS WEST SERVICE YARD  
BUFFALO DRIVE AND PEAK ROAD  
LAS VEGAS, NEVADA  
FLOOR PLAN  
I.T. ADDITION

PROFESSIONAL ENGINEER-STATE OF NEVADA  
DONALD KOCH  
No. 00661111  
Las Vegas, Nevada  
4/3/03

OWNER: CITY OF LAS VEGAS  
DEPARTMENT OF PUBLIC WORKS  
ARCHITECTURAL SERVICES

400 EAST STEWART AVENUE  
LAS VEGAS, NEVADA 89101  
PHONE: (702) 228-8333  
FAX: (702) 262-2332  
TDD: (702) 266-9108

RECEIVED  
APR 04 2003  
CITY OF LAS VEGAS  
BUILDING DEPT.

CONSULTING ENGINEERS  
jba  
5405 WEST CONA LAS VEGAS, NEVADA 89116 (702) 362-9308  
3675 BRITISH SIKER SUITE 500 COSTA MESA CALIFORNIA 92626 (714) 951-3154

DRAWN	DO
FILE	6431M114.DWG
DATE	03.15.02
SCALE	1/8" = 1'-0"
NO. 02	15341.09
REV. 01	107-V3548
NO.	M1.14

D:\9431\Drawings\MECH\9431M114.dwg, 04/03/2003 09:48:14 AM, gcaulan