

NOTES


- ① SEE CIVIL SITE UTILITY PLAN FOR CONT.
- ② 4" SANITARY SEWER SERVICE. INVERT = 73.25 (VERIFY PRIOR TO BEGINNING WORK).
- ③ 6" FIRE SPRINKLER SERVICE.
- ④ 2" DOMESTIC WATER SERVICE.
- ⑤ 3/4" C.W. DOWN IN WALL TO H.B. @ +24" A.F.F.
- ⑥ CLEAN OUT TO GRADE, SEE (1).
- ⑦ 1" GAS PIPE UP THRU ROOF. PROVIDE G.C. AND FLEX. CONNECTION TO UNIT.
- ⑧ 3/4" DRAIN FROM AC UNIT W/ P-TRAP.
- ⑨ 1 1/4" DRAIN DOWN IN WALL, TERMINATE OVER SERVICE SINK W/ 90° ELL. DOWN.
- ⑩ 4" R.D./O.R.D. ABOVE.
- ⑪ 3" R.D./O.R.D. ABOVE.
- ⑫ GAS SERVICE METER & REGULATOR BY S.W. GAS CORP. (100' CFH). MAIN SIZE BASED ON 25' MAX. LENGTH.
- ⑬ 4" S.D. & O.S.D. DOWN IN WALL TO 5"x3" FIBERGLASS UNDERWALK DRAIN. TERMINATE AT FACE OF CURB.
- ⑭ S.D. & O.S.D. DOWN IN WALL, PROVIDE CLEANOUT FOR S.D. & O.S.D. PIPING AT 12" A.F.F.
- ⑮ 3" S.D. & O.S.D. DOWN IN WALL, TERMINATE S.D. & O.S.D. AT FACE OF CURB.
- ⑯ PROVIDE LABEL FOR S.D. & O.S.D. AT TERMINUS.

APPROVAL IS FOR CLOUDED AREAS ONLY. SEE ORIGINALS FOR OTHER REQUIREMENTS

RECEIVED
MAR 18 2003
CITY OF LAS VEGAS PERMITS

NOTICE!
PITCH STORM & OVERFLOW STORM DRAIN PIPING AT 1/4" / FT. MINIMUM.


FLOOR PLAN
SCALE 1/8" = 1'-0"

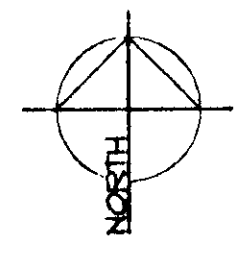

REVISION #1	AUGUST 30, 2002
REVISION #2	OCTOBER 16, 2002
REVISION #3	JANUARY 22, 2003
PLAN CHECK	MARCH 14, 2003

STATE EMPLOYER CREDENTIAL

CITY OF LAS VEGAS WEST SERVICE YARD
BUFFALO DRIVE AND PEAK ROAD
LAS VEGAS, NEVADA
FLOOR PLAN
FIELD OPERATIONS BUILDING

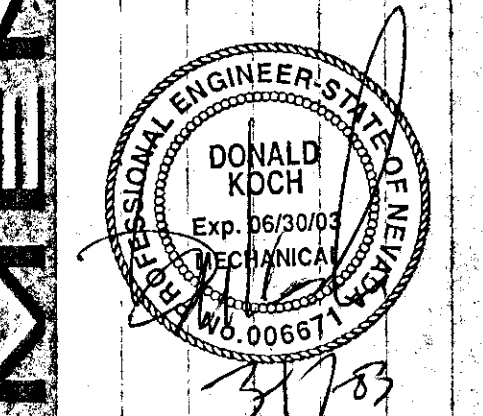

OWNER: CITY OF LAS VEGAS
DEPARTMENT OF PUBLIC WORKS
ARCHITECTURAL SERVICES

NO.	DD
FILE	6431R111.DWG
DATE	06.26.02
SCALE	1/8" = 1'-0"
NO.	02.15341.09
REVISED	107-V3548

iba CONSULTING ENGINEERS

3070 BIRCH STREET
LAS VEGAS, NEVADA 89101
(702) 362-9200

3070 BIRCH STREET
SUITE 500
OCELA, NEVADA 89024
(702) 366-9100