




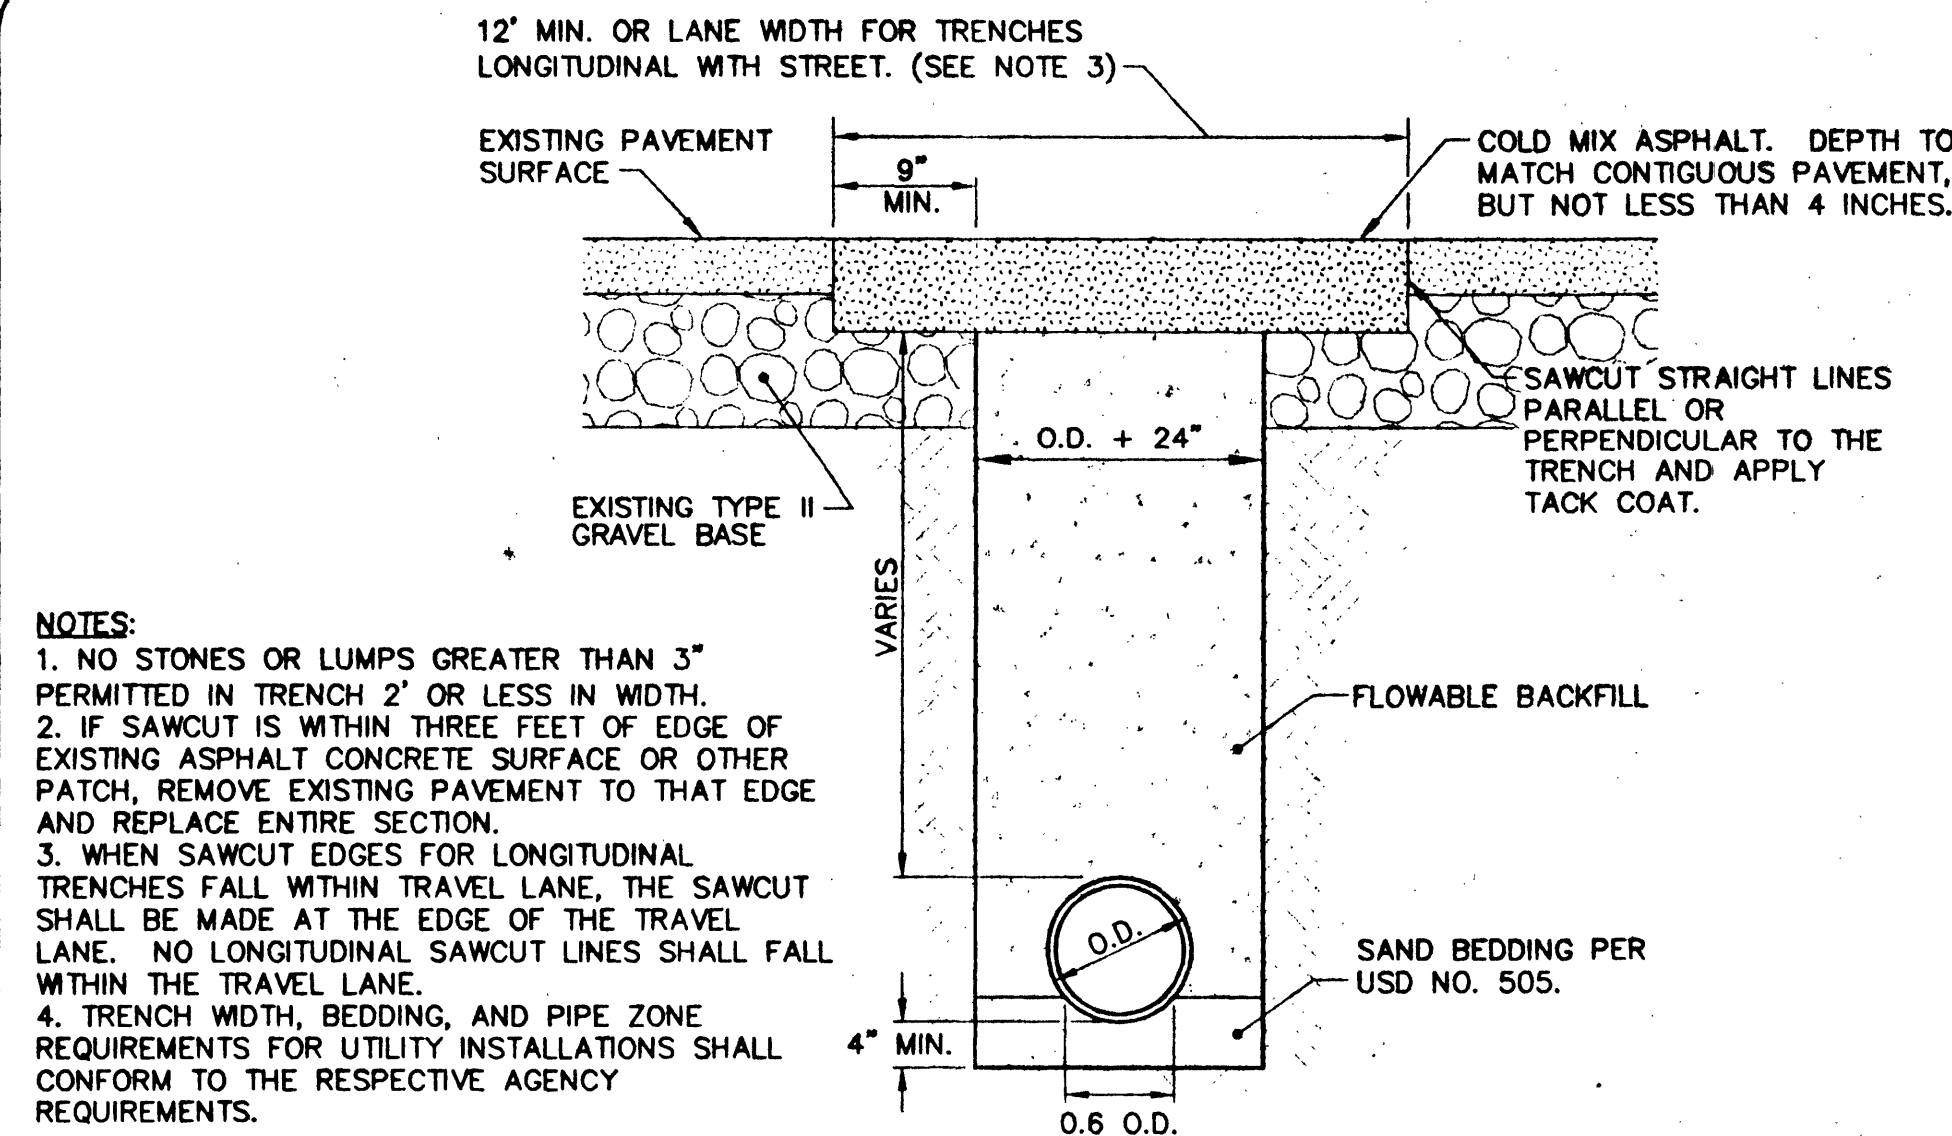


6 TYPICAL UTILITY TRENCH FOR SEWER AND STORM PIPE

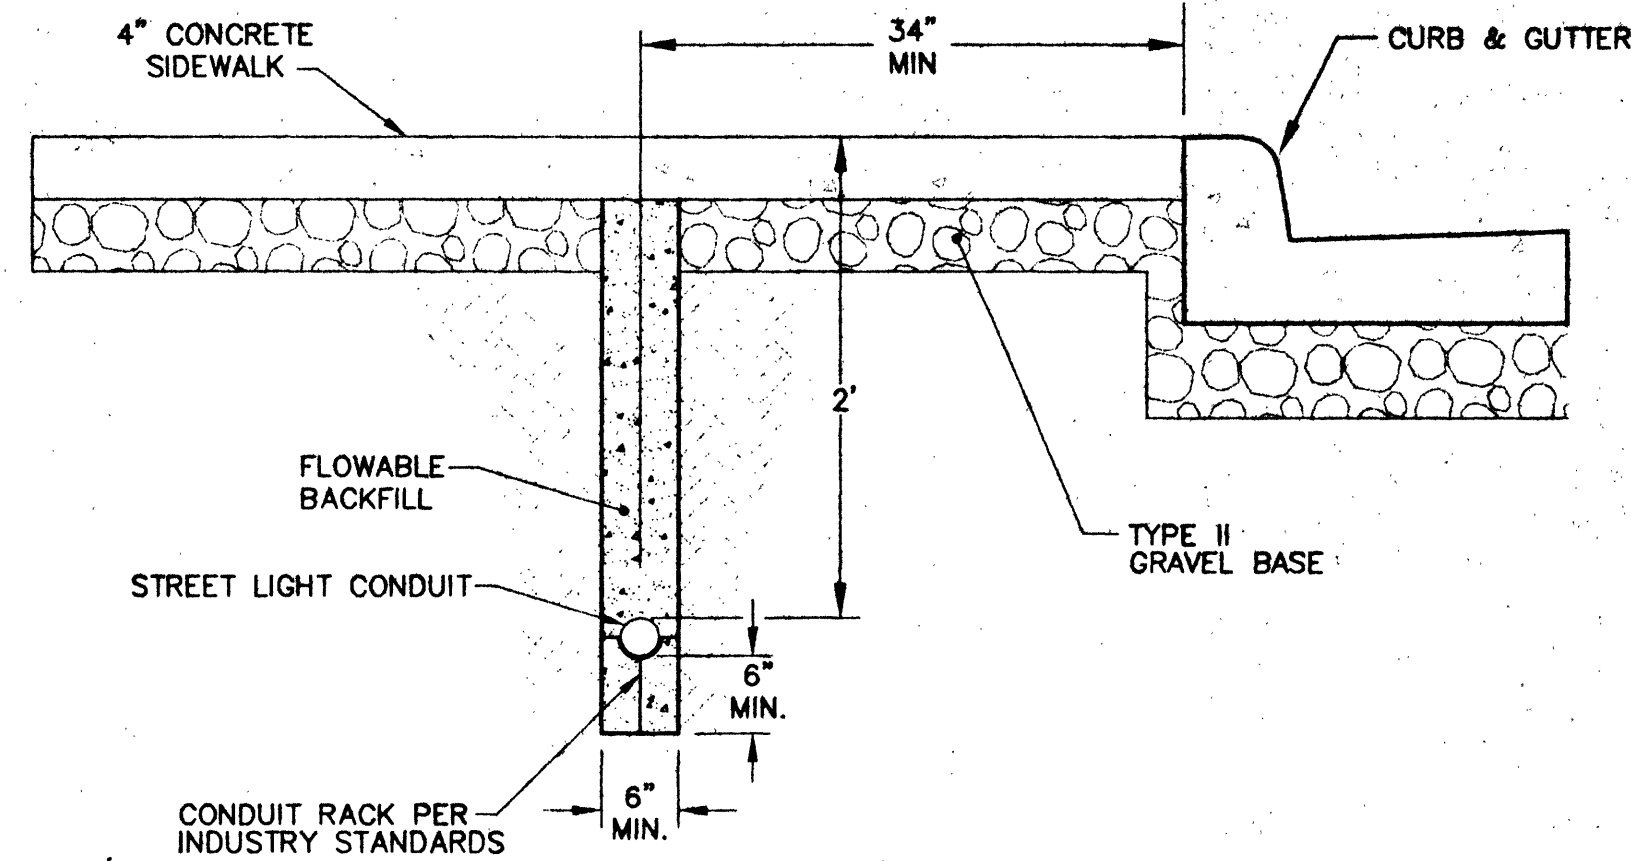


4 TYPICAL CLV TRENCH FOR STREET LIGHT CONDUIT STA. 69+70± TO STA. 72+28±

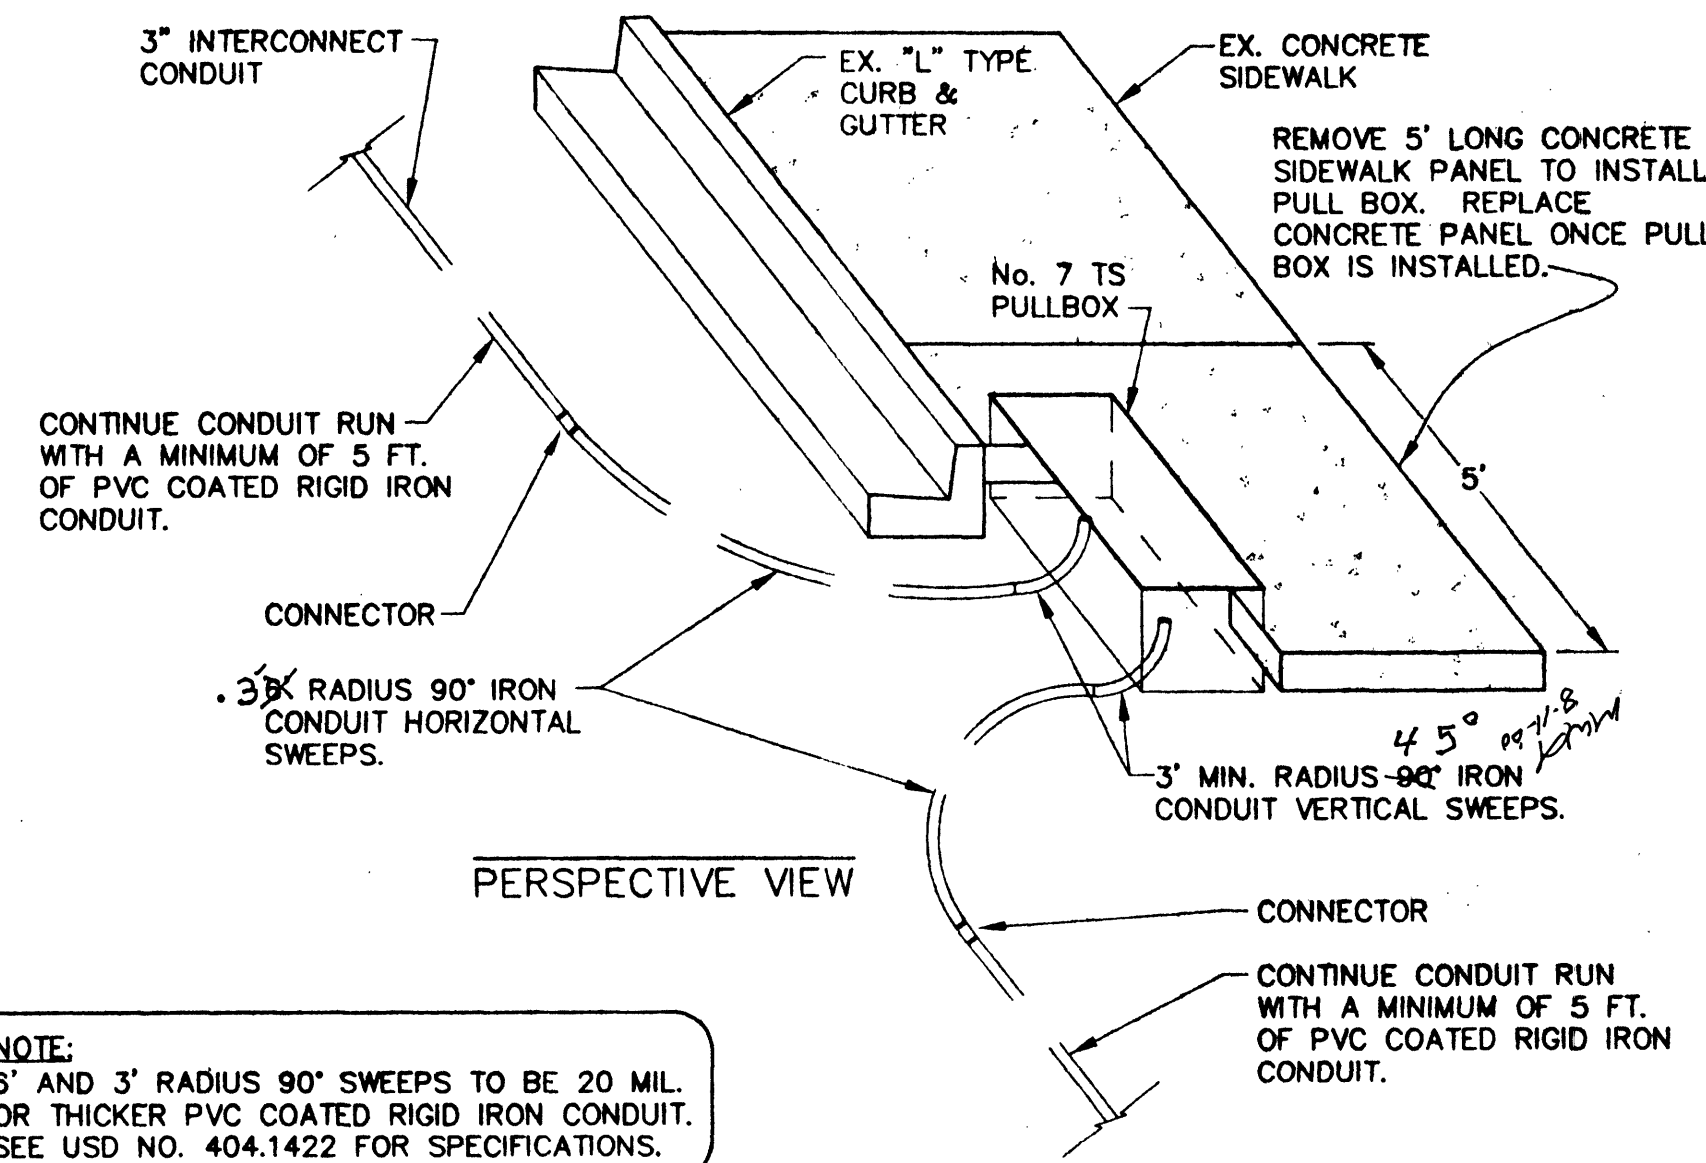


5 TYPICAL CONDUIT SWEEPS

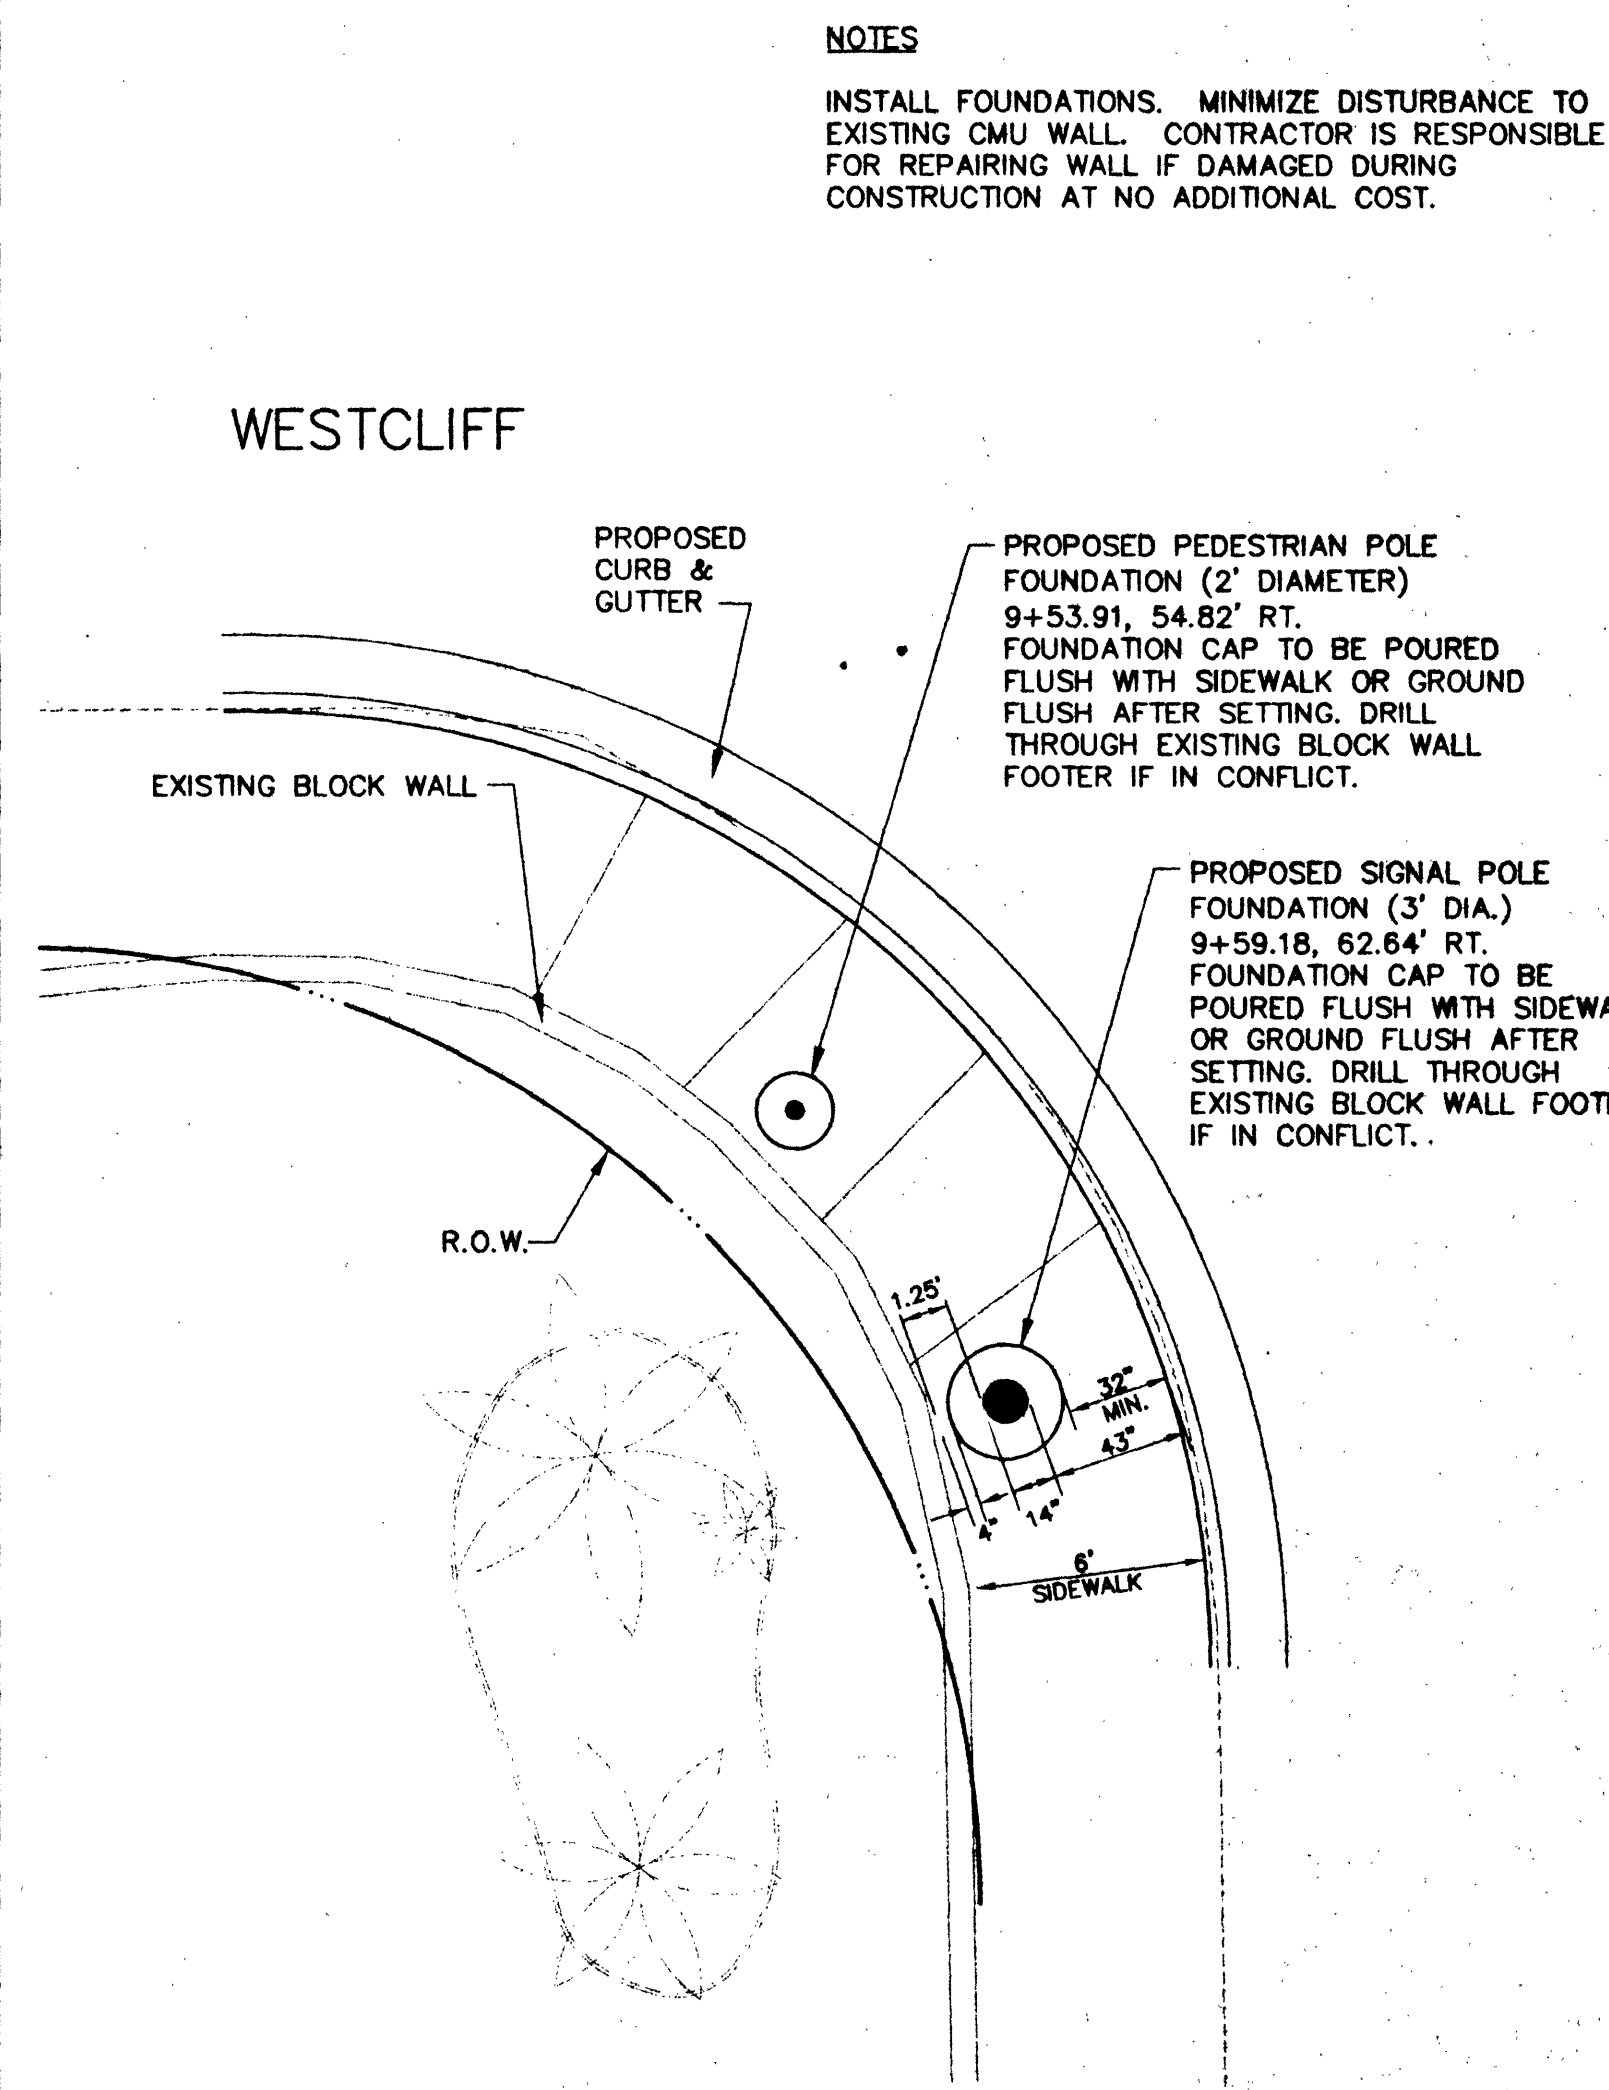

3 TRAFFIC SIGNAL POLE FOUNDATION SW CORNER OF WESTCLIFF & CIMARRON SCALE: 1\"/>

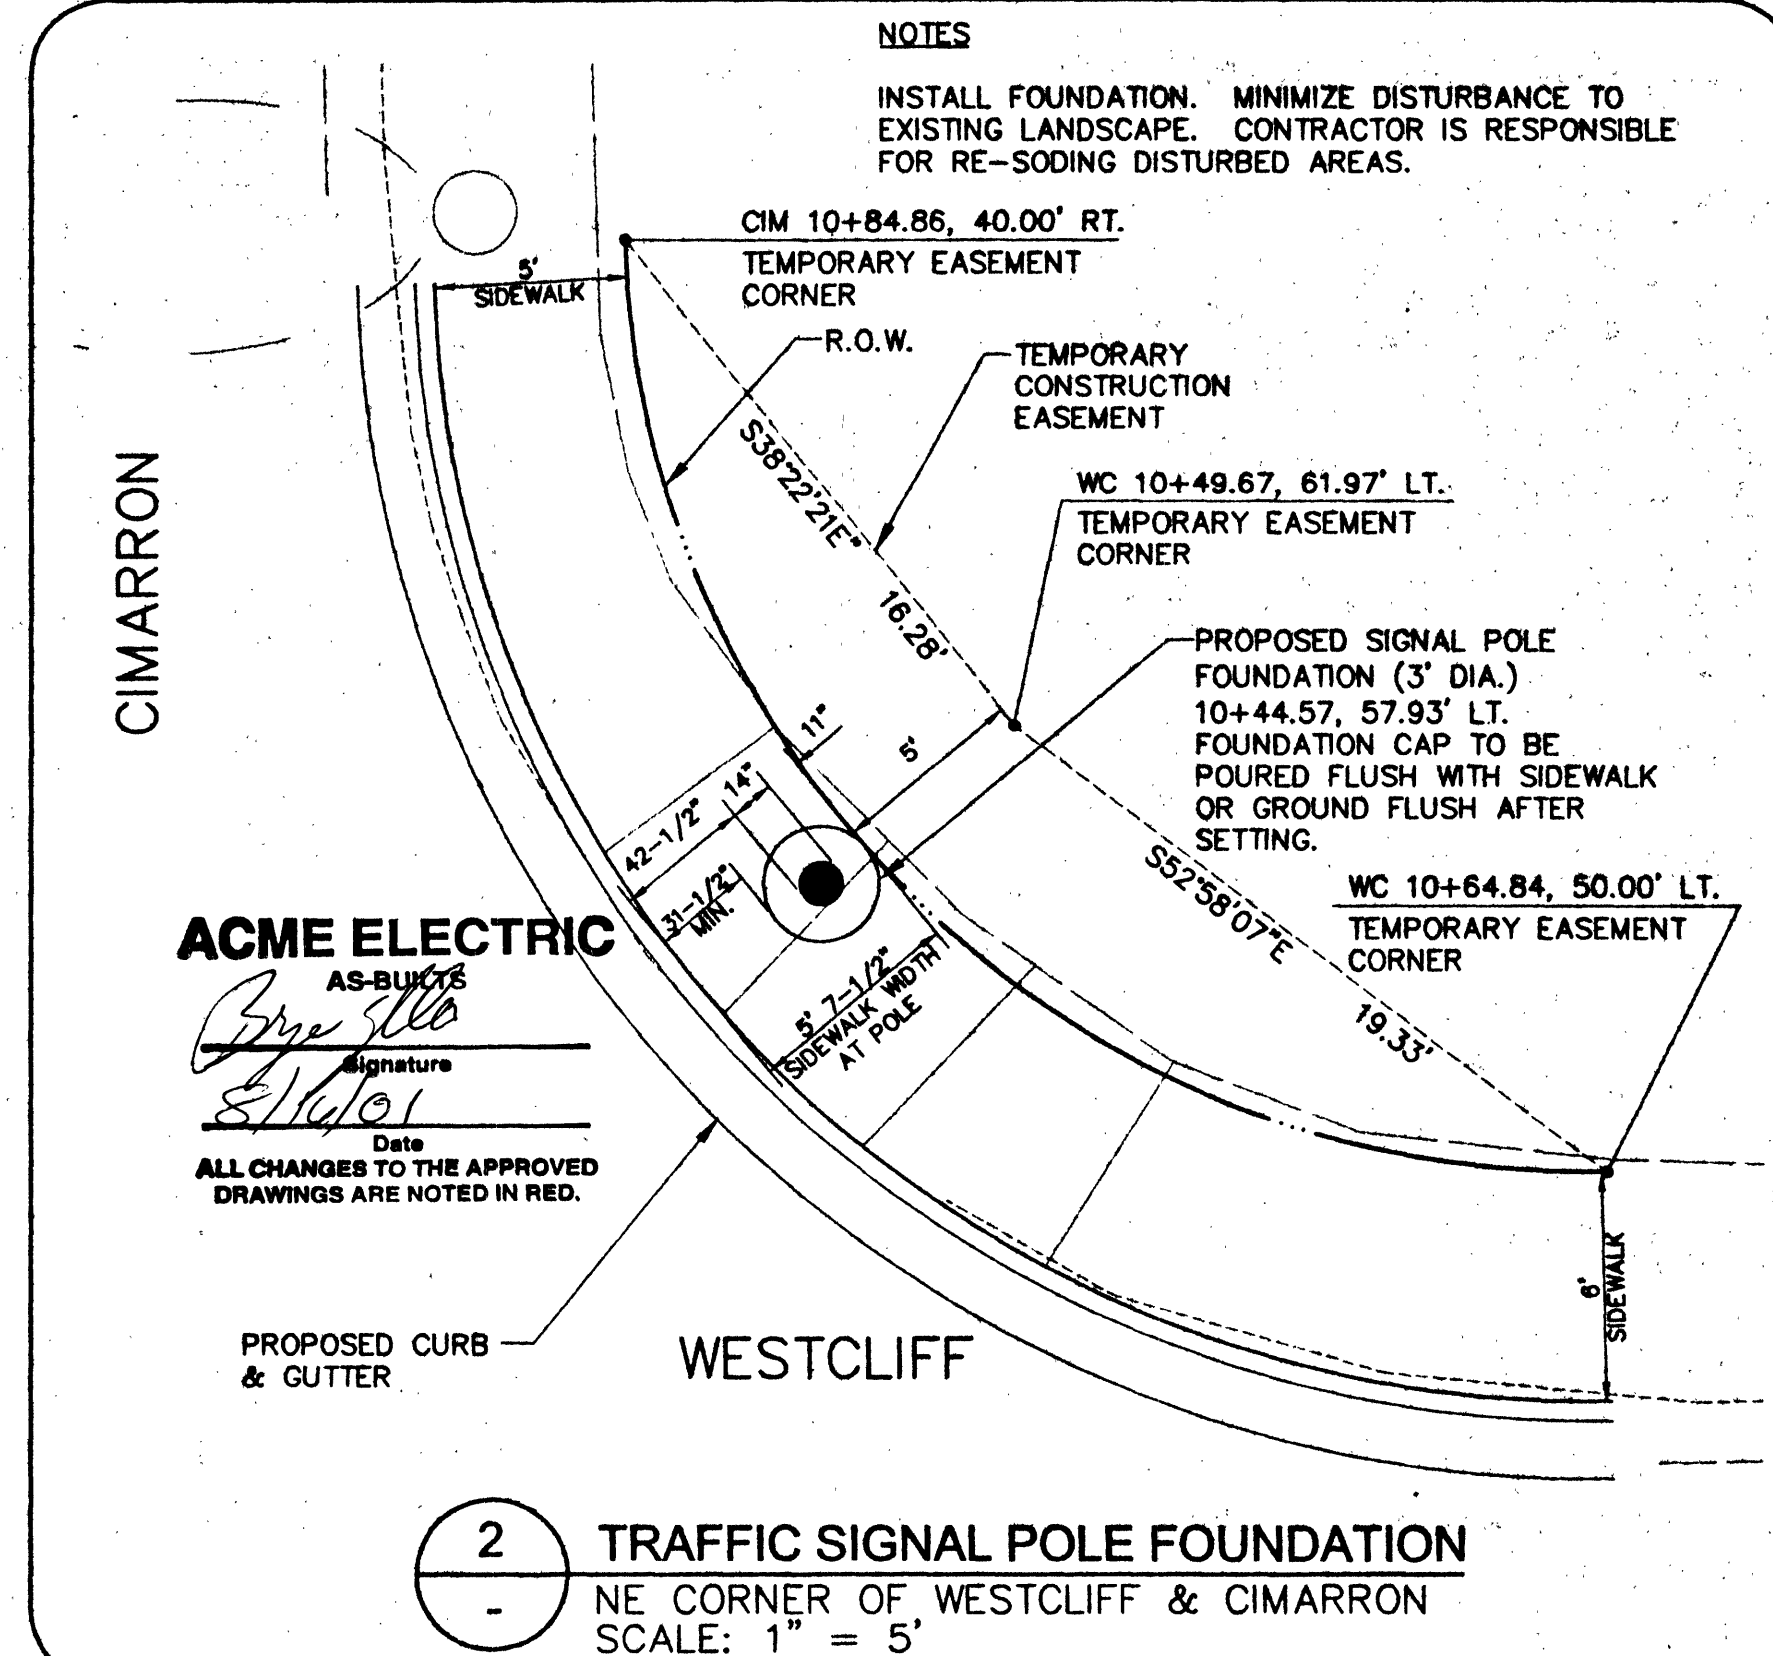

2 TRAFFIC SIGNAL POLE FOUNDATION NE CORNER OF WESTCLIFF & CIMARRON SCALE: 1\"/>

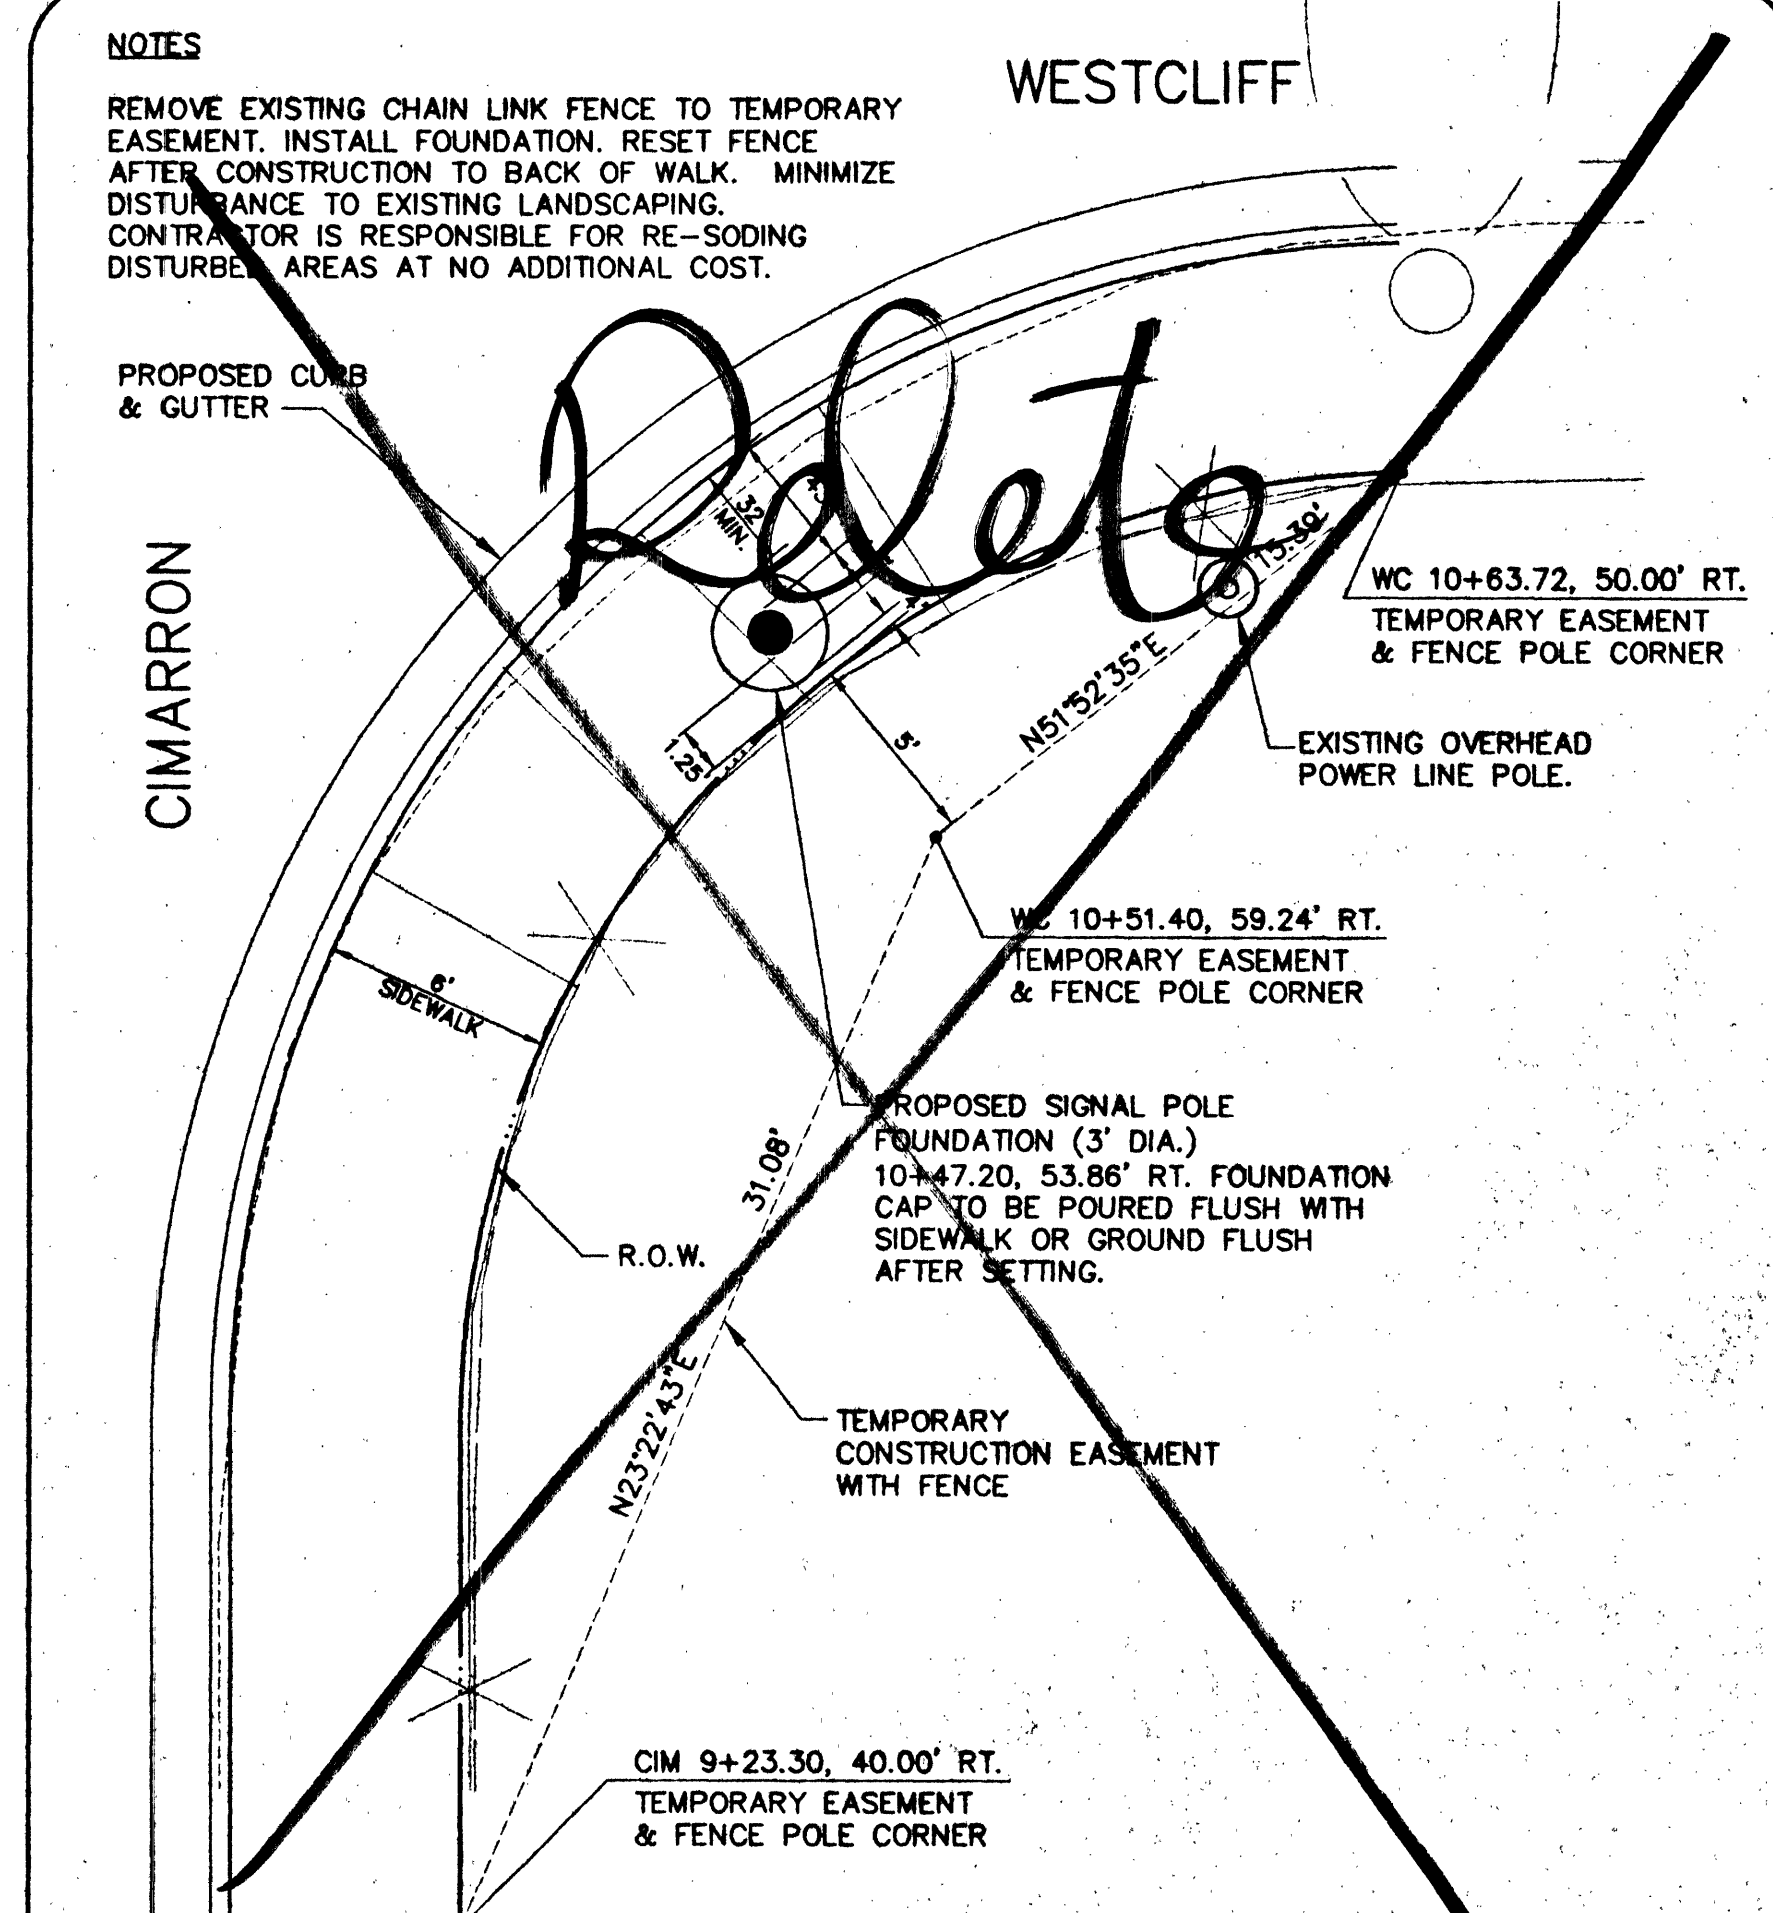

1 TRAFFIC SIGNAL POLE FOUNDATION SE CORNER OF WESTCLIFF & CIMARRON SCALE: 1\"/>

PROJ. NO.	99202
DESIGN	K.M./RAS
DATE	02/10/00
SCALE	AS SHOWN
CADFILE	WC_e12

PROFESSIONAL ENGINEER - STATE OF NEVADA
No. 9073

STAMP DATE: 02-18-00

ACEP
3320 NORTH BUFFALO DRIVE, SUITE 108
LAS VEGAS, NEVADA 89139
TEL: (702) 346-7758
FAX: (702) 346-7758

WESTCLIFF DRIVE IMPROVEMENTS
CIMARRON ROAD TO RAINBOW BLVD
CONSTRUCTION DETAILS
SHEET 2

SHEET
C-12
12 OF 47 SHEETS
DRAWING NO.
107-V3099

SOUTHERN NEVADA PAVING, INC.
AS BUILT
DATE: 10/10/01