



37.85
33.18
54.67

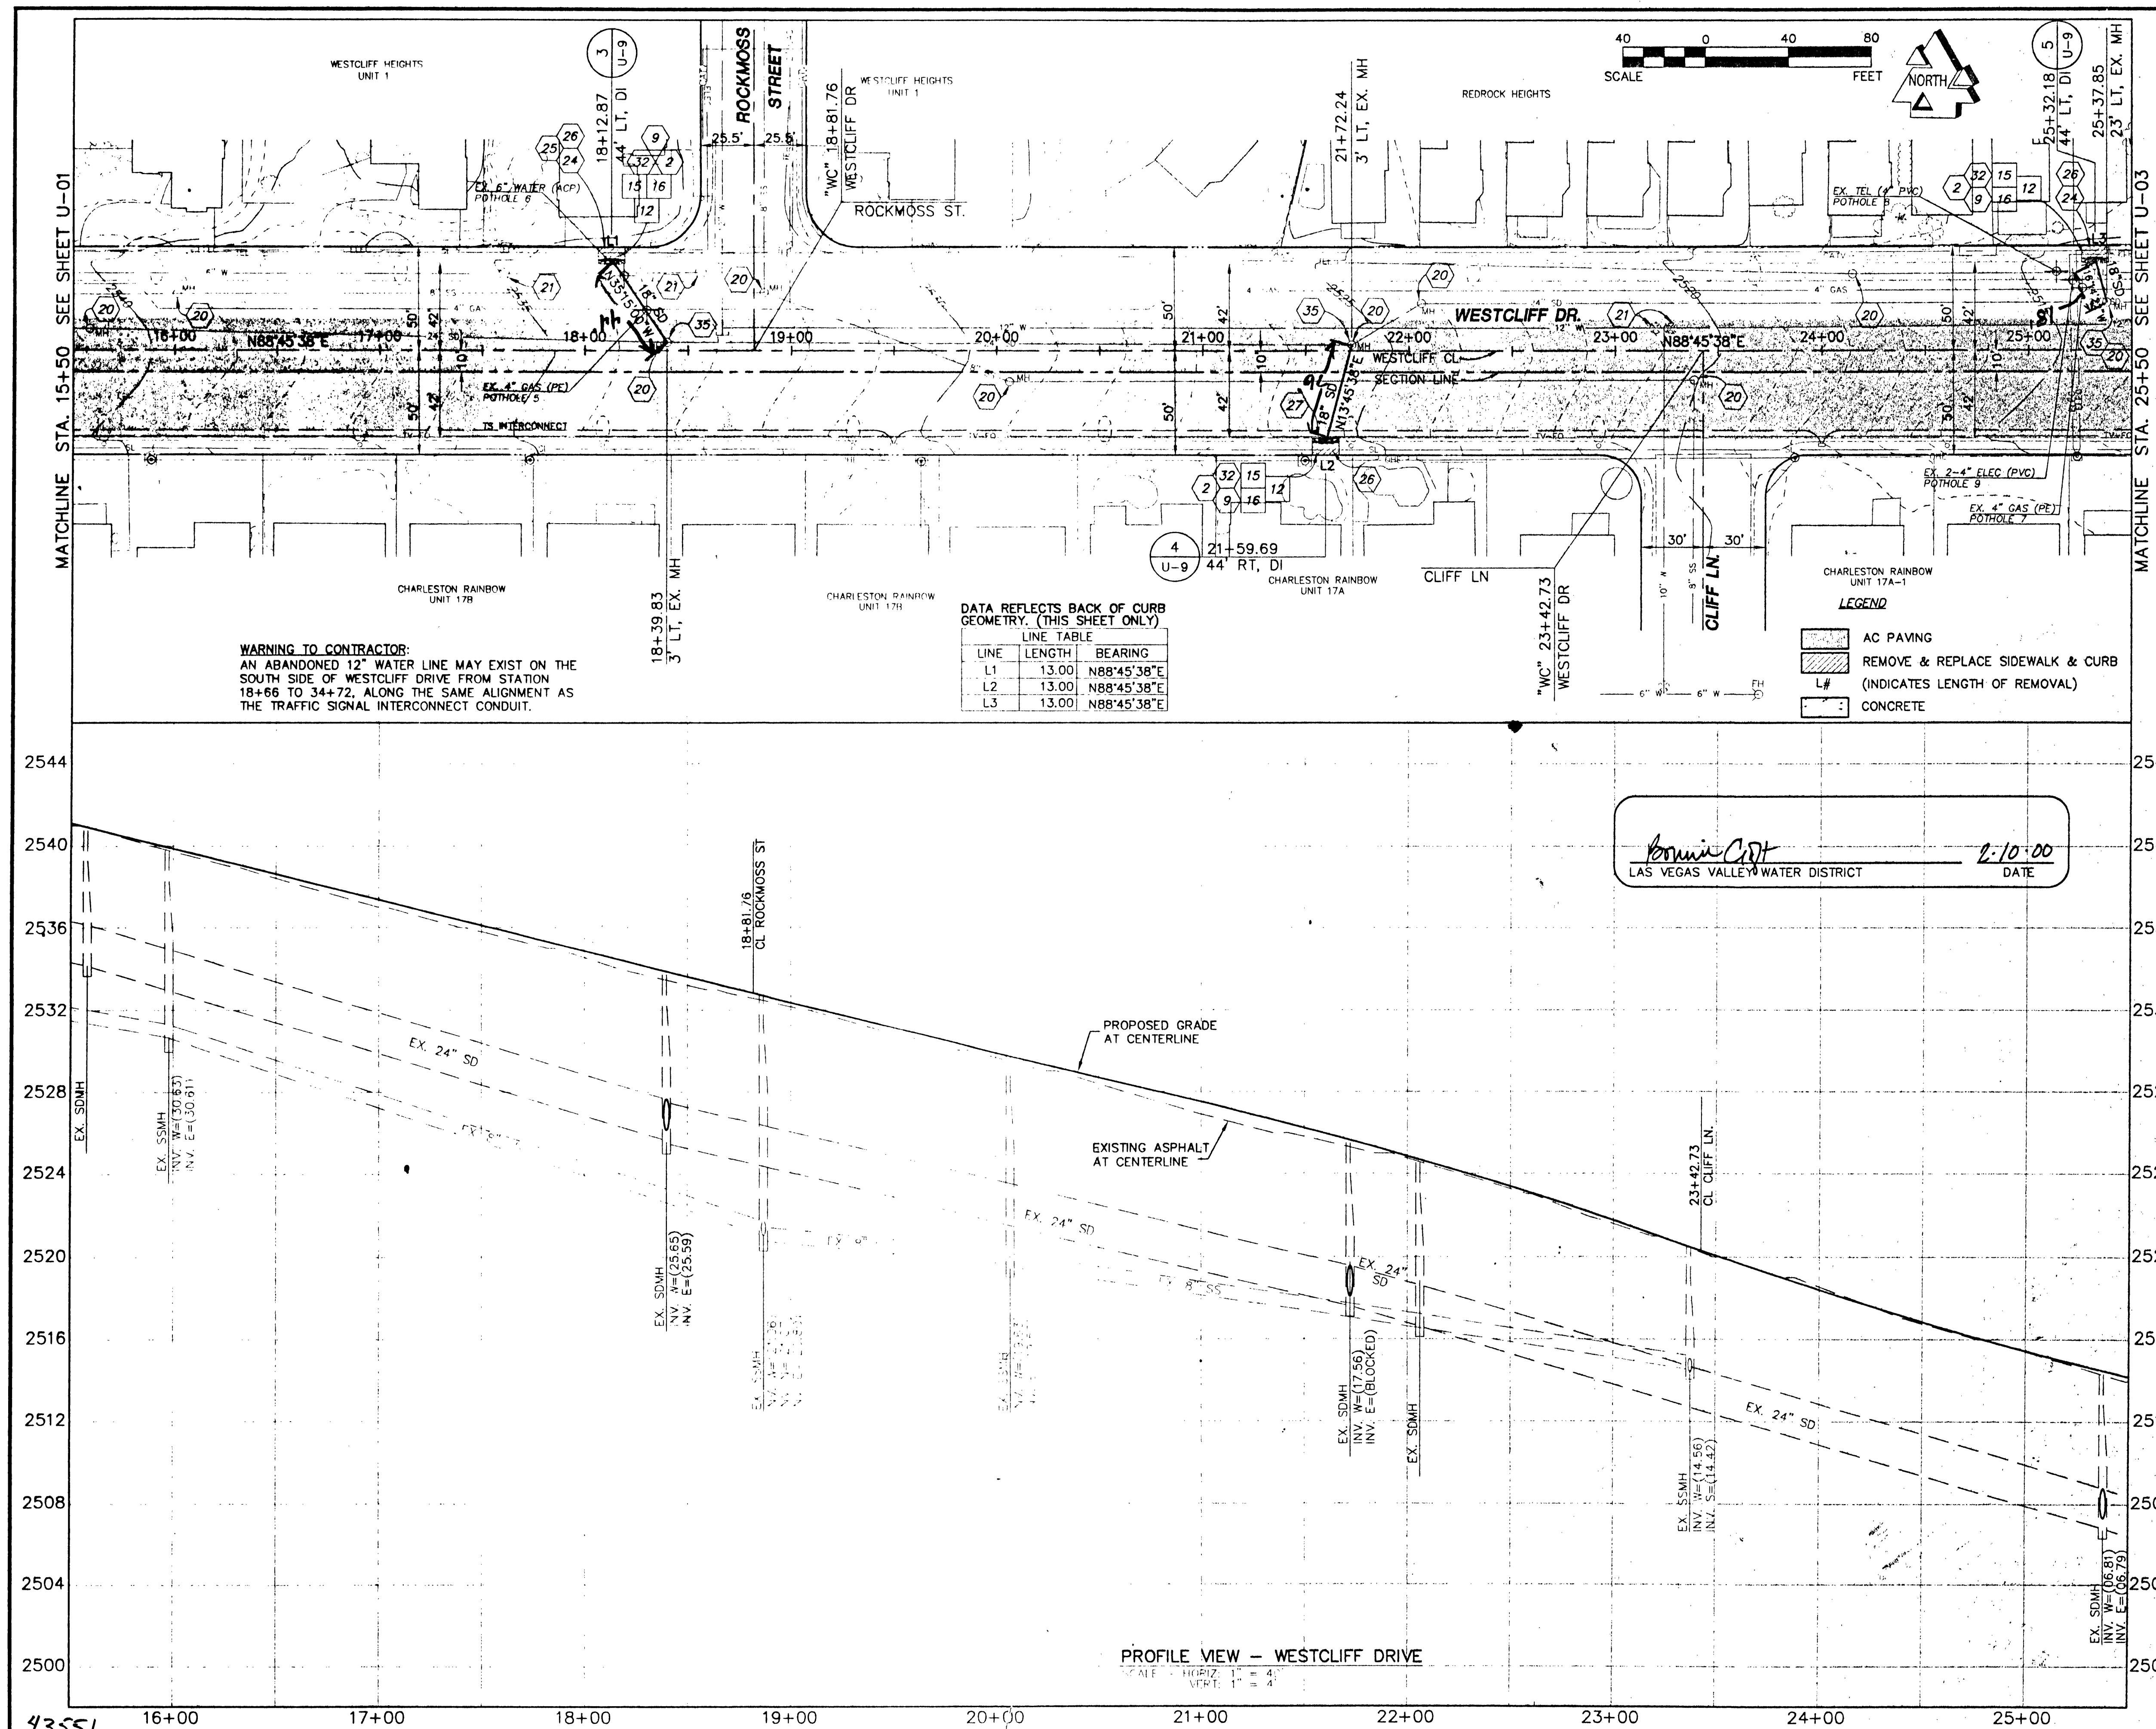

- CONSTRUCTION NOTES**
- USE STANDARD DRAWING REFERENCE SHOWN ON SHEET C-04
- (2) CONSTRUCT CONCRETE SIDEWALK
 - (4) CONSTRUCT "L" TYPE CURB & GUTTER
 - (9) CONSTRUCT GUTTER TRANSITION
- REMOVALS**
- (12) SAWCUT
 - (15) REMOVE CURB AND GUTTER
 - (16) REMOVE SIDEWALK
- RELOCATIONS**
- (20) ADJUST MANHOLE TO GRADE AND CONSTRUCT CONCRETE COLLAR
 - (21) ADJUST VALVE BOX TO GRADE
 - (22) ADJUST FIRE HYDRANT
 - (23) RELOCATE WATER LINE
 - (24) RELOCATE CONFLICTING ELECTRICAL CONDUIT
 - (25) RELOCATE CONFLICTING TELEPHONE CONDUIT
 - (26) RELOCATE CONFLICTING ST. LIGHT CONDUIT
 - (27) RELOCATE CONFLICTING CABLE TV CONDUIT
 - (28) RELOCATE GAS LINE
- STORM DRAIN/SEWER IMPROVEMENTS**
- (32) CONSTRUCT 6" TYPE "F" DROP INLET
 - (33) CONSTRUCT 18" TYPE "F" DROP INLET
 - (34) CONSTRUCT TYPE I MANHOLE, 60"
 - (35) MODIFY MANHOLE
 - (36) MODIFY DROP INLET

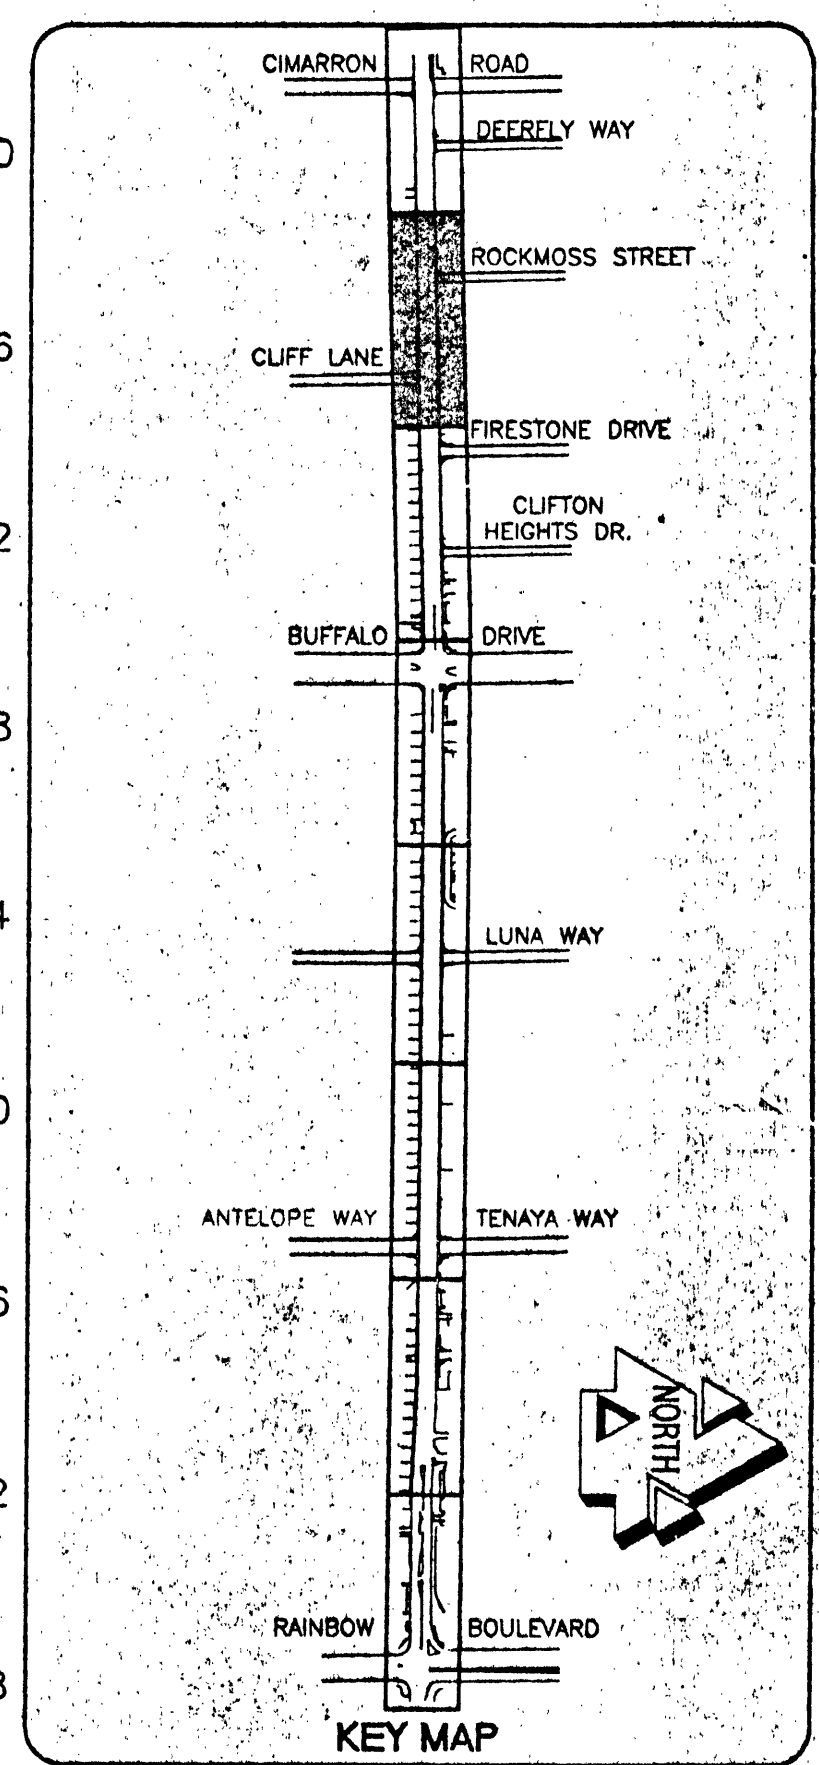

Call before you Dig
1-800-227-2600
UNDERGROUND SERVICE (USA)

CALL BEFORE YOU DO OVERHEAD
1-702-593-6111

PROJ NO: 99202
DESIGN: K.H./RAS
DATE: 02/10/00
SCALE: AS SHOWN
CADFILE: WC_U02

ACEP
3070 NORTH BUFFALO DRIVE, SUITE 106
LAS VEGAS, NEVADA 89129
TEL: (702) 398-3435, FAX: (702) 398-3758
EMAIL: admin@acep-lv.com

WESTCLIFF DRIVE IMPROVEMENTS
CIMARRON ROAD TO RAINBOW BLVD
UTILITY PLAN & PROFILE
15+50 TO 25+50

SHEET
U-02
25 OF 47 SHEETS
DRAWING NO.
107-V3099

SOUTHERN NEVADA PAVING, INC.
AS BUILT
DATE: 7/16/01