


WESTERN BELTWAY

FAR HILLS AVENUE


CURVE TABLE				
Curve #	Radius	Delta	Length	Tangent
①	1000.00	6° 27' 34"	112.74'	56.43'
②	1000.00	6° 00' 09"	104.76'	52.43'

- ① "F" 497+21.32
28.50' RT
CONSTRUCT CLARK COUNTY 48" SANITARY SEWER MH, H=4.59'
INSTALL 16" x 484.16 L.F. C900 SEWER PIPE
(SEE SHEET UT-2)
- ② "F" 502+05.01
29.96' RT
CONSTRUCT CLARK COUNTY 48" SANITARY SEWER MH, H=8.42'
CONNECT TO EXISTING 16" SEWER PIPE
(SEE SHEET UT-2)
- ③ "F" 498+33.87
22.98' RT
CONSTRUCT CLARK COUNTY 48" SANITARY SEWER MH, H=4.98'
CONNECT TO EXISTING 16" SEWER PIPE
(SEE SHEET UT-2)
- ④ "F" 501+00.53
22.98' RT
CONSTRUCT CLARK COUNTY 48" SANITARY SEWER MH, H=6.15'
CONNECT TO EXISTING 16" SEWER PIPE
(SEE SHEET UT-2)

REV. NO.	DATE	DESCRIPTION	APPROVED

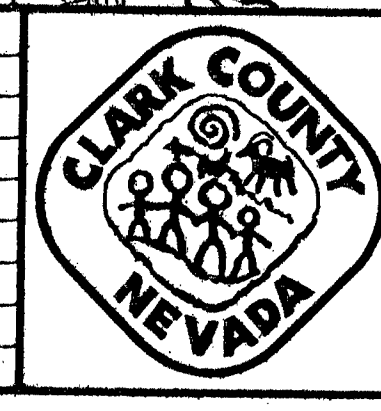

WESTERN BELTWAY-CHARLESTON TO SUMMERLIN
 UTILITY PLAN
 "WB" 364+00.00 TO "WB" 376+00.00
 CLARK COUNTY, NEVADA, DEPARTMENT OF PUBLIC WORKS

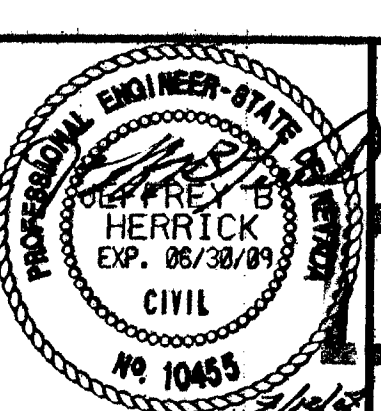

PROJECT NO. 64905
 DESIGNED BY: VK
 APPROVED BY: JPL
 DRAWN BY: JAM
 CHECKED BY: WBM
 DATE: 08/28/09
 CONSULTING ENGINEERS
 PLANNERS
 DESIGN SUPPLY FOR
 772 S. RANNEY BLVD.
 LAS VEGAS, NV 89104
 FAX (702) 382-2597

SCALE
 HORIZ: 1"=40'
 VERT: NONE
 FIELD BOOK
L-1817
 DRAWING NO.
 307 V795
 U-23
 SHT. OF

AS BUILT DRAWINGS

SUMMERLIN PARKWAY @ WESTERN BELTWAY