


"F" 497+21.32 TO "F" 502+05.01  
STRUCTURE LINE


# AS BUILT DRAWINGS

REV. NO. DATE DESCRIPTION APPROVED

REV. NO.	DATE	DESCRIPTION	APPROVED
124	6/15		

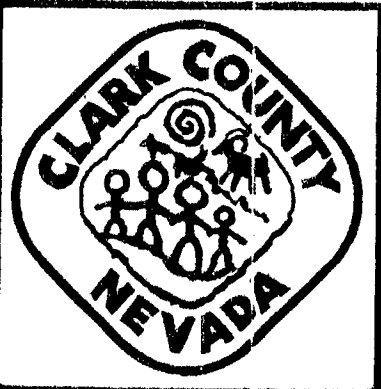

**WESTERN BELTWAY-CHARLESTON TO SUMMERLIN**  
SEWER PROFILE  
"F" 502+05.01 TO "F" 497+21.32  
CLARK COUNTY, NEVADA, DEPARTMENT OF PUBLIC WORKS

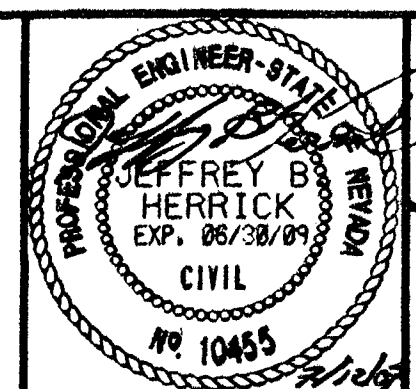

PROJECT No: 645905 DRAWN BY: JAM  
DESIGNED BY: VK, WBM CHECKED BY: JPL  
APPROVED BY: KDG DATE: \_\_\_\_\_  
CONSULTING ENGINEERS  
PLANNERS  
LAND SURVEYORS  
2727 S. RAINBOW BLVD.  
LAS VEGAS, NEVADA 89146  
PHONE (702) 873-7550  
FAX (702) 362-2597

SCALE		DRAWING NO. 301V 795 U-24
HORIZ	1"=40'	
VERT	1"=4'	
FIELD BOOK		
SHT.	OF	

ISSUE FOR CONSTRUCTION