


PROPOSED FUTURE DEVELOPMENT - OWENS AVE GRADE CROSSING - CIV. DWS. NO. 07-136

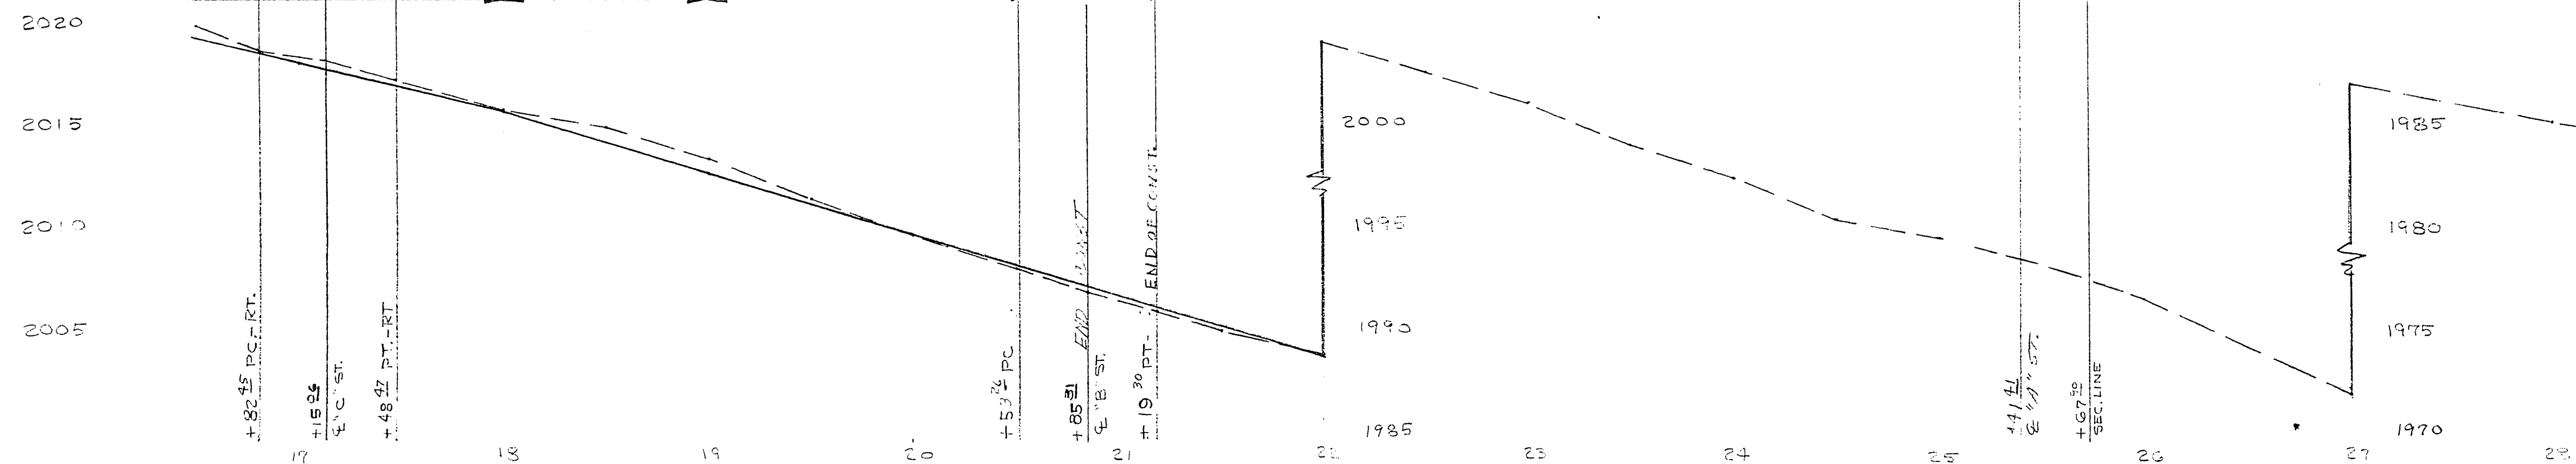

FINAL QUANTITIES			
ITEM	DESCRIPTION	AMOUNT	UNIT
1.	Excavation	4380 ⁸⁸	Cu. Yds.
2.	2" A.C. Paving	3665 ⁸⁷	Sq. Yd.
2-A.	2 1/2" A.C. Paving	NONE	Sq. Yd.
3.	1" Type C&G	3658 ⁸⁷	Lin. Ft.
4.	Alley Curb	NONE	Lin. Ft.
5.	Valley Gutters	1755 ⁸⁷	Sq. Ft.
6.	Alley Gutters	NONE	Sq. Ft.
7.	Remove 2" Alley Gutters	NONE	Sq. Ft.
8.	Remove Curb & Gutter	NONE	Lin. Ft.
9.	Adjust Manholes	7	EACH
10.	Replace 2" Alley Curb	NONE	EACH
11.	Redwood Header	41	Lin. Ft.
12.	Remove Trees 4" to 10" DIA.	2	EACH
13.	Remove Trees over 10" DIA.	10	EACH
14.	Construct Sidewalk	NONE	Sq. Ft.
17.	TYPE I AGGREGATE	4380 ⁸⁸	CU. YDS.

TYPE I AGGREGATE 8' FROM HTO A

AS BUILT

REVISIONS			
BY	CHANGE IN "A" ST. ALIGNMENT	CHK'D	DATE
K.C.		W/A	3-1-56
BY	"AS-BUILT" CHANGE S/E COR. "B" & OWENS		4-3-57

CITY OF LAS VEGAS, NEVADA
ENGINEERING DEPT.

WESTSIDE PAVING PROJECT
OWENS AVE. (H" ST. TO "B" ST.)

DESIGNED BY	DATE	SCALE	VERT. 1" = 50'
AWN BY Ales	3-9-56	HOR. 1" = 50'	
CHECKED BY	DATE	FIELD BOOK NO.	65-118 X
APPROVED	DATE	WORK ORDER NO.	1103
TY ENGR.		DRAWING NO.	107 D.10