


AS BUILT

CITY OF LAS VEGAS, NEVADA
ENGINEERING DEPT.

WESTSIDE PAVING PROJECT
"G" ST. BONANZA TO HARRISON

| | | |
|---------------------------------|----------------------|---------------------------------------|
| DESIGNED BY K. CRAWFORD | DATE 8-5-53 | SCALE 1/2" = 50' HORIZ. 1" = 5' VERT. |
| DRAWN BY L. H. | FIELD BOOK NO. 55-4X | WORK ORDER NO. 1103 |
| CHECKED BY [Signature] | DRAWING NO. | |
| APPROVED CITY ENGR. [Signature] | 107 D. 10 | |

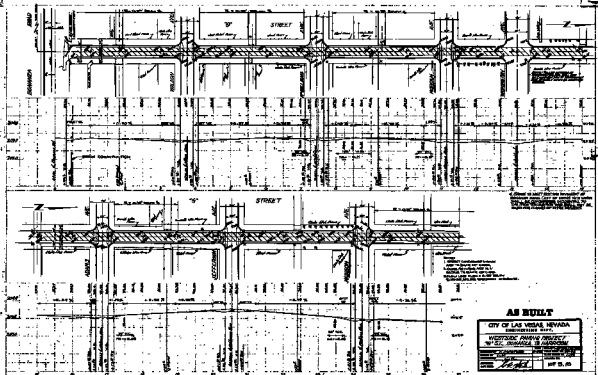

Notes:
 1. All work to be in accordance with the specifications for the project.
 2. All materials to be of the highest quality.
 3. All work to be completed within the specified time frame.

Notes:
 1. All work to be in accordance with the specifications for the project.
 2. All materials to be of the highest quality.
 3. All work to be completed within the specified time frame.

AS BUILT

| | |
|---------------------------|-------------|
| CITY OF LAS VEGAS, NEVADA | |
| ENGINEERING DIV. | |
| WESTSIDE PARKING PROJECT | |
| 10' ST. STORAGE & GARAGE | |
| DATE | 10/15/80 |
| BY | [Signature] |