

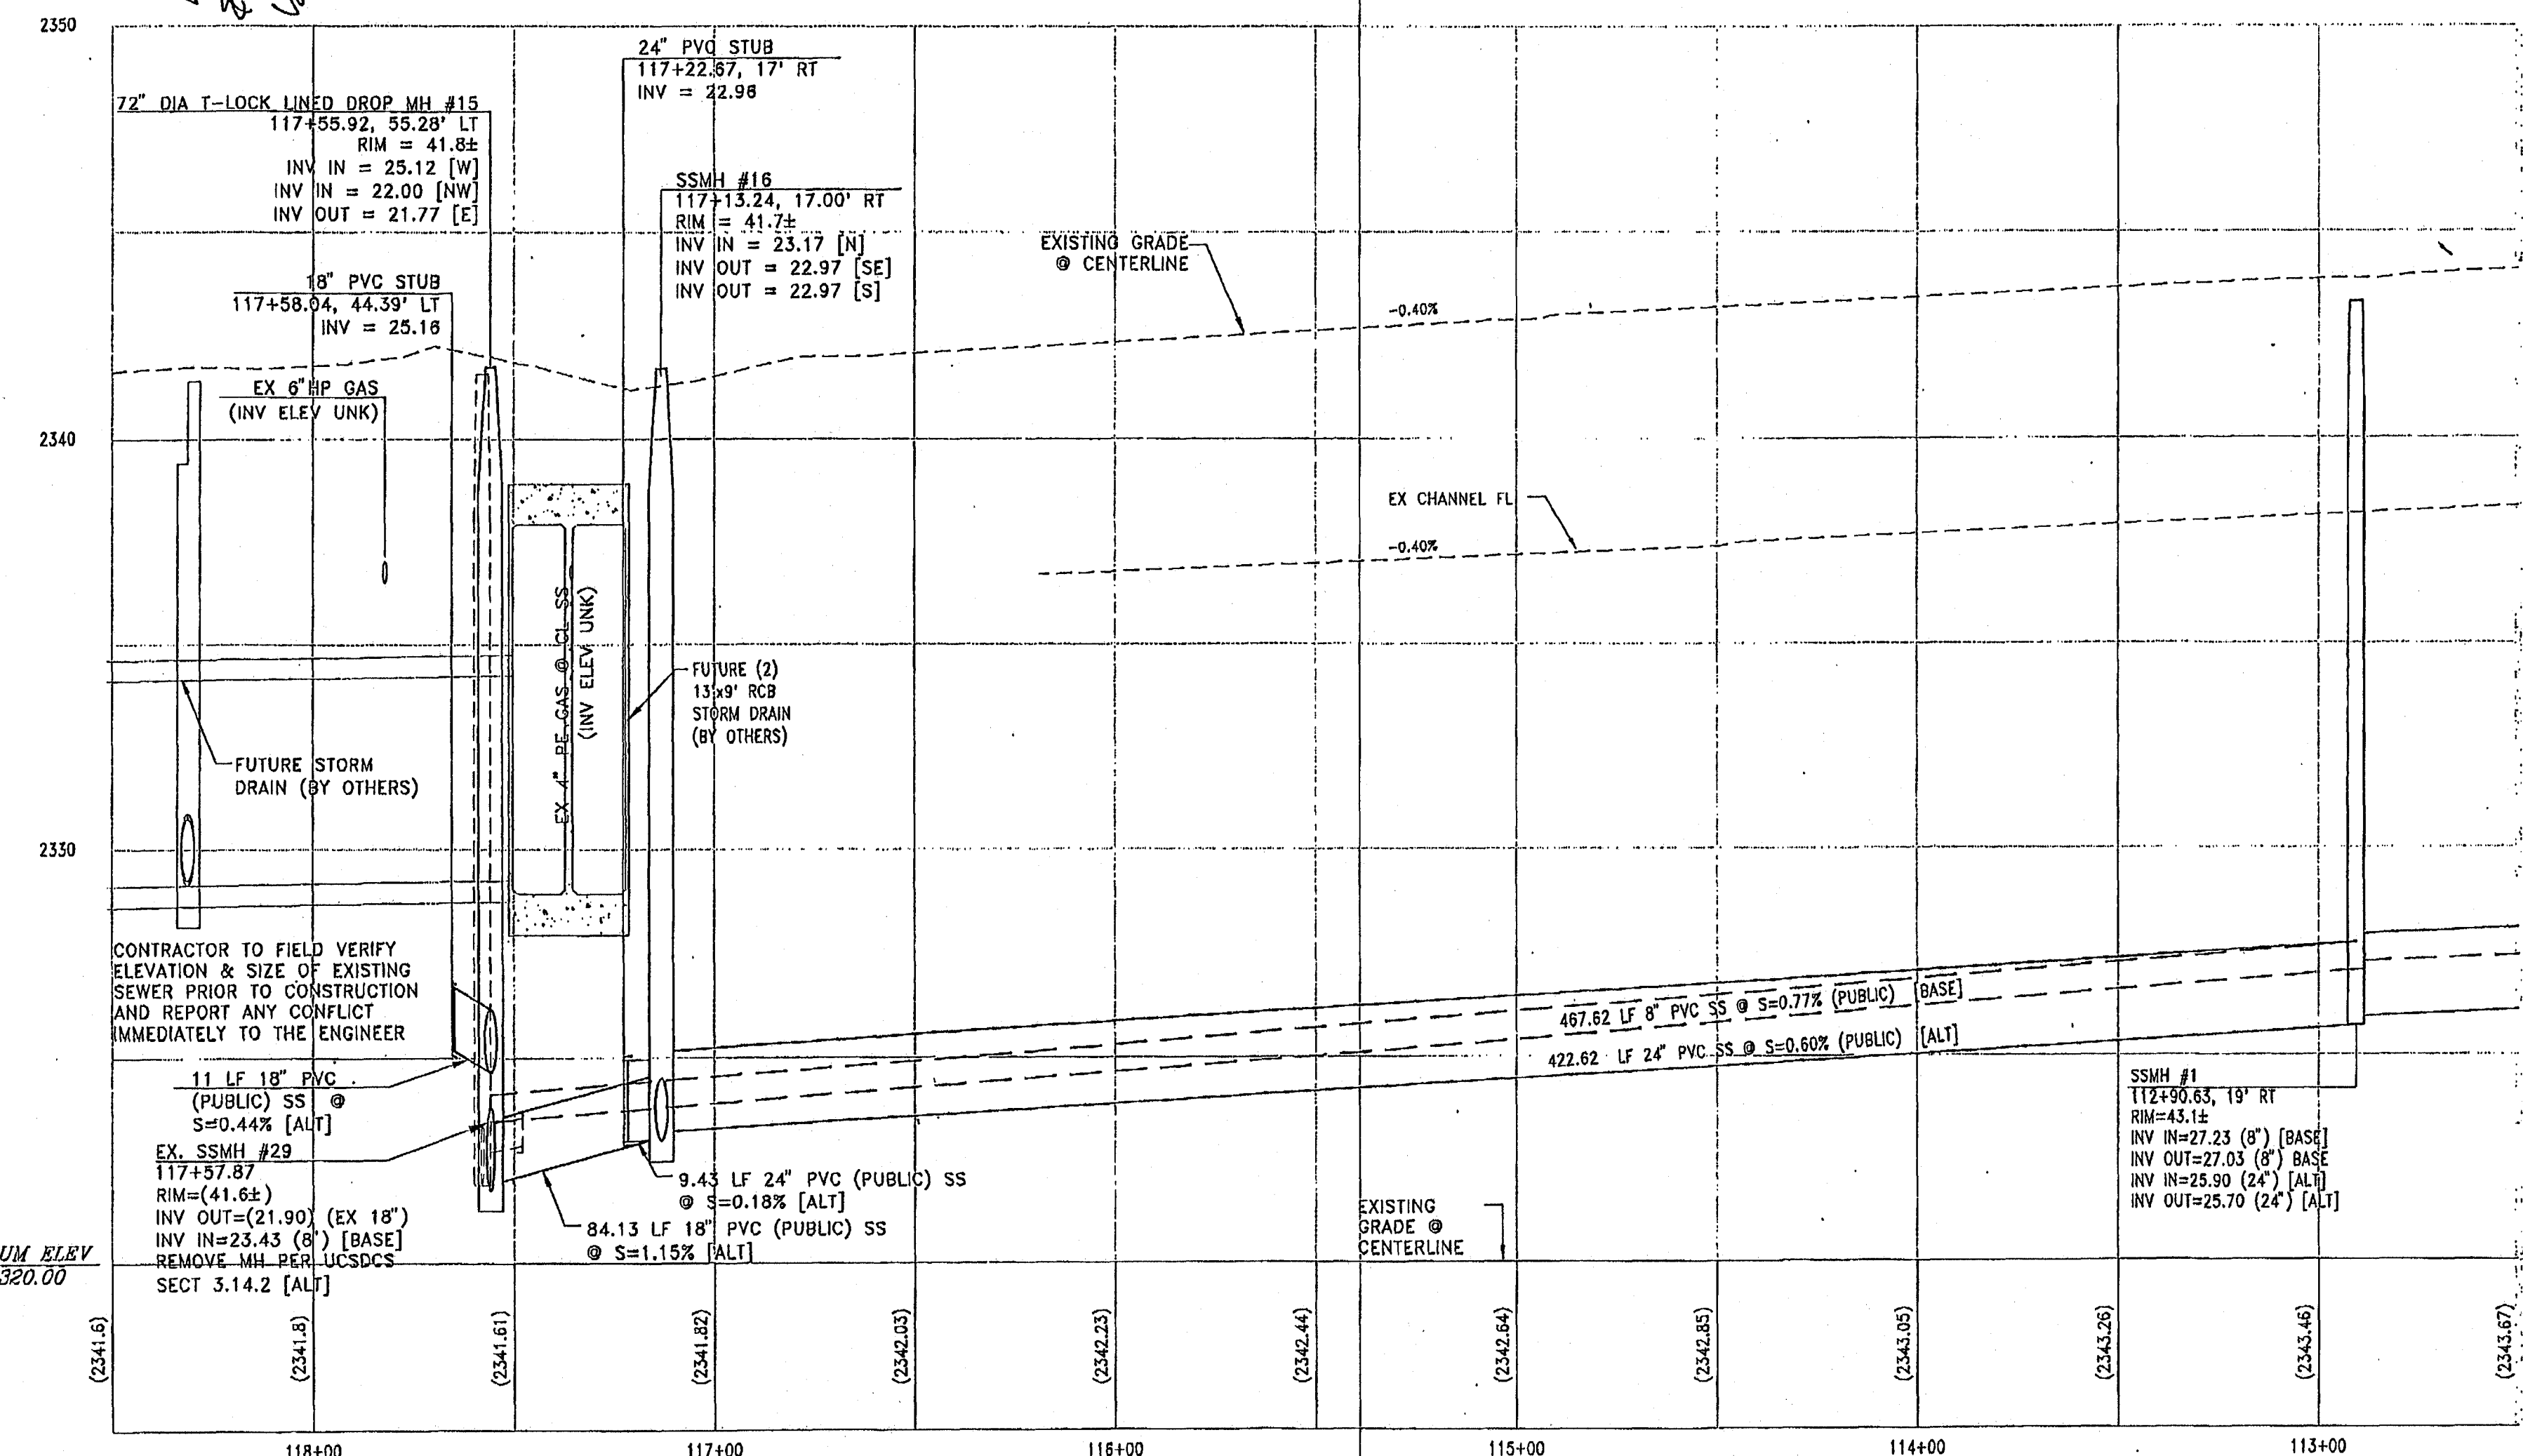


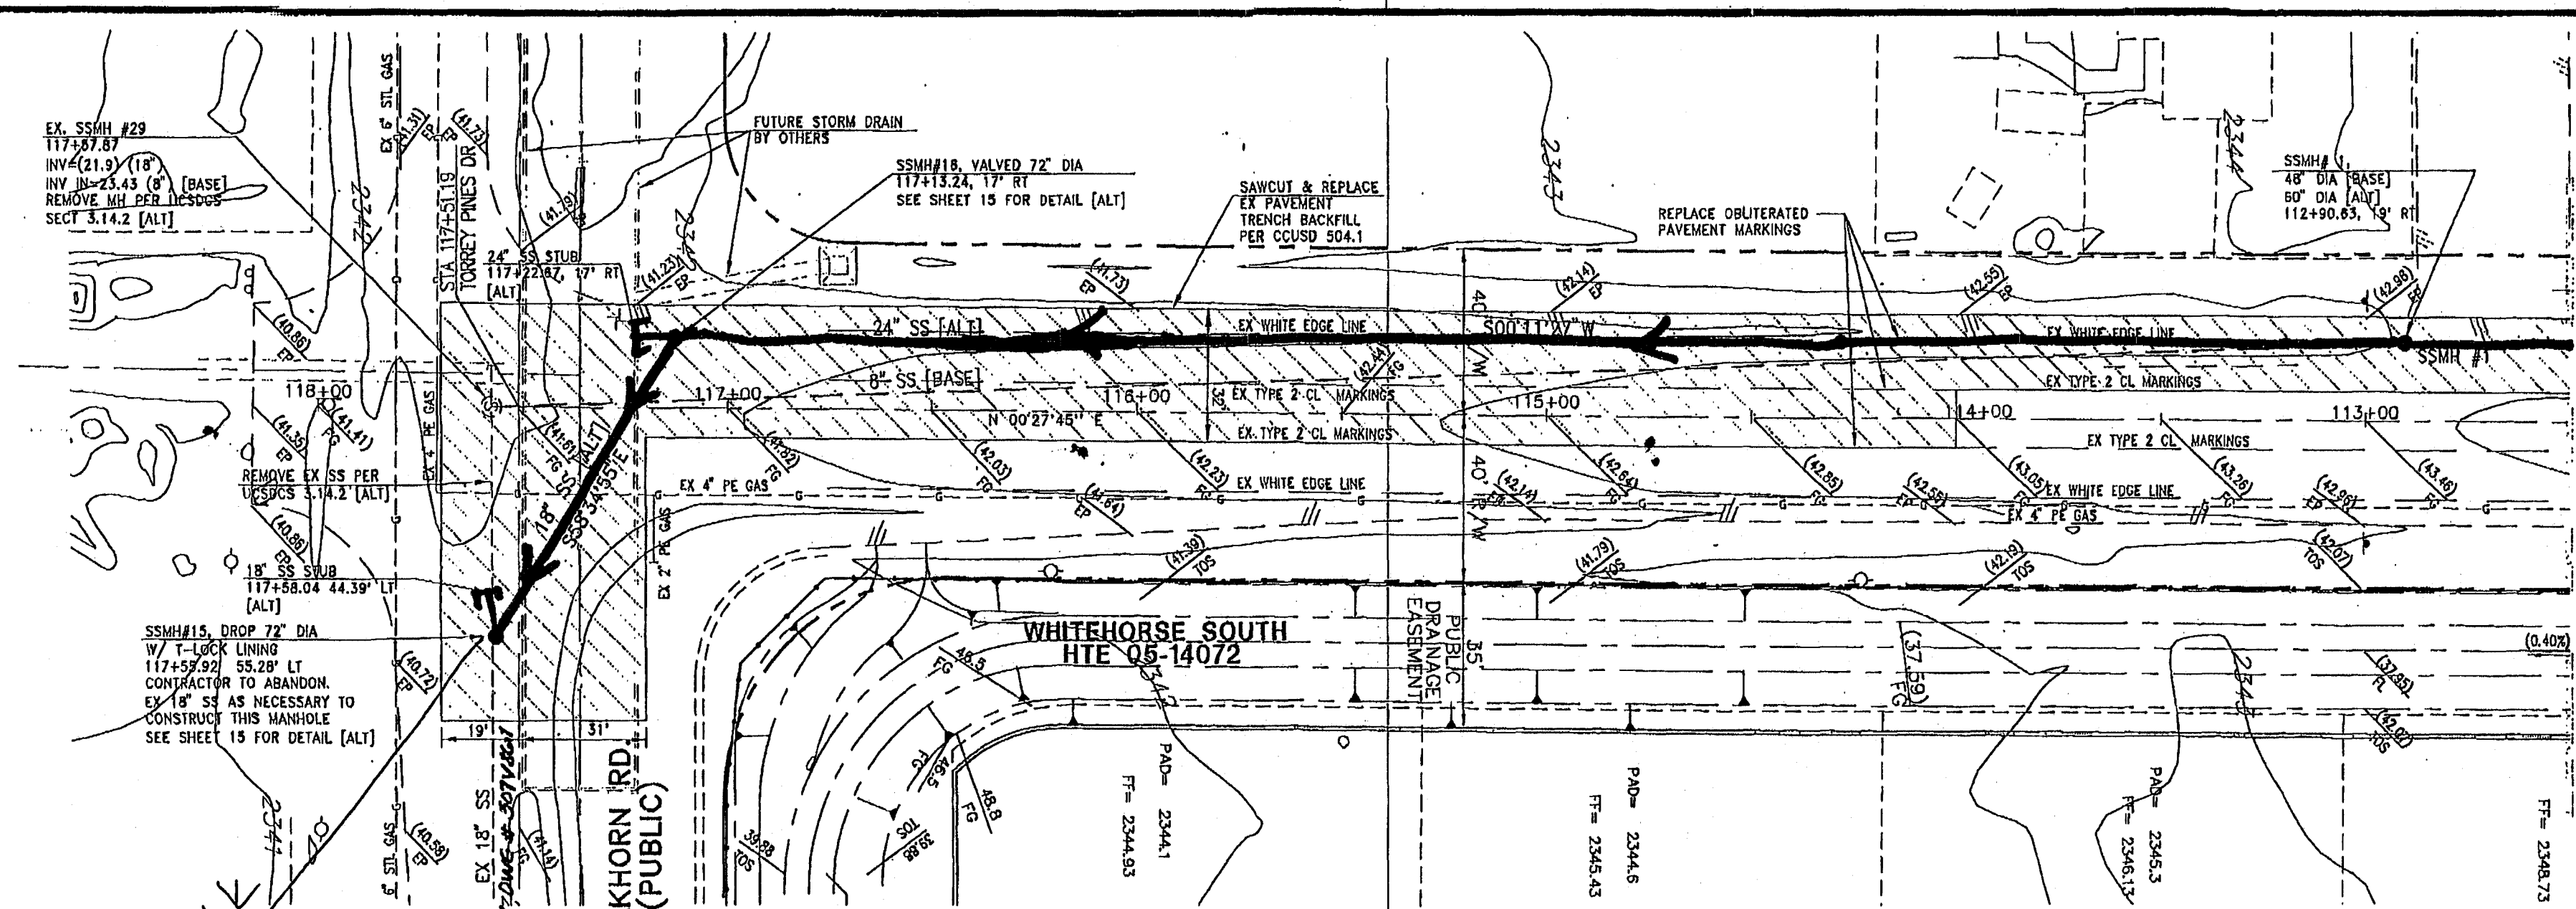

SEE SHEET 9 TORREY PINES DRIVE
STA: 112+50.00

FOR CONTINUATION OF TORREY PINES DRIVE
SEE SHEET 9 STA: 112+50.00

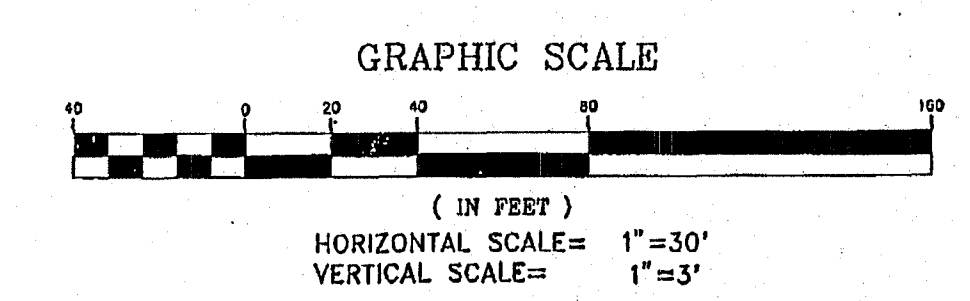

NOTES

- SEE SHEET 2 FOR LEGEND
- SEE SHEET 5 FOR UTILITY CONSTRUCTION NOTES
- SEE SHEET 3 FOR GRADING CONSTRUCTION NOTES

LEGAL DESCRIPTION

THE NORTHEAST QUARTER (NE 1/4) OF THE SOUTHEAST QUARTER (SE 1/4) OF SECTION 14, TOWNSHIP 13 SOUTH, RANGE 60 EAST, HON. CLARK COUNTY, NEVADA, AS SHOWN ON THAT CERTAIN MAP ON FILE IN THE CLARK COUNTY RECORDER'S OFFICE.

BASIS OF BEARING

NORTH 89°38'01\"/>

BENCHMARK

CITY OF LAS VEGAS BENCHMARK 9LV90 14C4

A RIVET AND PLATE IN A CONCRETE PAD (POWER) AT THE SOUTHWEST CORNER OF FARM ROAD AND TORREY PINES DRIVE.

ELEVATION=717.2224 METERS (NAVD'88)
ELEVATION=2353.09 U.S. SURVEY FEET (NAVD'88)

APPROVAL

CLARK COUNTY DEPARTMENT OF DEVELOPMENT SERVICES
ACCEPTANCE OF PLANS FOR FILING

By: *May 2007*

ACCEPTANCE OF THESE PLANS FOR FILING SHALL NOT BE CONSTRUED TO BE A PERMIT FOR OR AN APPROVAL OF ANY VIOLATION OF ANY OF THE PROVISIONS OF THE STATE OR COUNTY LAWS AND/OR SPECIFICATIONS. CLARK COUNTY SHALL BE HELD FREE FROM DAMAGES WHICH MAY RESULT FROM THE CONSTRUCTION OF THE IMPROVEMENTS FROM THE ENGINEERING DESIGN DEPICTED HEREIN.

NOTE: POWER POLES AND/OR OTHER EXISTING FACILITIES NOT IN THEIR PROPER LOCATION BASED UPON PROPOSED IMPROVEMENTS SHOWN HEREON, WILL BE RELOCATED AT NO EXPENSE TO CLARK COUNTY.

DATE	SCALE	H: T=50'	V: V=5'
MARCH 2007			
DRAWN BY: NSA			
DESIGNED BY: NSA			
CHECKED BY: RPS			
ENGR. INT.			
COUNTY APPROVED			

WOOD RODGERS	IMPROVEMENT PLANS FOR
WHITEHORSE WEST	
STREET/SEWER PLAN & PROFILE	
TORREY PINES STA. 112+50 TO STA. 118+50	
CLARK COUNTY	

PROJECT NO. 1881.001	DRAWING 10
SHT 10 OF 15	

Call before you Dig

1-800-227-2600

CLARK COUNTY PUBLIC UTILITIES DEPARTMENT

Call before you OVERHEAD

1-702-227-2929

CLARK COUNTY PUBLIC UTILITIES DEPARTMENT

TORREY PINES DRIVE
PUBLIC STREET

WOOD RODGERS

ENGINEER

RICHARD P. SENECA

DATE: 21 MAR 2007

HTE# 06-27984

GLV # 307V796

SEWER ASBUILT