
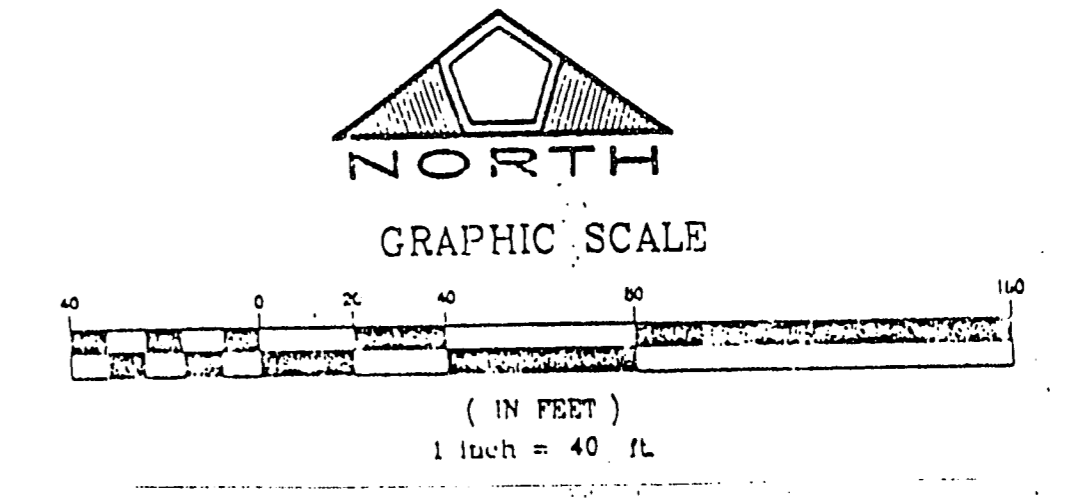


- FITTINGS LEGEND**
- 1 8" GATE VALVE
 - 2 8" 45° BEND
 - 3 8" 90° BEND
 - 4 8" TEE
 - 5 8"x8"x6" TEE
 - 6 STD. FIRE HYDRANT ASSEMBLY
 - 7 2" BLOW-OFF ASSEMBLY W/CAP
 - 8 8" 22 1/2° BEND
 - 9 12" X 8" TAPPING TEE

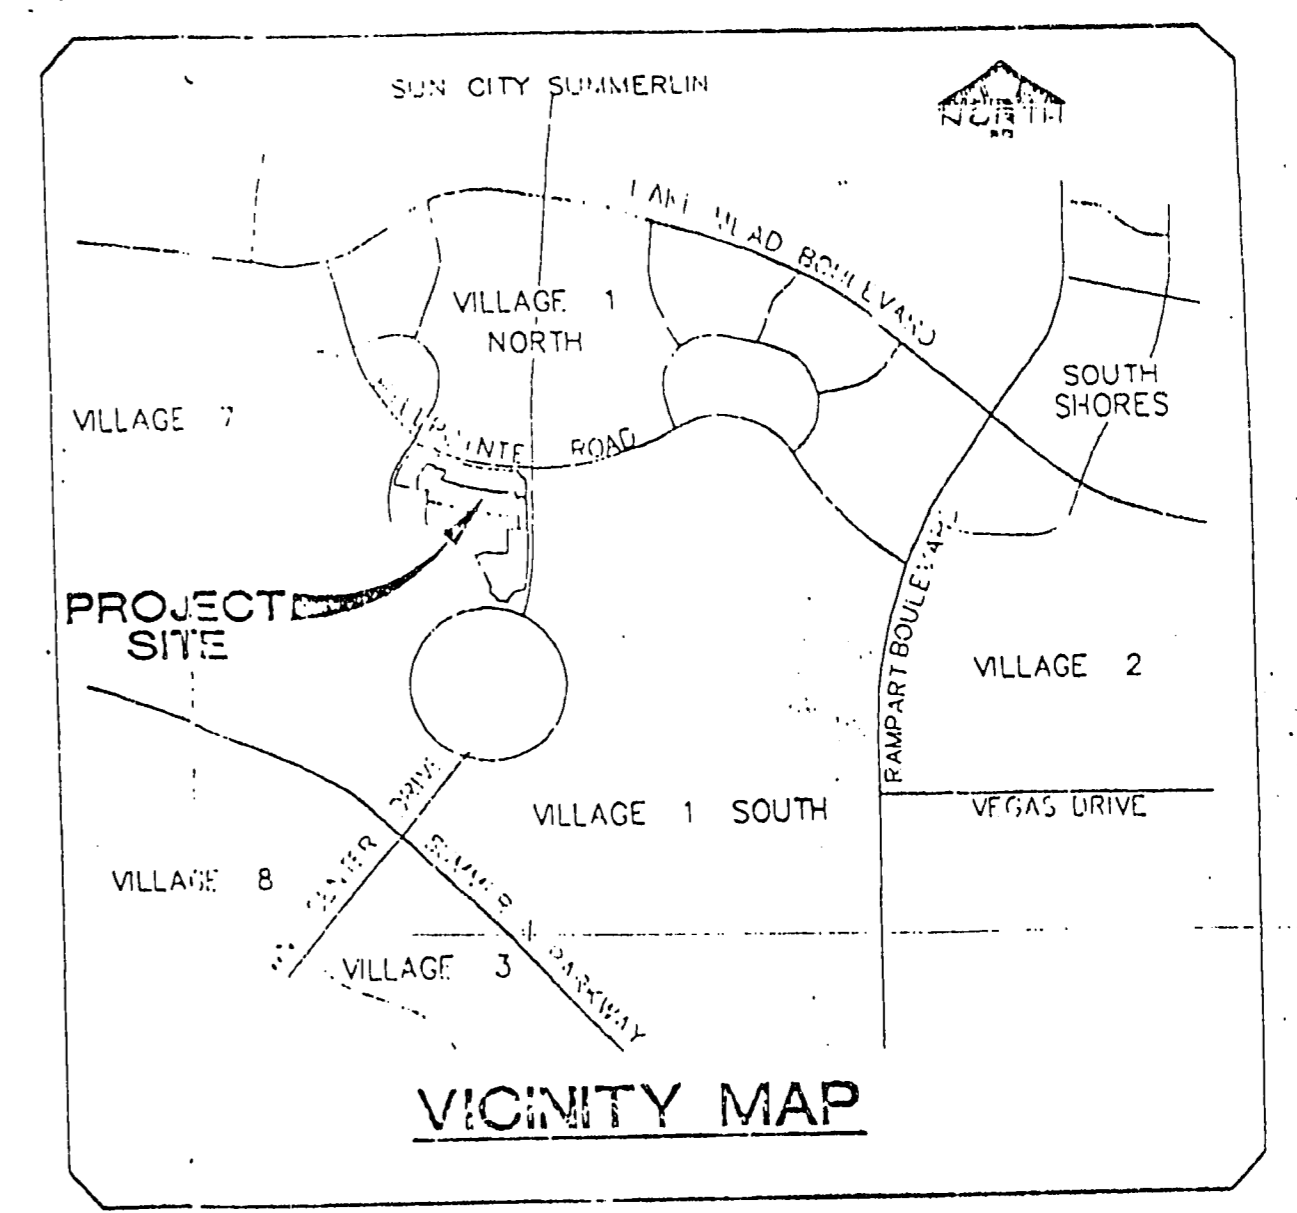

DATE	7/13/84
DESIGNED BY	RECOMMENDED
CHECKED BY	DATE
SCALE	NO. 1



PENTACORE
 Engineering, Inc.
 6753 West Charleston Boulevard
 Las Vegas, Nevada 89146

Avoid cutting underground utility lines. It's costly.
Call before you Dig.
 1-800-227-2600
 UNDERGROUND SERVICE ALERT (USA)

APPROVALS

LEWIS HOMES OF NEVADA	DATE
VEGAS-VALLEY-WATER-DISTRICT	DATE
CITY OF LAS VEGAS - FIRE MARSHALL	DATE
NEVADA POWER COMPANY	DATE

NOTE:
 THIS APPROVAL IS FOR THE PLACEMENT AND CLEARANCE OF STREET LIGHT AND SIGNAL LIGHT INSTALLATIONS ONLY.

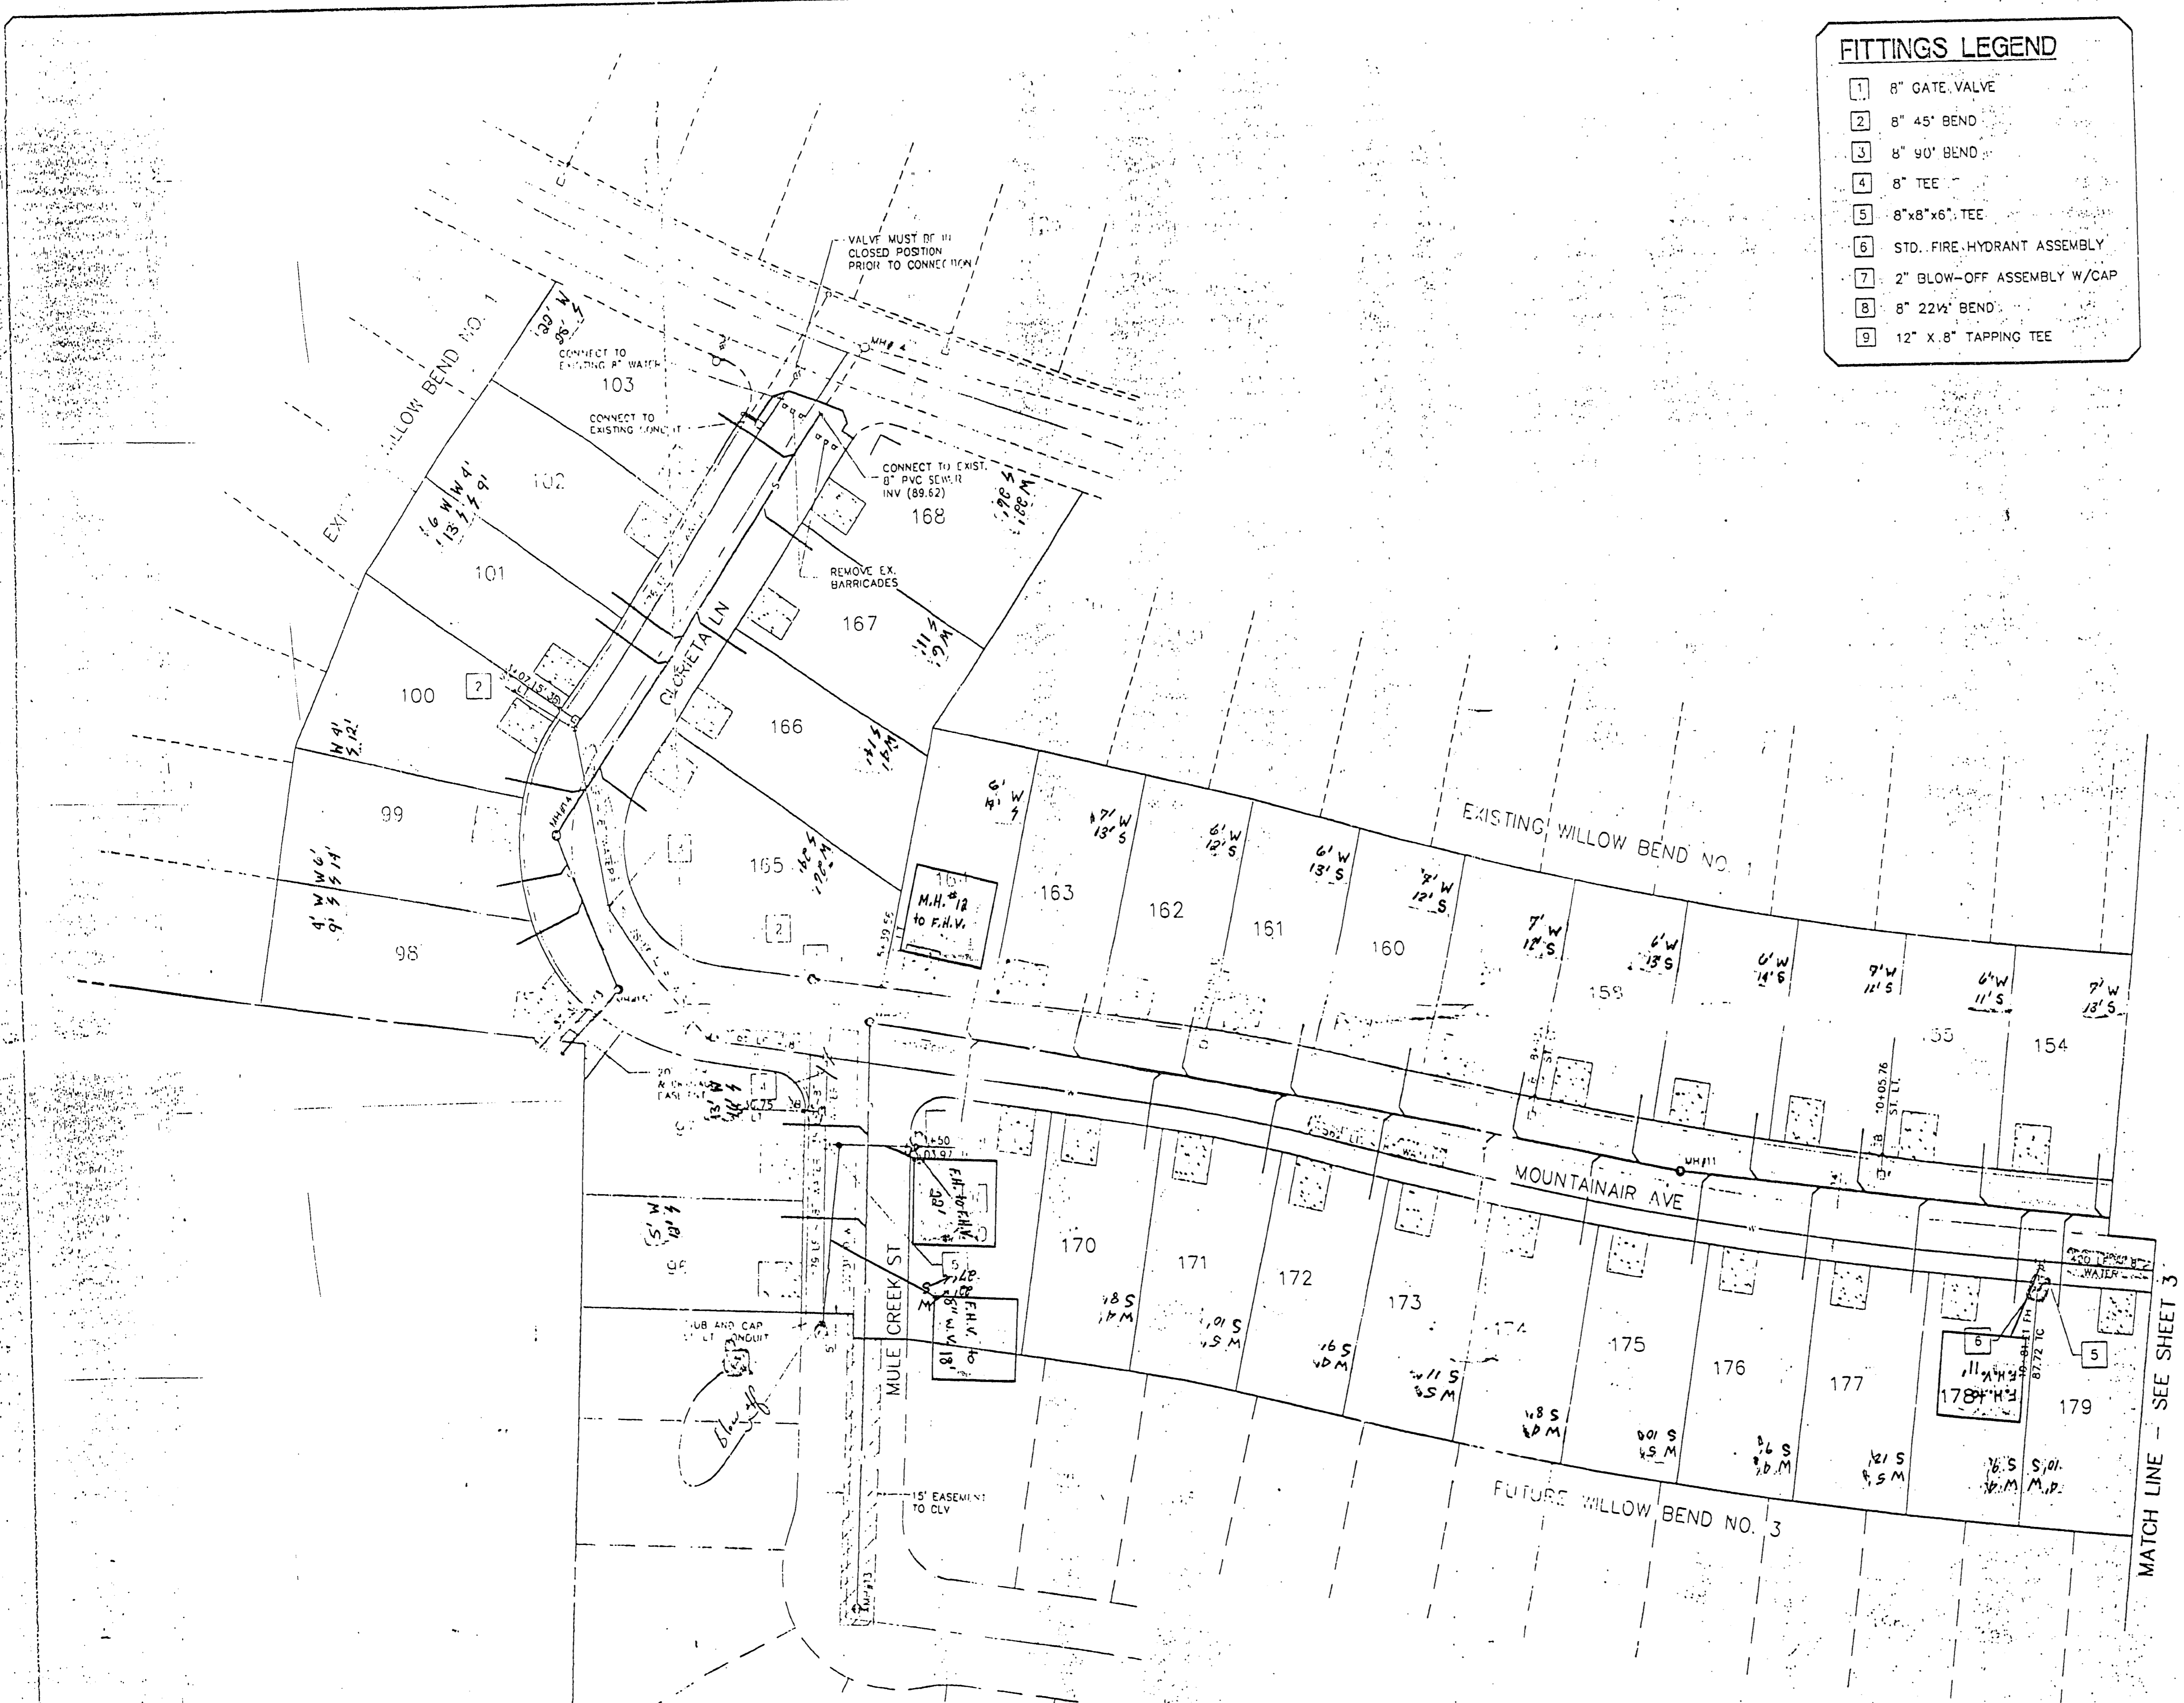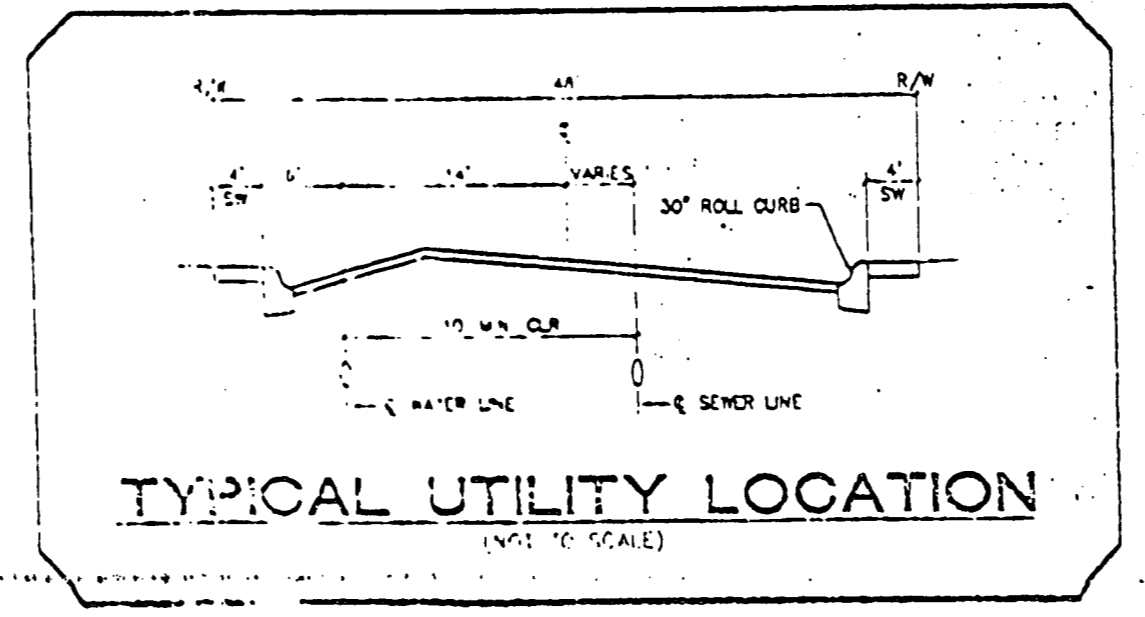

MATCH LINE - SEE SHEET 3

11-15-130 "As Built"

3074-4332-2