


**CONSTANTINOPLE AVENUE**  
NO SCALE  
STD. DWG 205

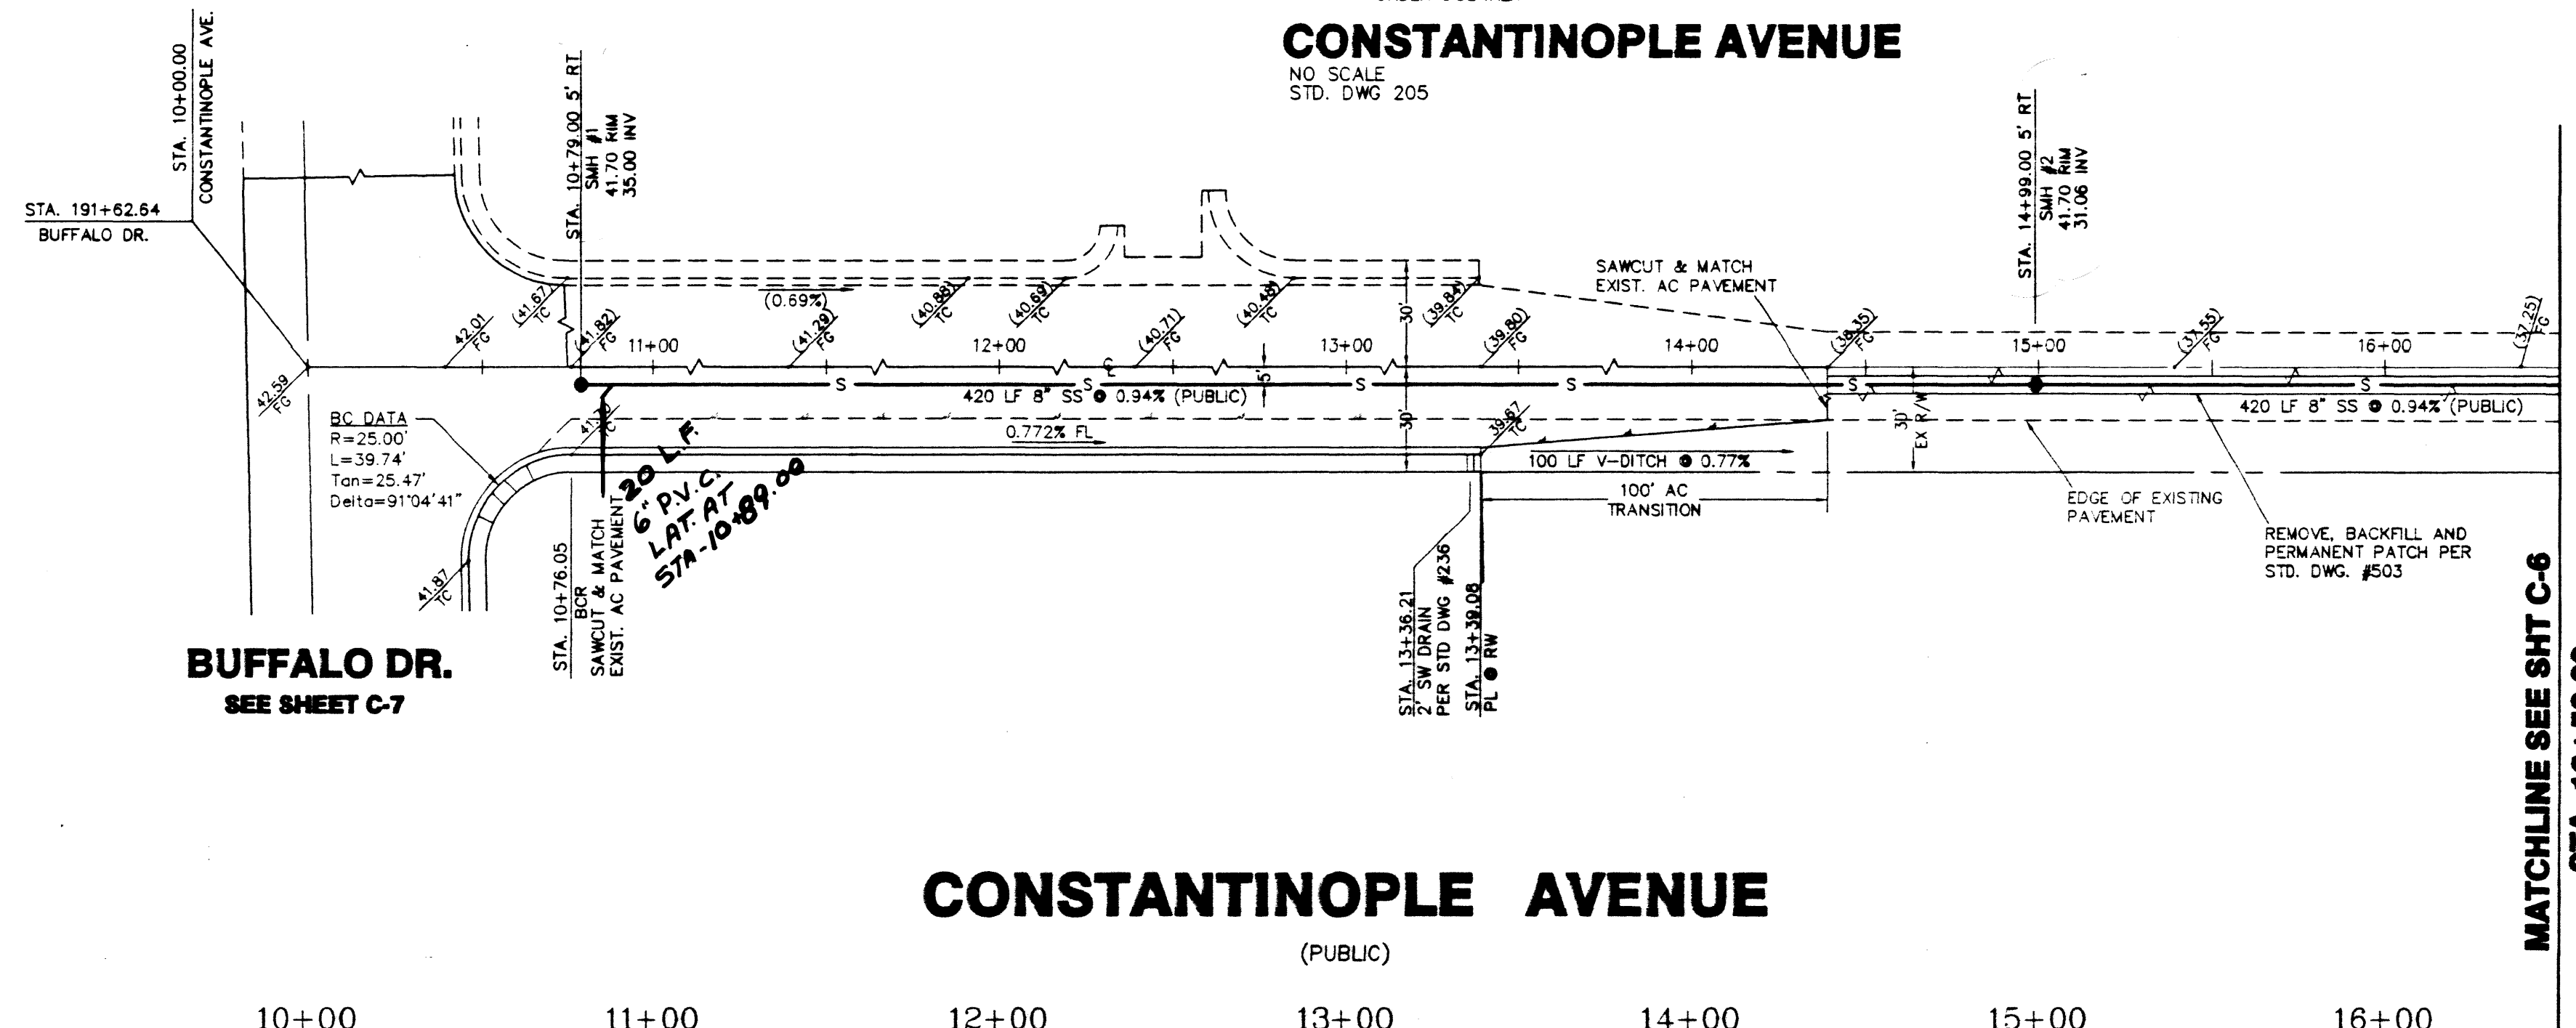


**CONSTANTINOPLE AVENUE**  
(PUBLIC)

	10+00	11+00	12+00	13+00	14+00	15+00	16+00	
2345								2345
2340								2340
2335								2340

	10+00	11+00	12+00	13+00	14+00	15+00	16+00	
2345								2345
2340								2340
2335								2335
2330								2330
2325								2325

**BENCHMARK**  
BASIS OF ELEVATION - C.L.V. B.M. #1LV00-354 BEING A RIVET AND PLATE IN TOP OF CURB, NORTHEAST RETURN OF ALEXANDER ROAD AND TENAYA WAY  
NAD83 ELEVATION = 708.526 METERS ( 2324.89 FEET )

**BASIS OF BEARINGS**  
NORTH 00°00'50" EAST BEING THE CL. OF BUFFALO DRIVE, ALSO BEING THE WEST LINE OF THE NW 1/4 OF THE NW 1/4 OF SEC. 10, T20S, R6E, M.D.M., PER FILE 70, PAGE 88 OF SURVEYS.

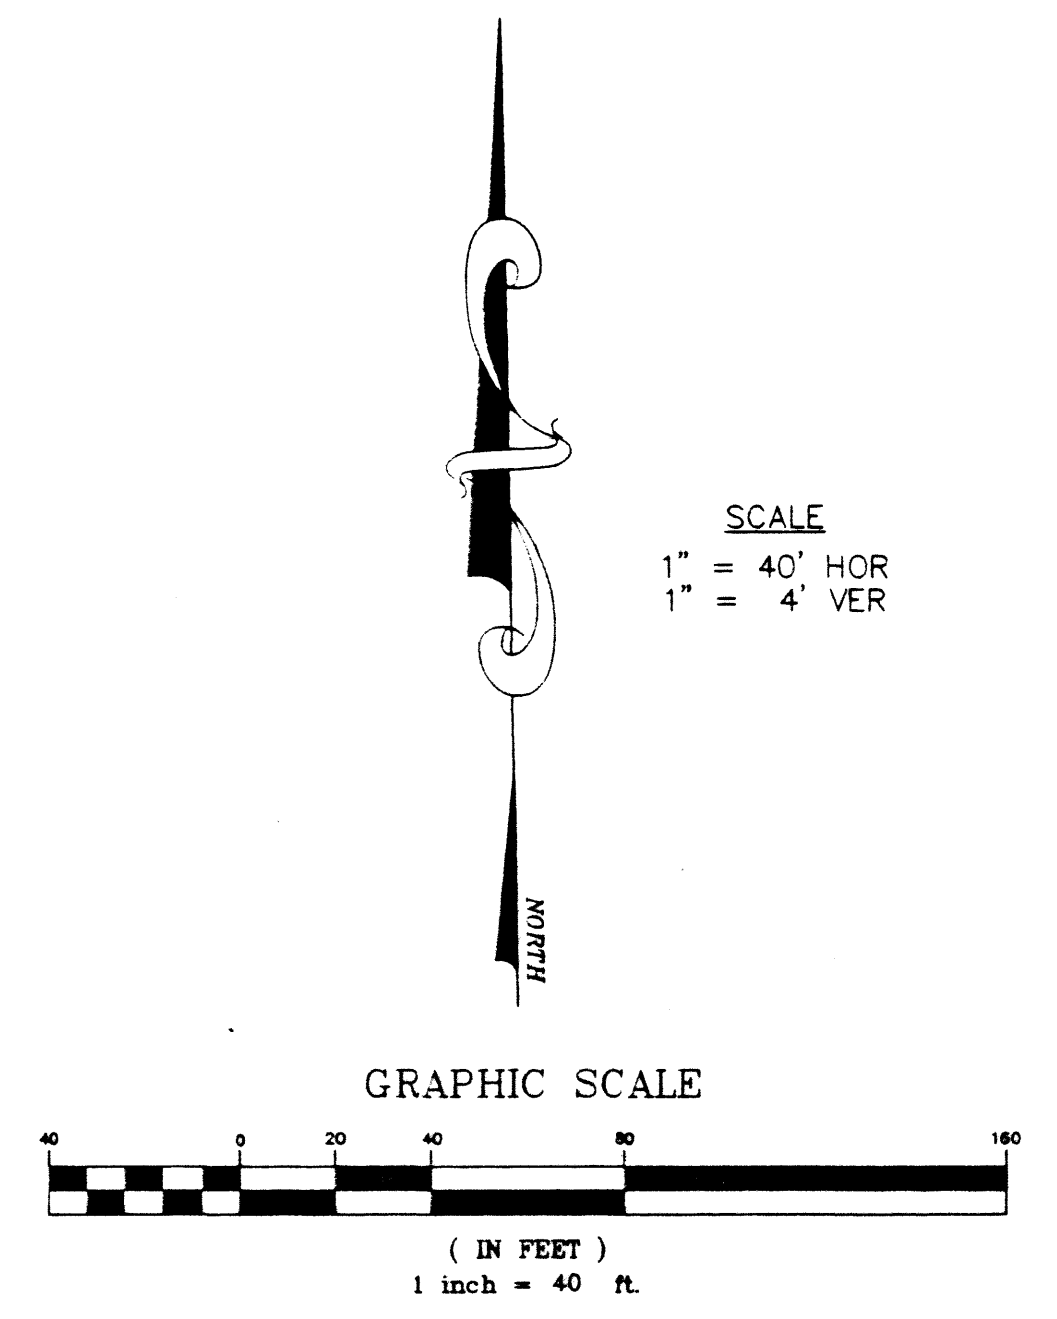

NO.	DATE	DESCRIPTION	BY

**ROBERT J. LANGAN ENGINEERING**  
3305 Spring Mountain Road - Ste. 91  
Las Vegas, Nevada 89102  
(702) 365-0146

A PROJECT OF  
**Don Herman Construction**  
TEL 365-5615  
FAX 365-5618

**PLAN AND PROFILE**  
WILLOW CREEK  
ASSISTED LIVING COMMUNITY  
(A.K.A. 'BUFFALO ROYALE')

DRAWN BY	RJL
DATE	6-14-99
NO. OF SHEETS	8
SHEET NO.	C-5



99.06.21.03

AS-BUILT 107-V3093