
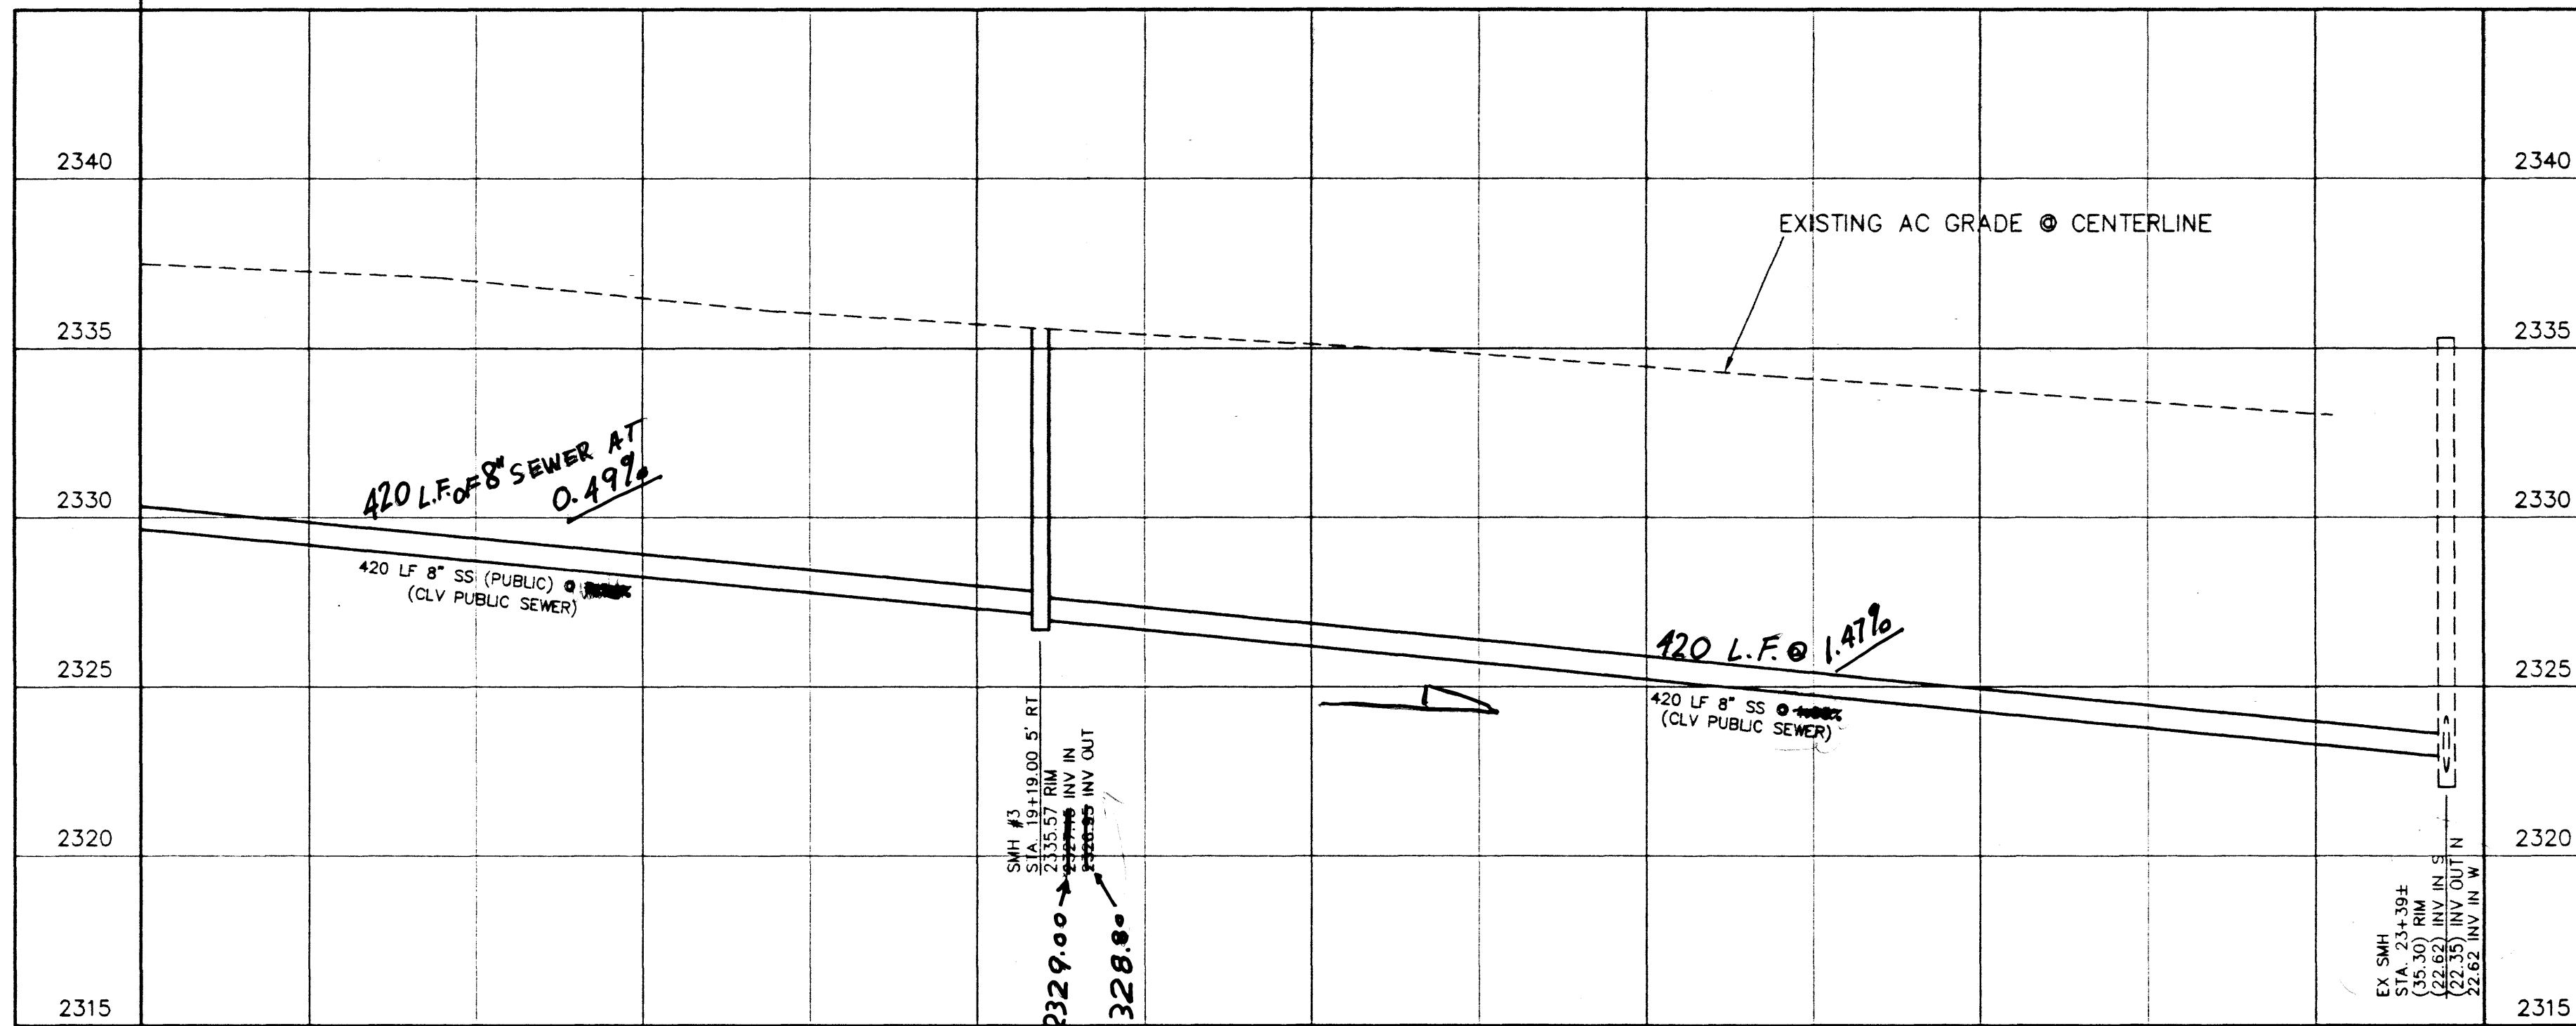


BENCHMARK

BASIS OF ELEVATION—CLV, B.M. #1700-354 BEING A RIVET AND PLATE IN TOP OF CURB, NORTHEAST RETURN OF ALEXANDER ROAD AND TENAYA WAY NAVD88 ELEVATION = 708.5266 METERS (2324.89 FEET)

BASIS OF BEARINGS

NORTH 00°00'50" EAST BEING THE CL OF BUFFALO DRIVE, ALSO BEING THE WEST LINE OF THE NW 1/4 OF THE NW 1/4 OF SEC. 10, T20S, R60E, M.D.M., PER FILE 70, PAGE 88 OF SURVEYS.

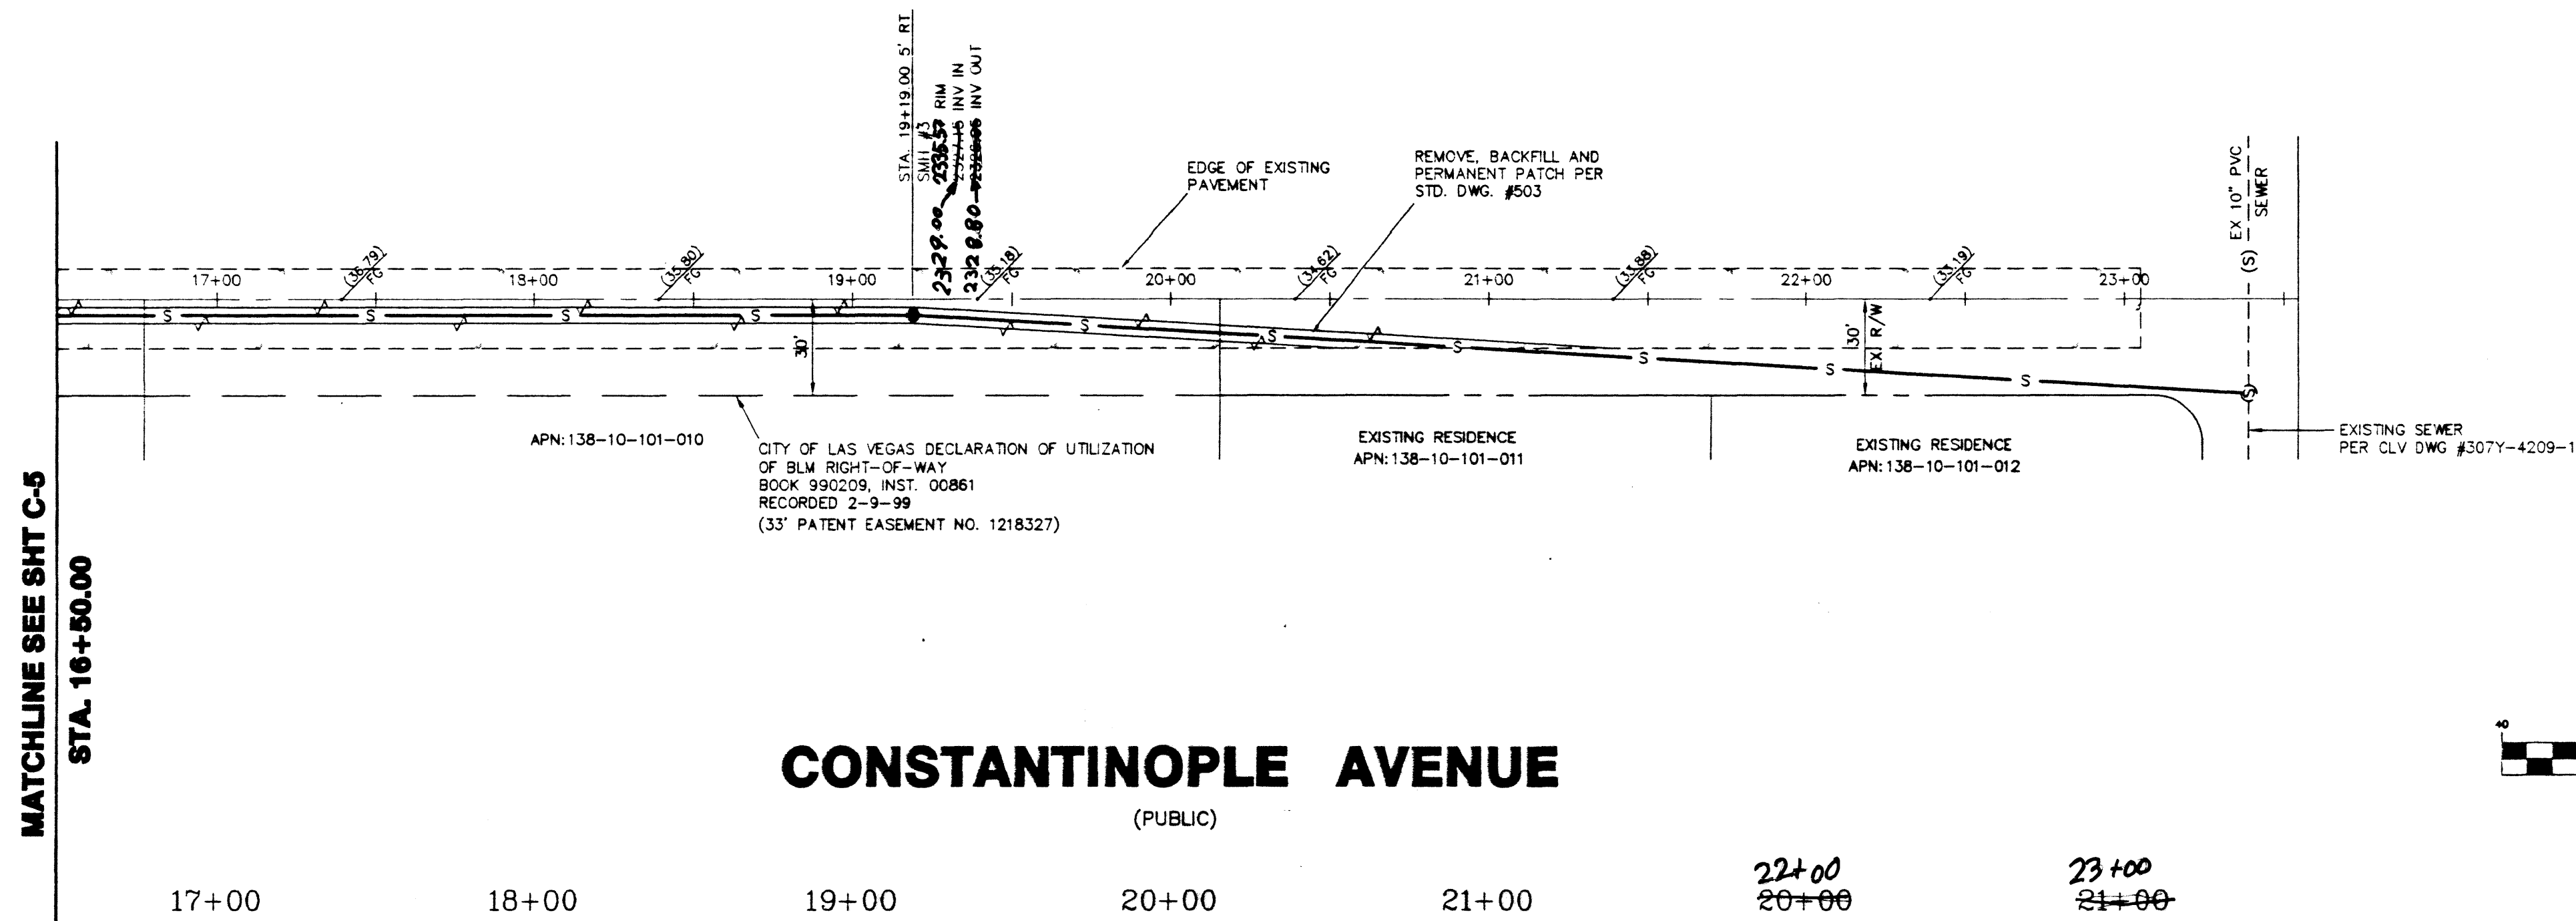

NO.	DATE	DESCRIPTION	BY	APP'D

ROBERT J. LANGAN ENGINEERING
 3305 Spring Mountain Road - Ste. 91
 Las Vegas, Nevada 89102
 (702) 365-0146

A PROJECT OF
Don Herman Construction
 TEL 365-5615
 FAX 365-5618

PLAN AND PROFILE
 WILLOW CREEK
 ASSISTED LIVING COMMUNITY
 (A.K.A. 'BUFFALO ROYALE')

DRAWN BY	RJL
DATE	5-28-99
NO. OF SHEETS	8
SHEET NO.	C-6



99.06.21.03

As-Built 107-V3093