



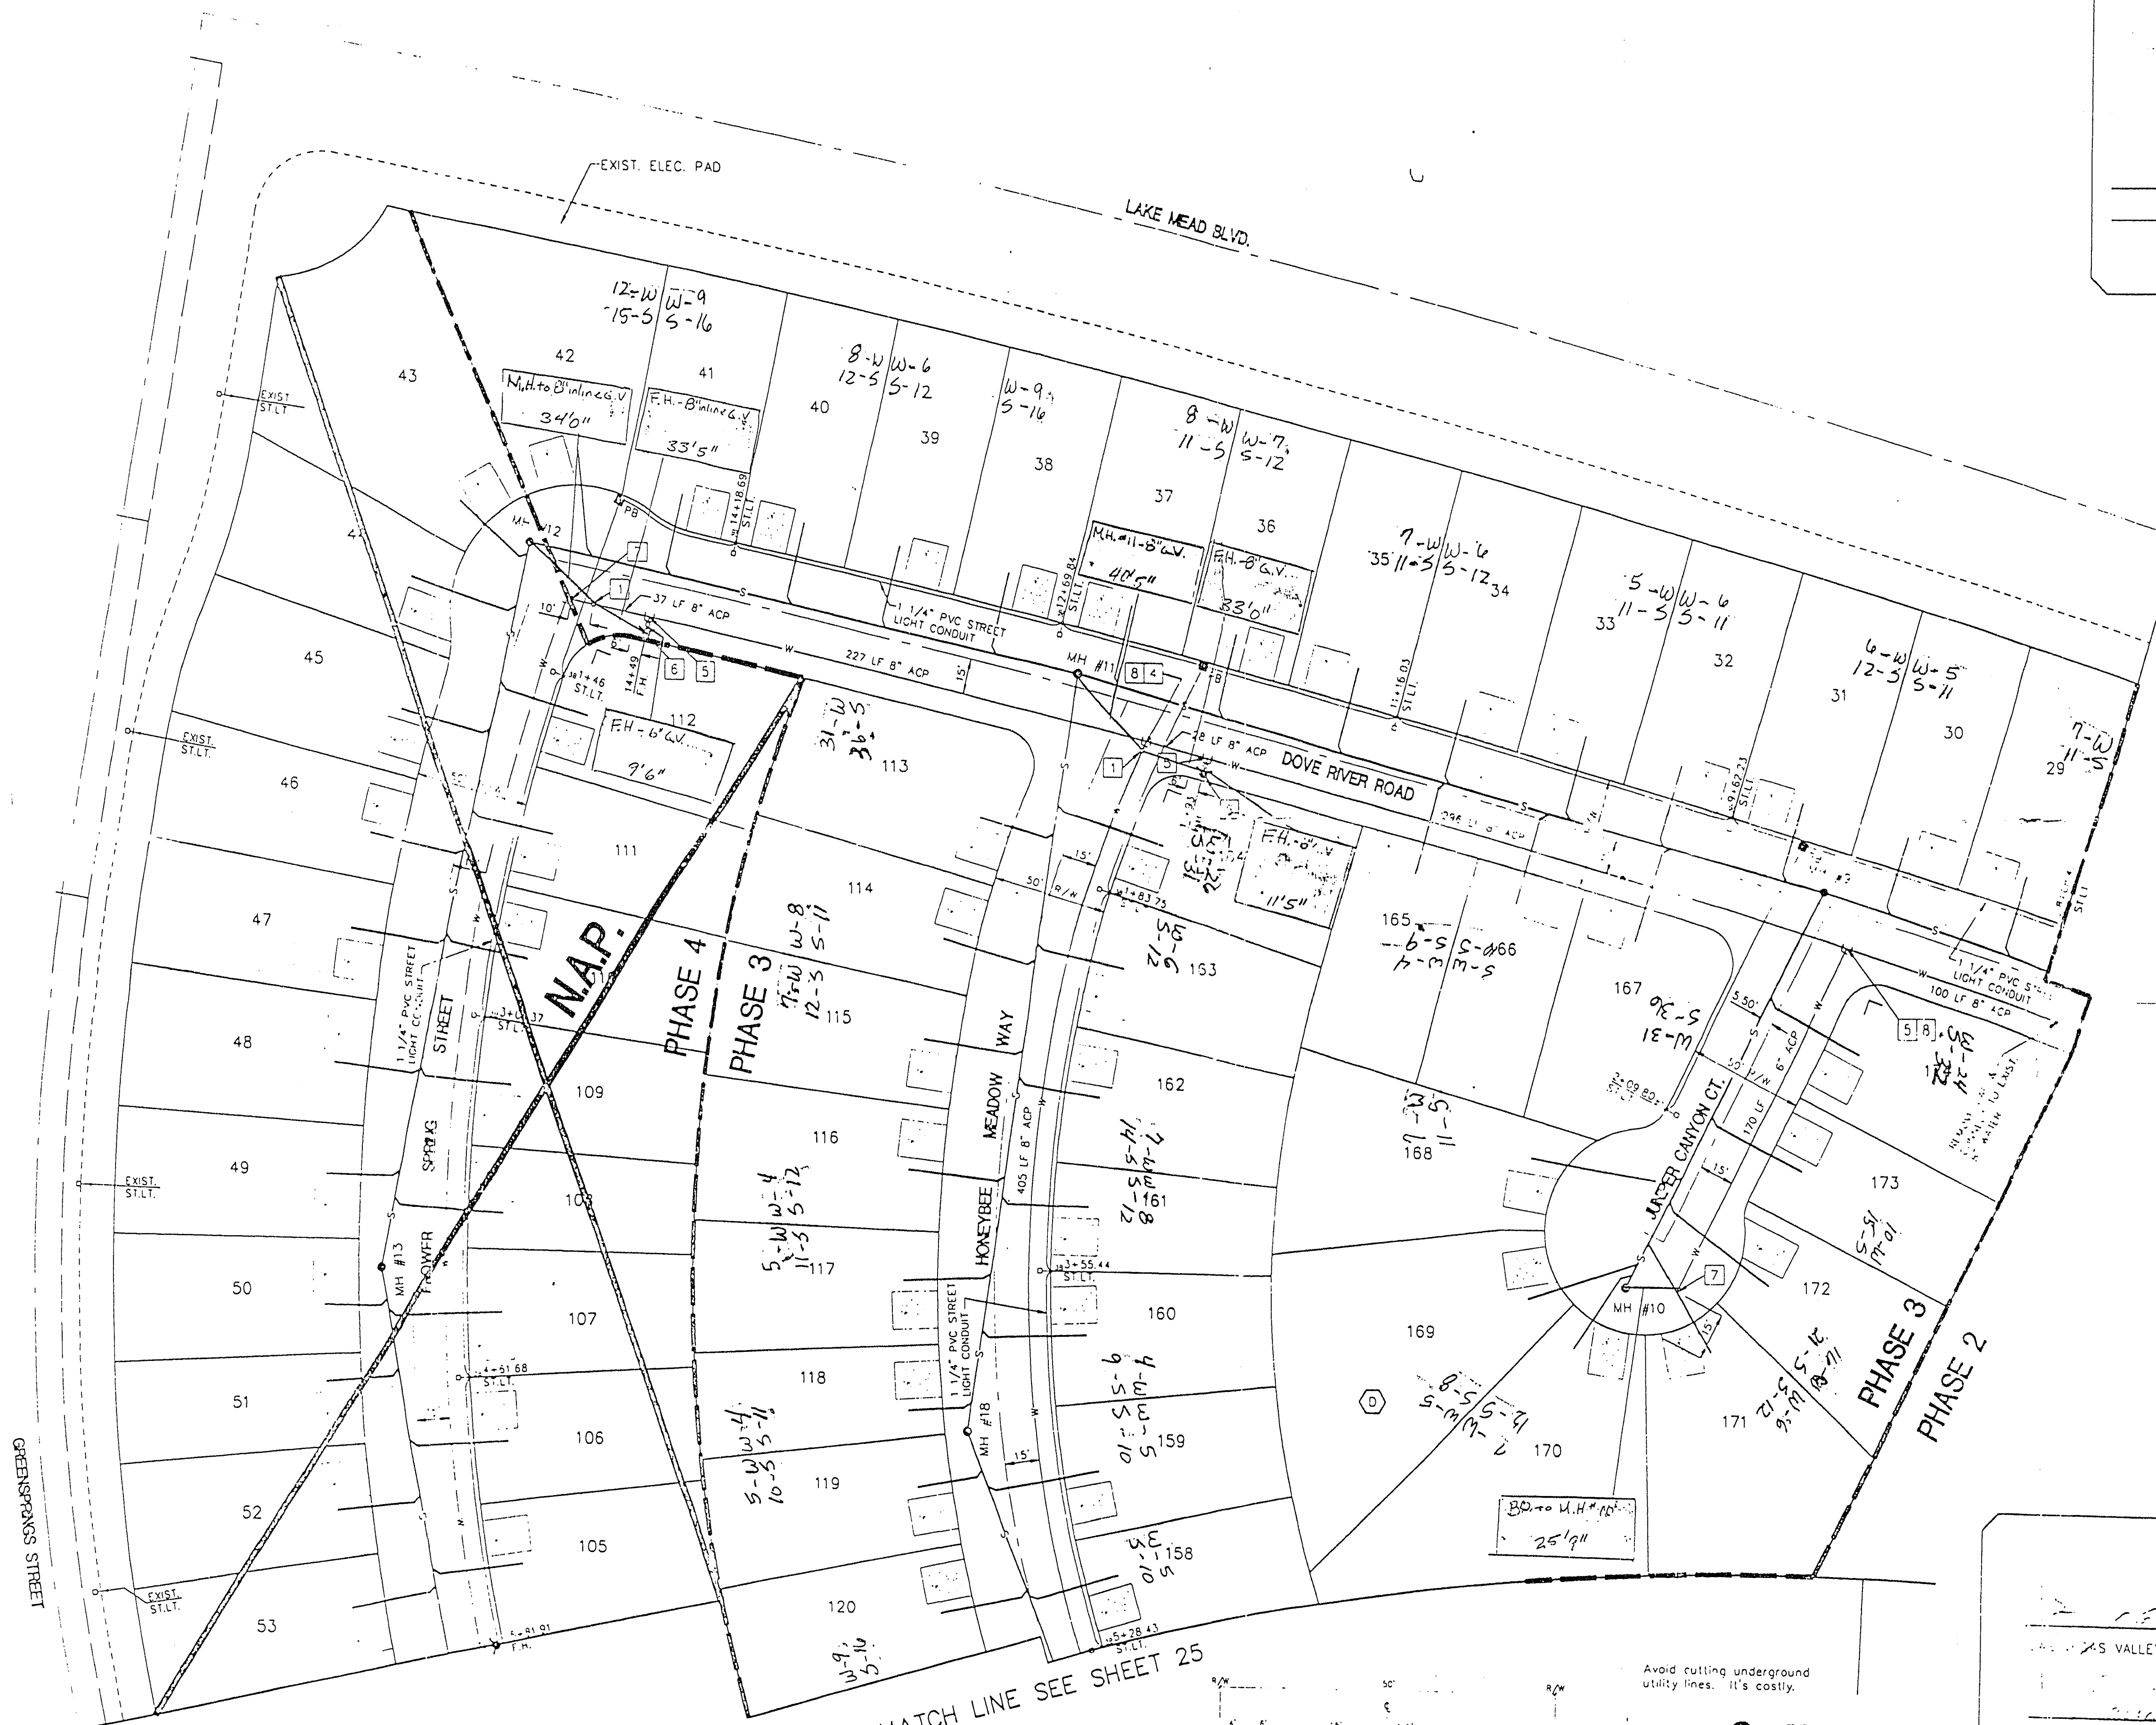


UTILITY LEGEND

- L 6" D-3 STREET NAME SIGN
- O 30" STOP SIGN
- HEIGHT - WAITAGE STREET LIGHT
- ELECTRICAL SERVICE & RCOG
- #3 1/2 PULL BOX
- ⊕ FIRE HYDRANT
- S — SEWER LINE W/ MANHOLE
- W — WATER LINE W/ GATE VALVE
- ▭ CONCRETE DRIVEWAY

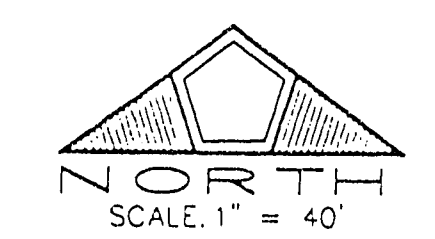


- FITTINGS LEGEND**
- 1 8" GATE VALVE
 - 2 8" 45° BEND
 - 3 8" 90° BEND
 - 4 8" TEE
 - 5 8"x8"x6" TEE
 - 6 STD. FIRE HYDRANT ASSEMBLY
 - 7 2" BLOW-OFF ASSEMBLY W/CAP
 - 8 11 1/4" BEND

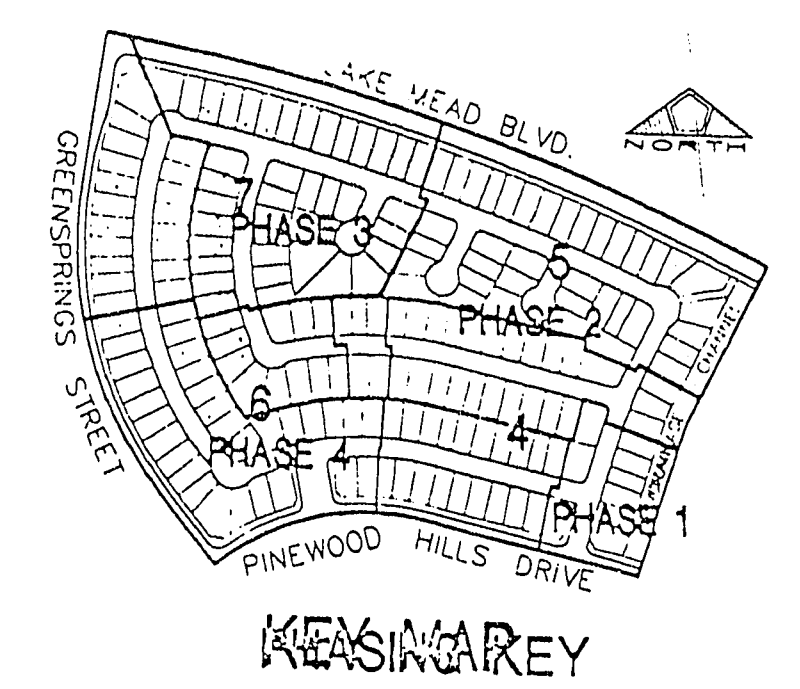

APPROVALS

LEWIS & CLARK VALLEY WATER DISTRICT	DATE
CLARK COUNTY FIRE DEPARTMENT	DATE
NEVADA POWER COMPANY	DATE

APPROVAL IS FOR THE PLACEMENT AND CLEARANCE OF UTILITY, NOT AND SIGNAL LIGHT INSTALLATIONS ONLY.

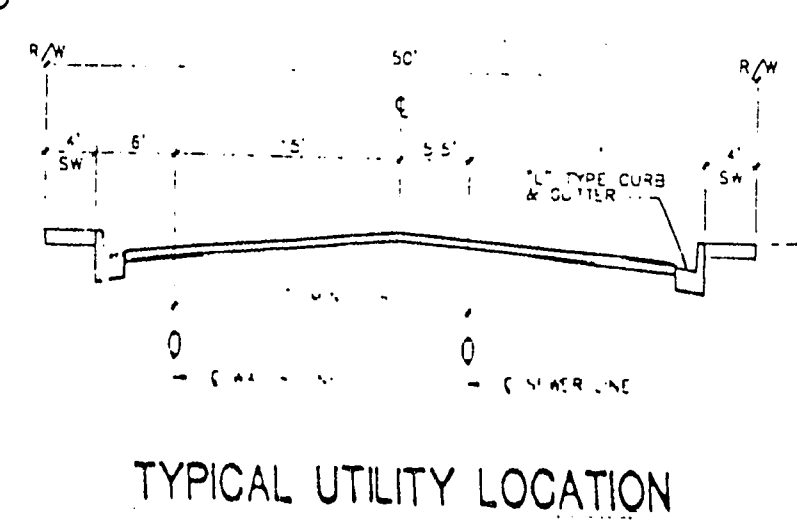

Call before you Dig.
1-800-227-2800

PENTACORE Engineering, Inc.
6763 West Charleston Boulevard
Las Vegas, Nevada 89102
(702) 798-0115

LEWIS HOMES OF NEVADA
WILLOW TREE NO. 3
WATER PLAN II
REBUILDS

Sheet 26

DATE: 10/26/98
DRAWN BY: CMC
DESIGNED BY: CMC
CHECKED BY: CMC
JOB NO.: 6300100
SCALE: 1" = 40'

10-26-98 "As Built" Sewer & Water 5079-4242-3