
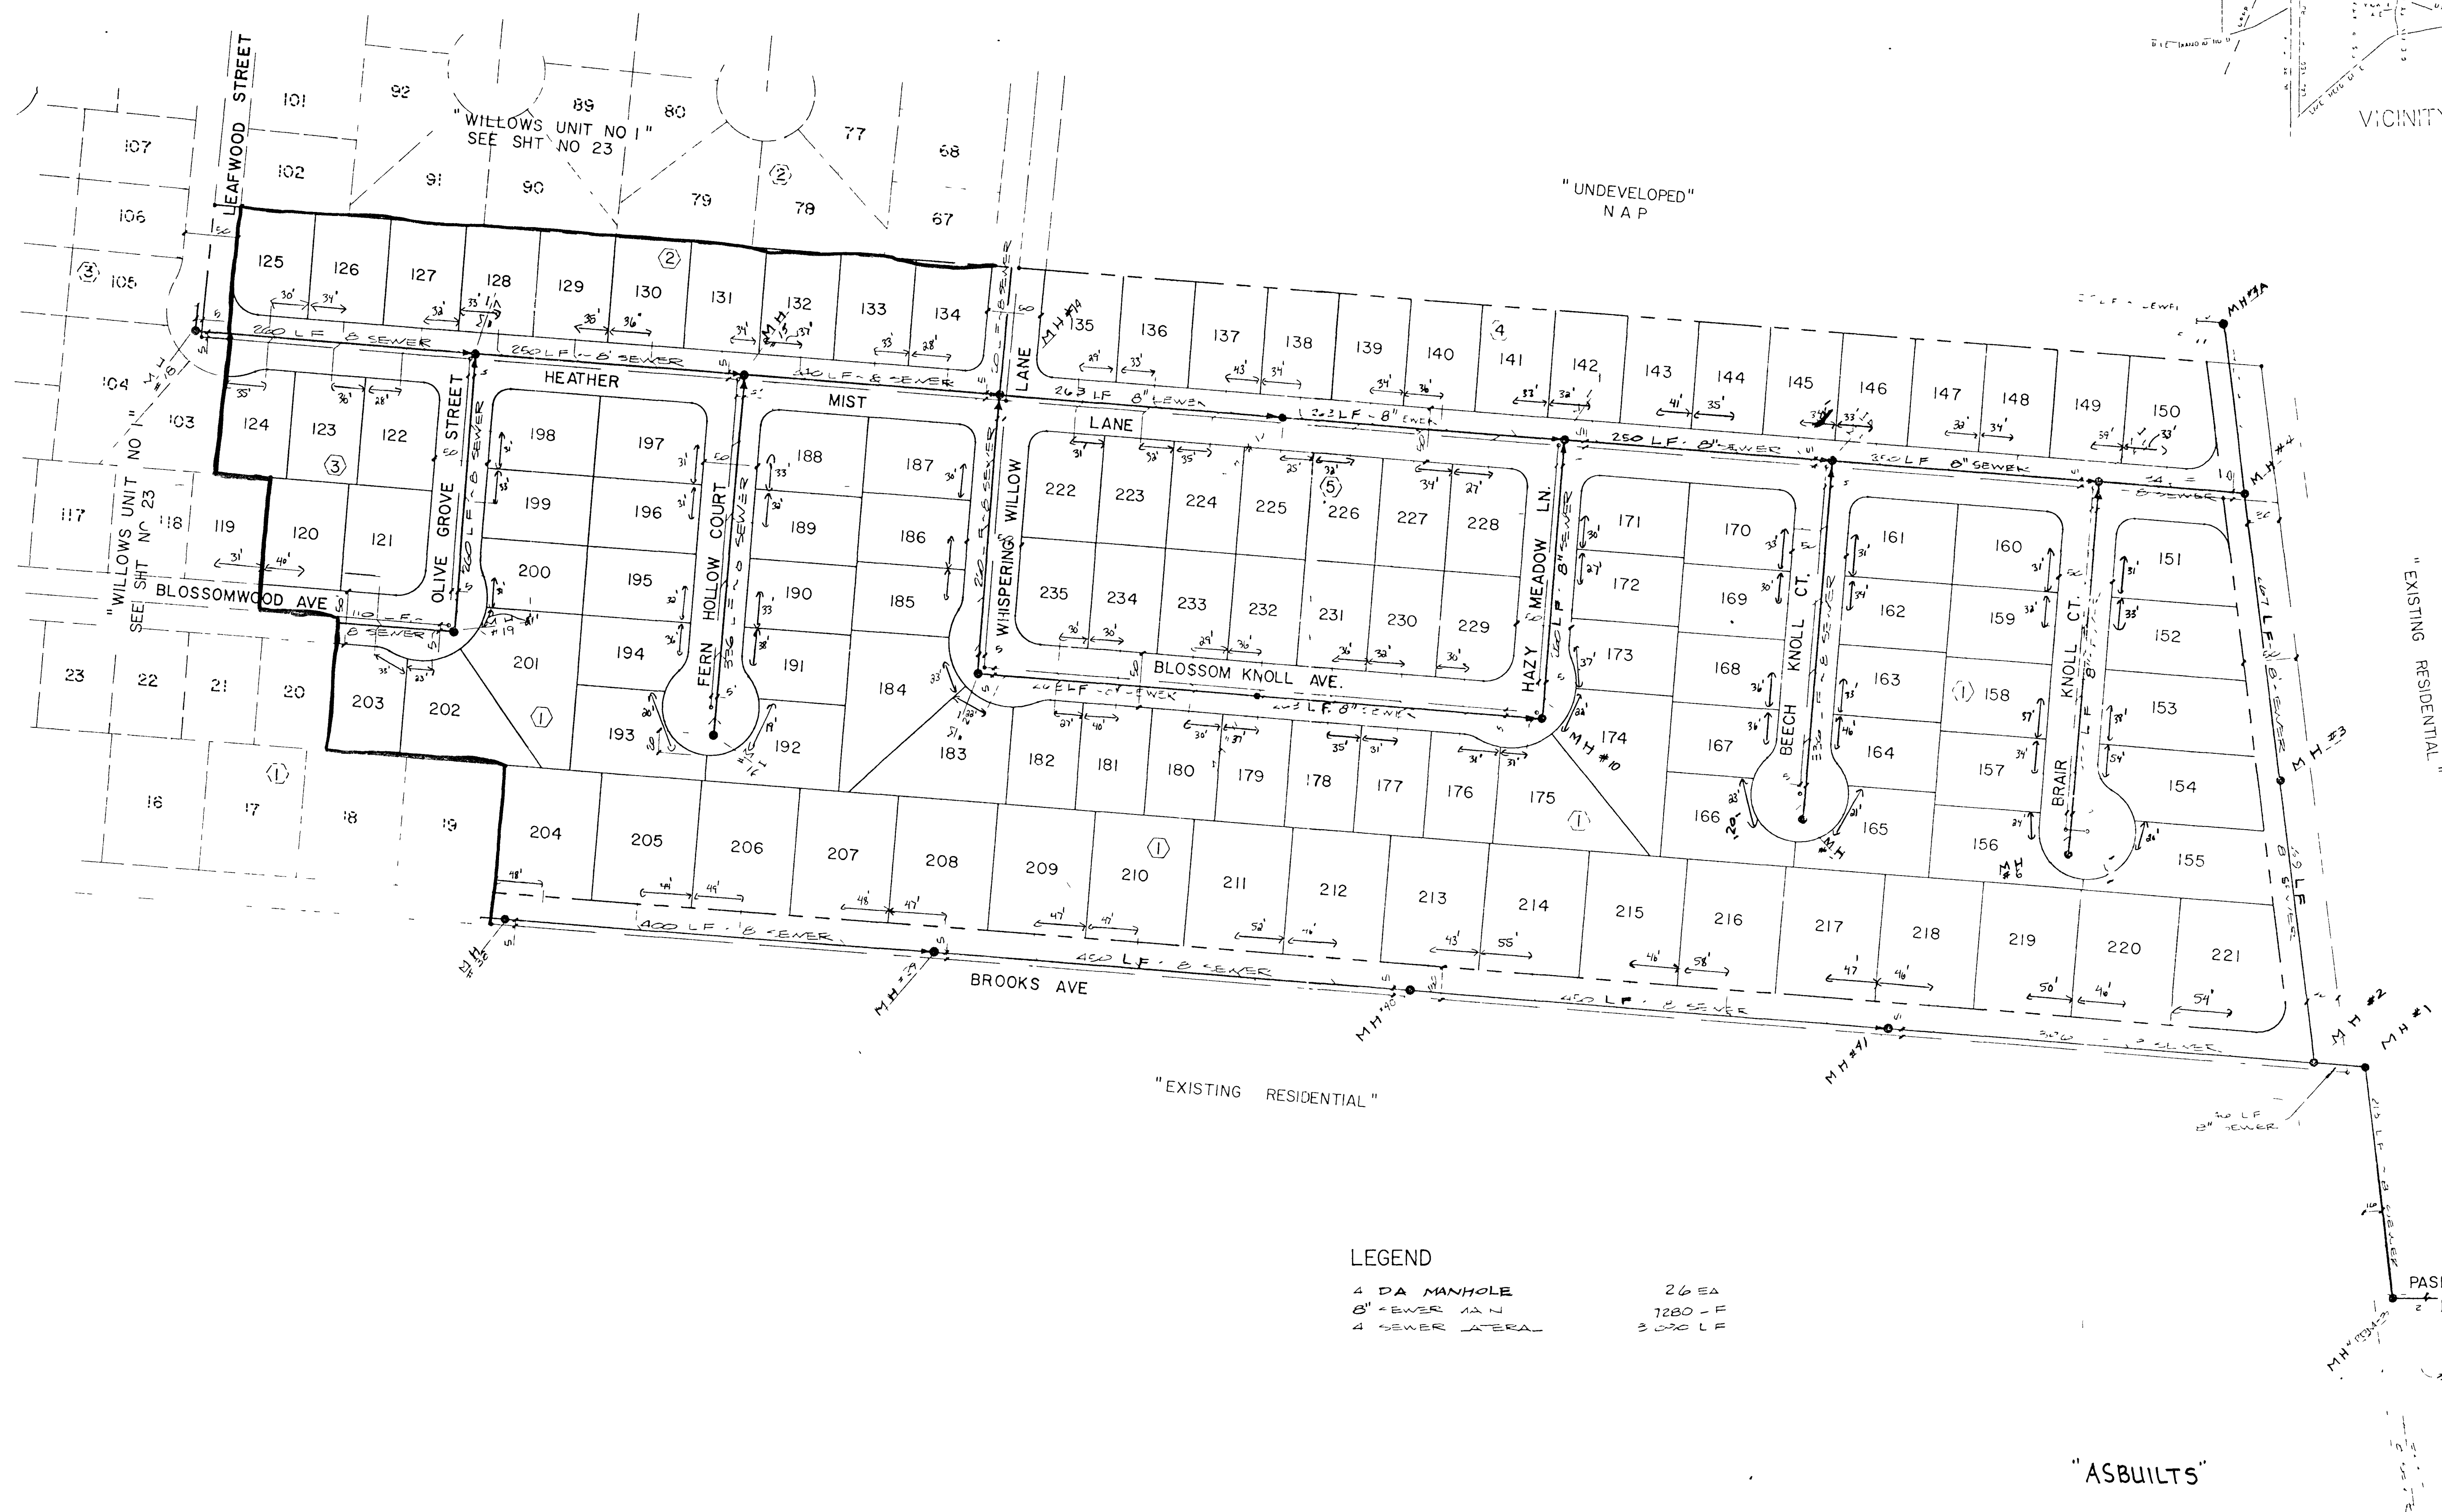


CITY OF LAS VEGAS GENERAL NOTES

1. HOUSE SERVICES SHALL COMPLY WITH WESTERN PLUMBING CODE AS TO SEPARATION DISTANCE.
2. ALL HOUSES TO BE SERVED INDIVIDUALLY AS PER SECTION 313 OF THE UNIFORM PLUMBING CODE.
3. CONTRACTOR SHALL FURNISH THE ENGINEER WITH AS-BUILT DRAWINGS SHOWING THE EXACT LOCATIONS OF ALL HOUSE CONNECTIONS.
4. CONCRETE COLLARS TO BE CONSTRUCTED AROUND ALL MANHOLES AND WATER VALVES. CONCRETE COLLARS SHALL BE 1/8" TO 1/4" LOWER THAN ADJACENT FINISH GRADE.
5. CHISEL S OR G, WHEREVER SLOW OR GAS LINES PASS UNDER CURB.

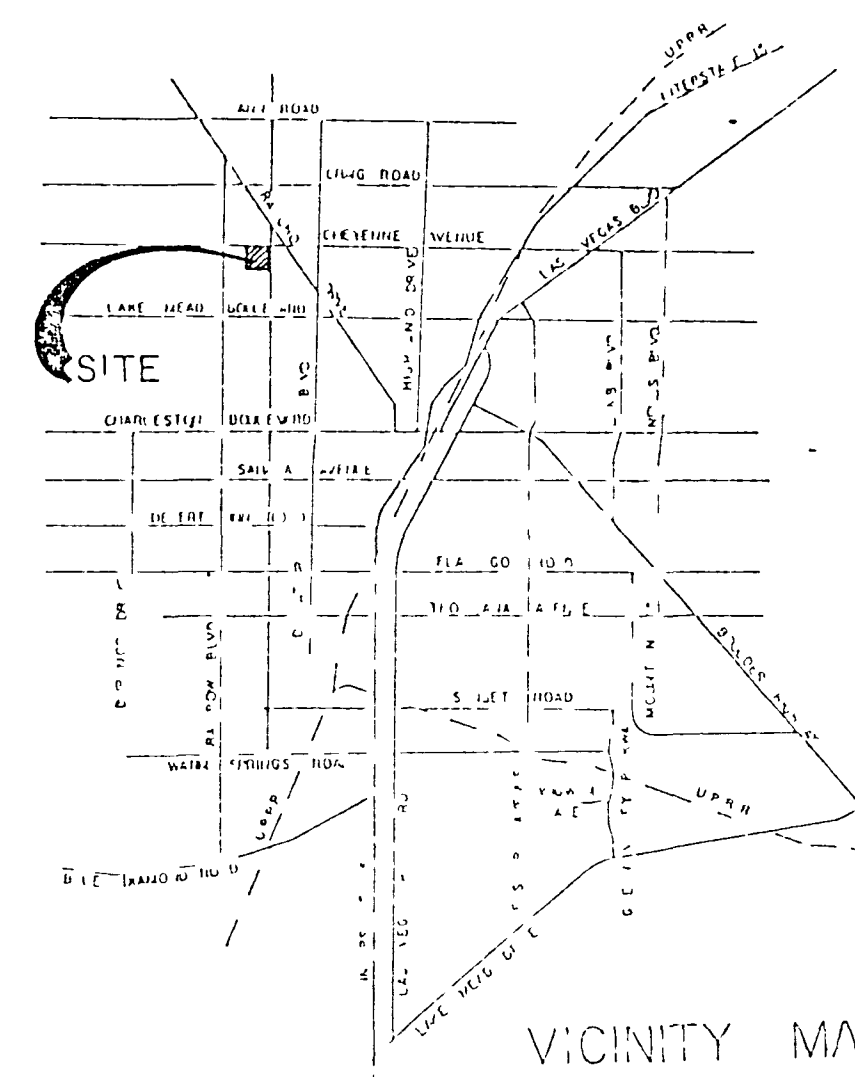

As Bait

MASTER SEWER PLAN
(UNIT NO. 2)

WILLOWS UNITS NO. 1 & 2

LOI TRAINING FOR
SURVIVAL

SUBMITTED BY
J. F. [Signature]

3341-142

24

ANSWER
 1. $\frac{1}{2}$ $\frac{1}{2}$ $\frac{1}{2}$
 2. $\frac{1}{2}$ $\frac{1}{2}$ $\frac{1}{2}$
 3. $\frac{1}{2}$ $\frac{1}{2}$ $\frac{1}{2}$
 4. $\frac{1}{2}$ $\frac{1}{2}$ $\frac{1}{2}$

WILLIAM

As Built

AN 102

EST
SUBMITTED BY

INLET FOR THE
VI YOUR LINE

1. $\frac{1}{2}$
 2. $\frac{1}{3}$
 3. $\frac{1}{4}$
 195. $\frac{1}{196}$
 196. $\frac{1}{197}</$

[The page contains faint, illegible markings and bleed-through from the reverse side.]

