



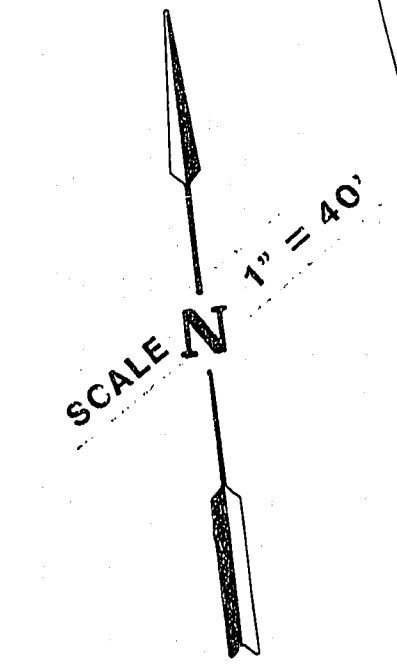

Call before you Dig.
1-800-227-2600
UNDERGROUND SERVICE (USA)

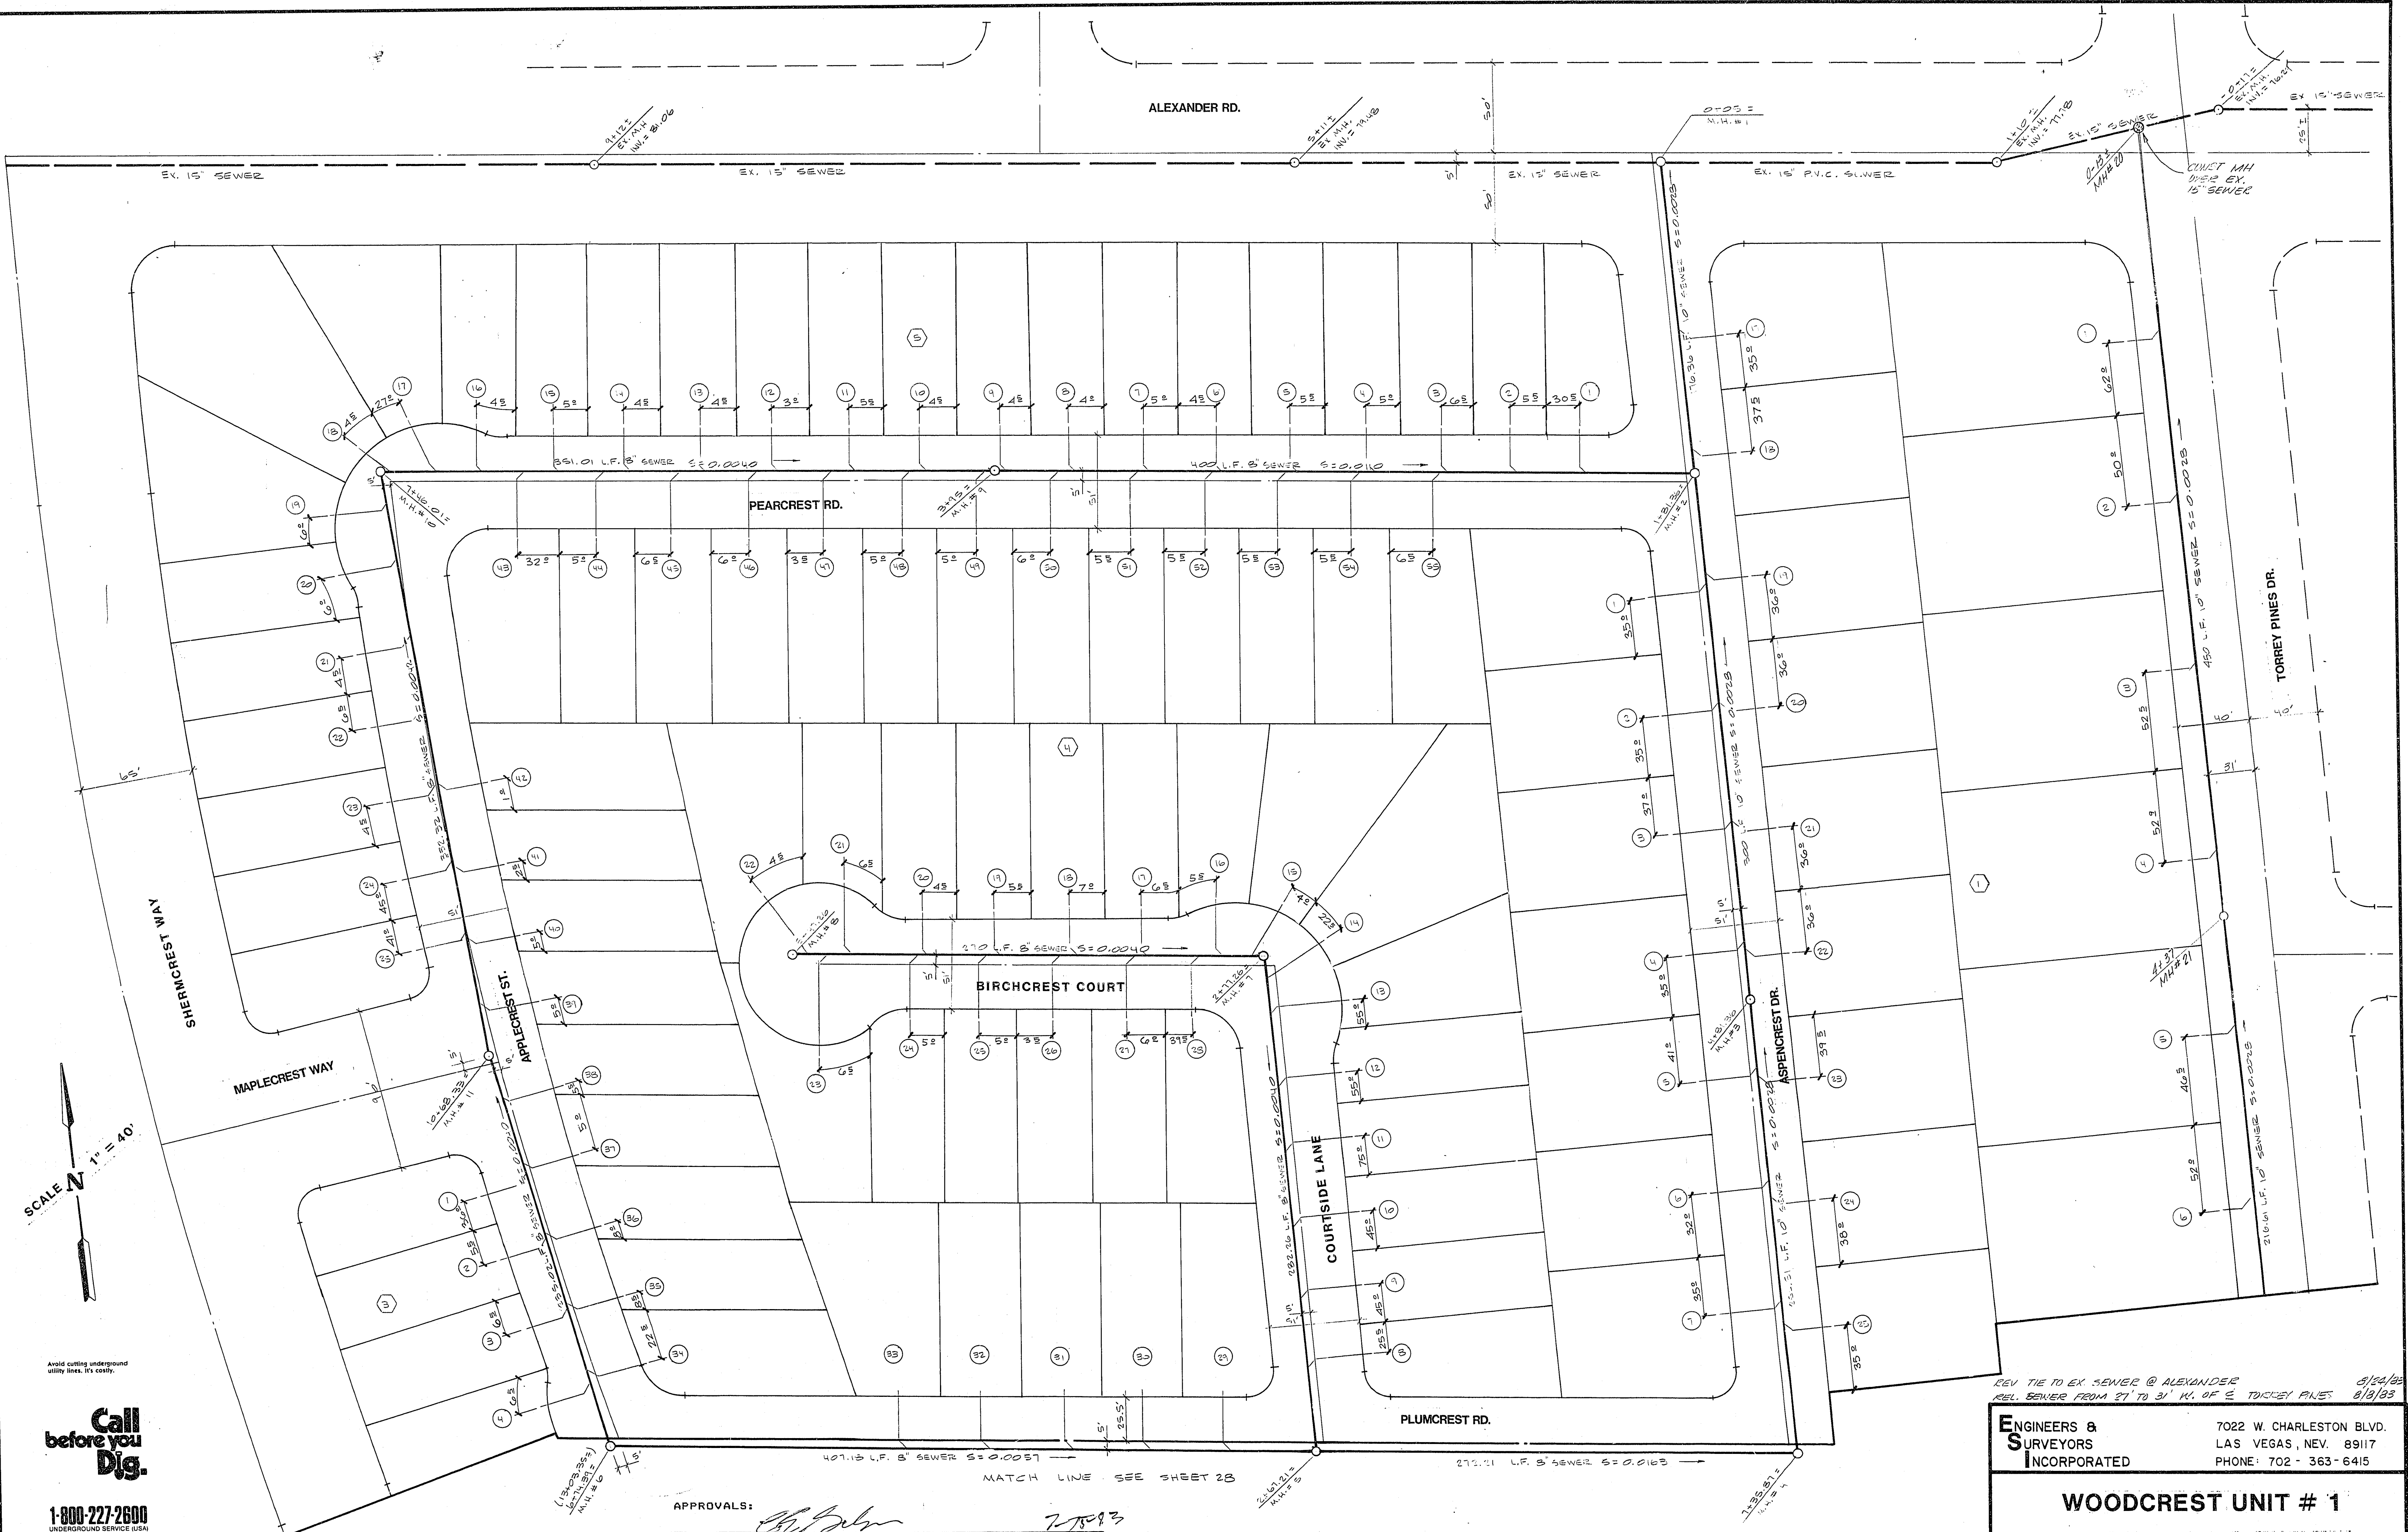

APPROVALS:
C.L.V. CITY ENGINEER *[Signature]* DATE 7/15/83
C.L.V. QUALITY CONTROL ENGINEER *[Signature]* DATE 7/15/83
C.L.V. SANITARY ENGINEER *[Signature]* DATE 7/30/83

REV TIE TO EX. SEWER @ ALEXANDER RD. 8/24/83
REL. SEWER FROM 27' TO 31' N. OF E. TORREY PINES 8/9/83

ENGINEERS & SURVEYORS INCORPORATED
7022 W. CHARLESTON BLVD.
LAS VEGAS, NEV. 89117
PHONE: 702-363-6415

WOODCREST UNIT # 1
MASTER SEWER PLAN

DRWN. D.E.K.	DES. D.E.K.	CHKD. P.E.V.	DATE 5-10-83
WO. NO. 830301-1	H. SCALE 1"=40'	V. SCALE --	SHEET 27 OF 32

U-4-10 As Bldg 3078-3348-1