


Call before you Dig.
1-800-227-2600
UNDERGROUND SERVICE USA

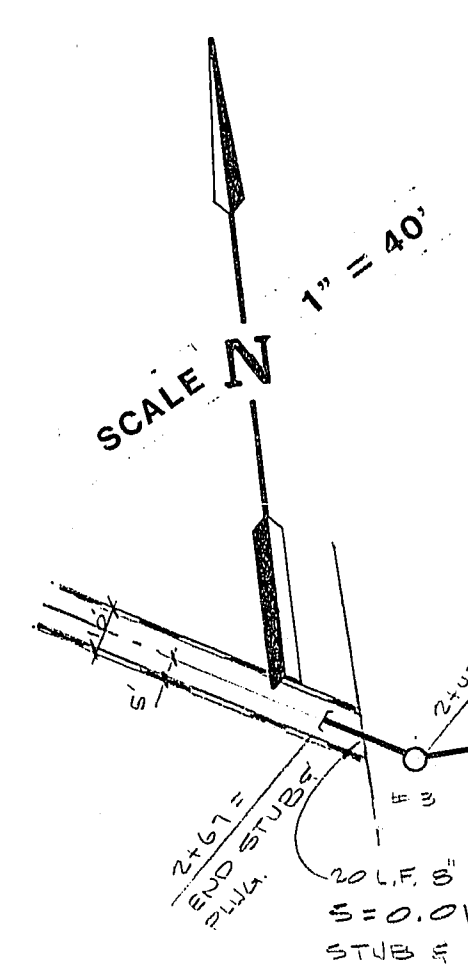

QUANTITY ESTIMATE

10" SEWER	2540	L.F.
8" SEWER	4680	L.F.
4" SEWER LATERALS	5230	L.F.
MANHOLES	23	EA.
CONC. ENCASE	129	L.F.
OFF-SITE (SEE SHEETS 2, 7)		
8" SEWER (OVERSIZED 10")	273	L.F.
MANHOLES	3	EA.
8" SEWER	350	L.F.

C.L.V. GENERAL NOTES

- HOUSE SERVICE SHALL COMPLY WITH WESTERN PLUMBING CODE AS THE SEPARATION DISTANCE.
- ALL HOUSES TO BE SERVED INDIVIDUALLY AS PER SECTION 313 OF THE UNIFORM PLUMBING CODE.
- CONTRACTOR SHALL FURNISH THE ENGINEER WITH AS-BUILT DRAWINGS SHOWING THE EXACT LOCATIONS OF ALL HOUSE CONNECTIONS.
- CONCRETE COLLARS TO BE CONSTRUCTED AROUND ALL MANHOLES AND WATER VALVES.
- CHISEL S OR G WHEREVER SEWER OR GAS LINES PASS UNDER CURB.

APPROVALS


[Signature] 7/18/83
CITY OF LAS VEGAS CITY ENGINEER DATE

[Signature] 7/18/83
CITY OF LAS VEGAS QUALITY CONTROL DATE

[Signature] 6-30-83
CITY OF LAS VEGAS SANITARY ENGINEER DATE

SUBMITTED BY

PAUL E. VALENTINE P.E.
NEVADA CERTIFICATE NO. 5916

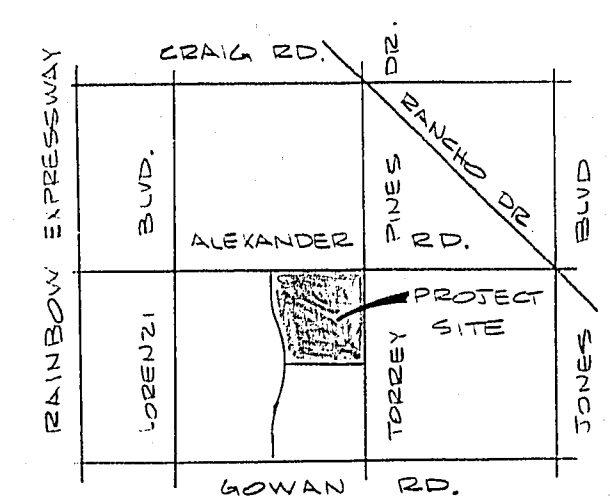

VICINITY MAP

REVISED CONC. ENCASEMENT
REL SEWER FROM 27' TO 31' W. OF E. OF TORREY PINES 8/1/83

ENGINEERS & SURVEYORS INCORPORATED	7022 W. CHARLESTON BLVD. LAS VEGAS, NEV. 89117 PHONE: 702-363-6415
WOODCREST UNIT # 1 MASTER SEWER PLAN	
DRWN. D.E.V.	DES. D.E.V.
CHKD. P.E.V.	DATE 5-10-83
WO. NO. 830301-1	SHEET 28 OF 32

As Built 307 y-3348-1