


Avoid calling underground utility lines. It's costly.

Call before you Dig.

1-800-227-2600
UNDERGROUND SERVICE USA

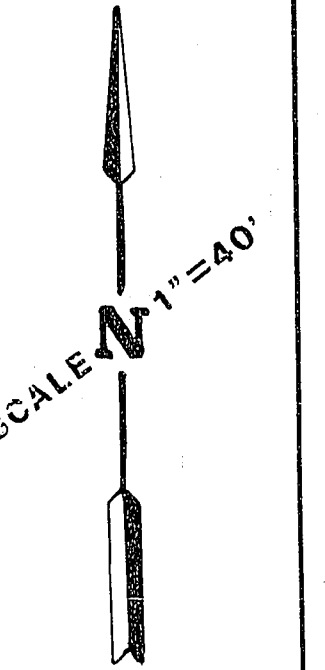

ALEXANDER ROAD

CANYONCOVE WAY

BEACON RD.

LORENZI BLVD.

RHINE LN.

COCONUT CT.


COBBLE CREEK CT.

DREAM ST.

RHINE LN.


TRELLIS LN.

SHERMCREST WAY

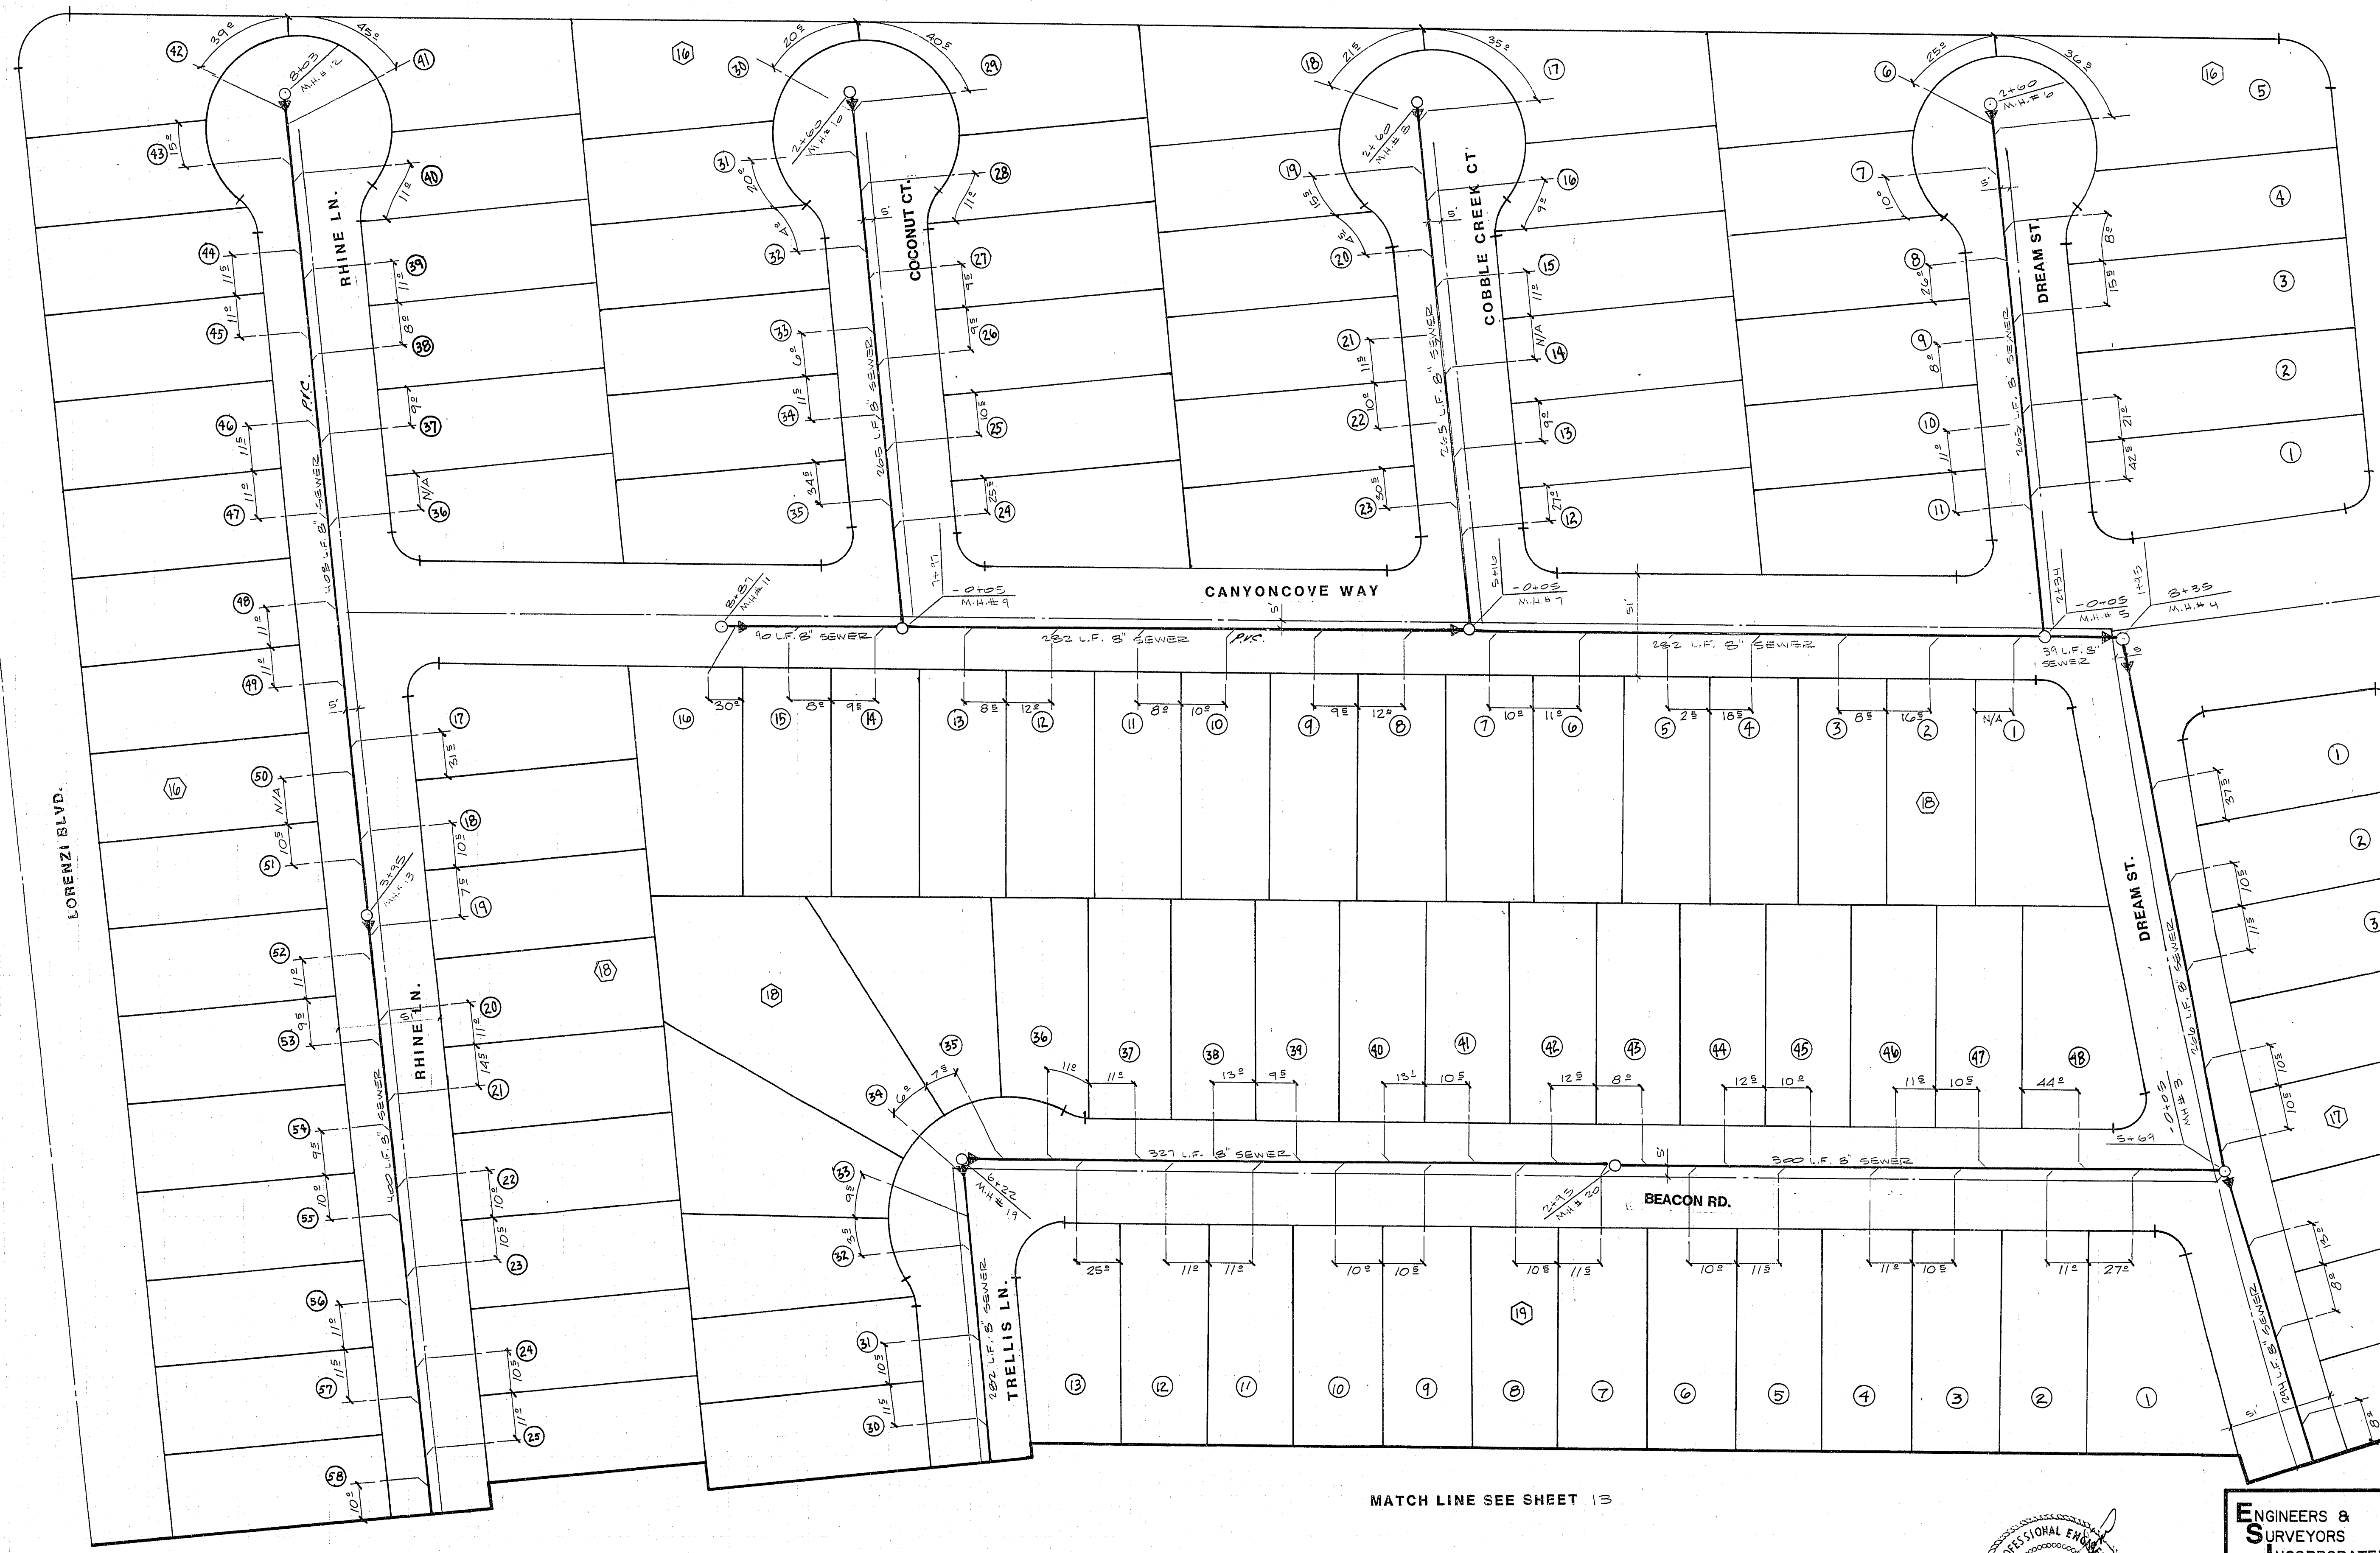

MATCH LINE SEE SHEET 13

APPROVALS:
[Signature]
C.L.V. CHIEF, FLOOD CONTROL & LAND DEVELOPMENT DATE 3/16/83

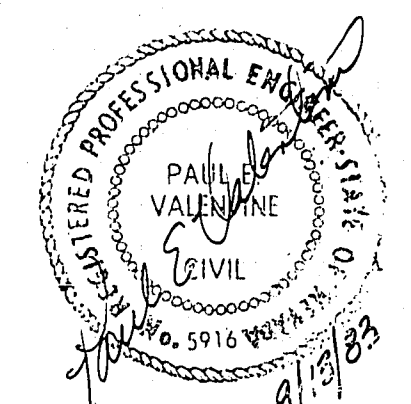

ENGINEERS & SURVEYORS INCORPORATED
7022 W. CHARLESTON BLVD.
LAS VEGAS, NEV. 89117
PHONE: 702-363-6415

WOODCREST UNIT # 2
MASTER SEWER PLAN

DRWN K.L.N.	DES. P.E.V.	CHKD. D.E.K.	DATE 7/29/83
WO. NO. 830201-2	H. SCALE 1"=40'	V. SCALE -	SHEET 12 OF 17

As Built 3074-3348-2