
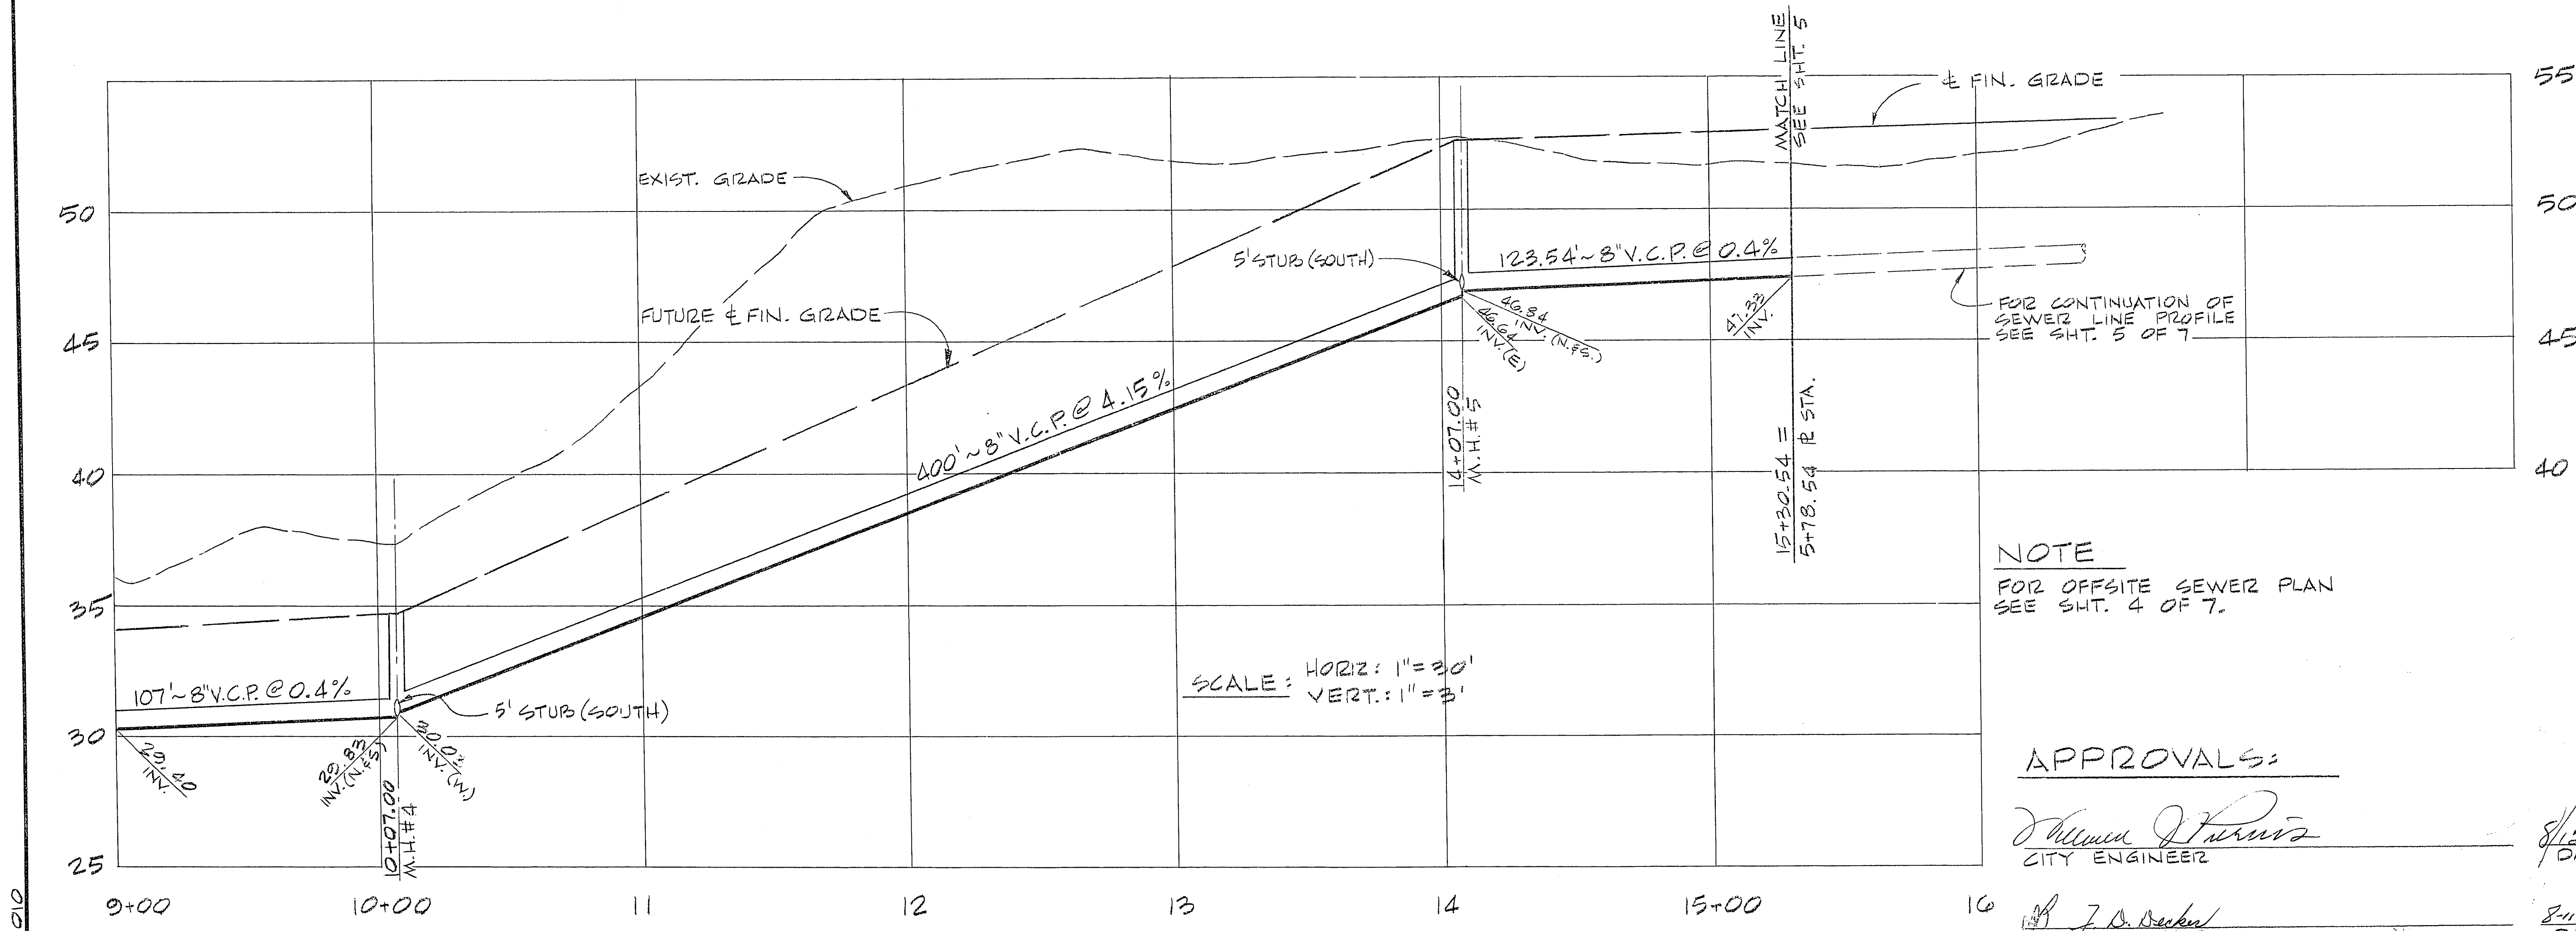


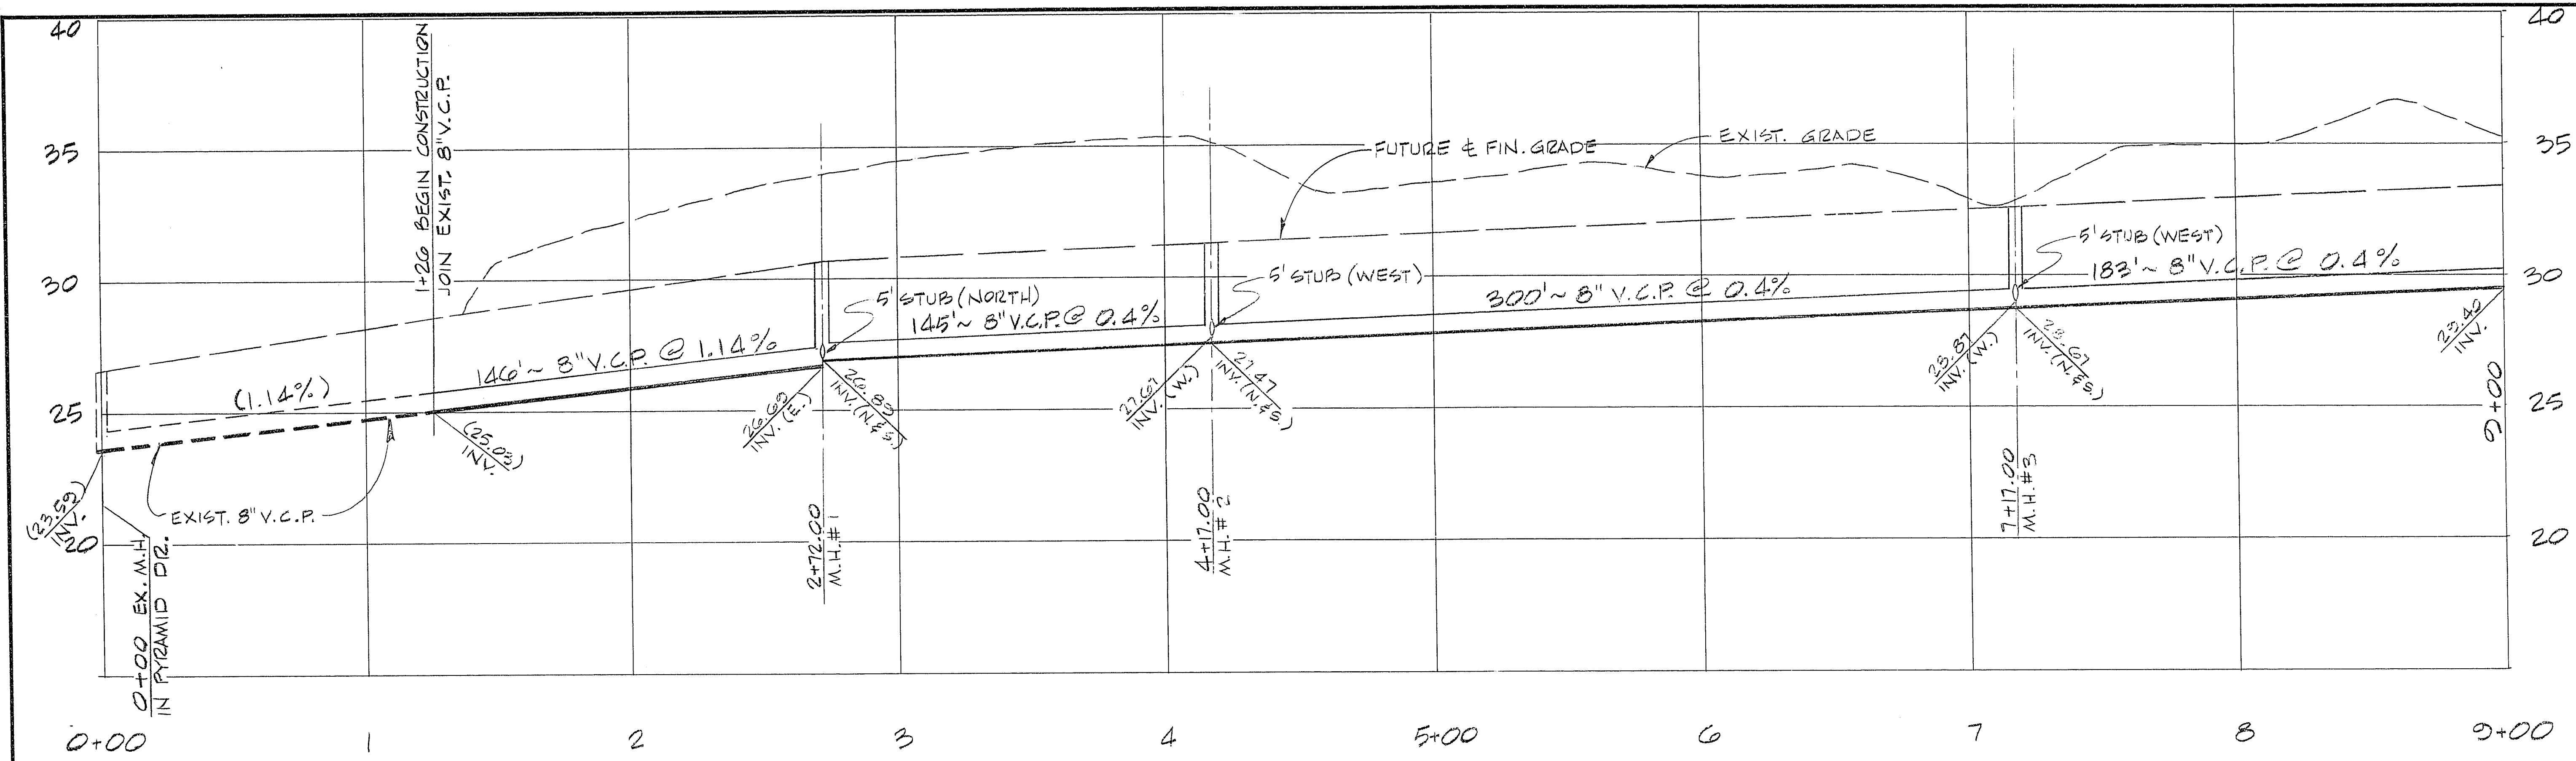

SCALE: HORIZ: 1"=30'
VERT: 1"=3'

NOTE
FOR OFFSITE SEWER PLAN
SEE SHT. 4 OF 7.

APPROVALS:

William J. Purvis
 CITY ENGINEER
 8/12/76
 DATE

J. A. Decker
 FIELD ENGINEER
 8-11-76
 DATE

P. A. Dutton
 SANITATION SUPERINTENDENT
 8-11-76
 DATE

RECOMMENDED	DATE	DESCRIPTION
1	9/1/76	LOWELED ALL GRADES 1.0'
2	9/1/76	REV. GRADES & BEGIN STA.

1100 East Sahara Ave. • Las Vegas, Nevada 89104 • 732-3330

G.C. WALLACE
Consulting Engineers, Inc.

THE CRESTMONT CORPORATION
WOODLAND HILLS - UNIT N^o 1
OFFSITE SEWER PROFILE

SHEET
6
OF 7 SHEETS