
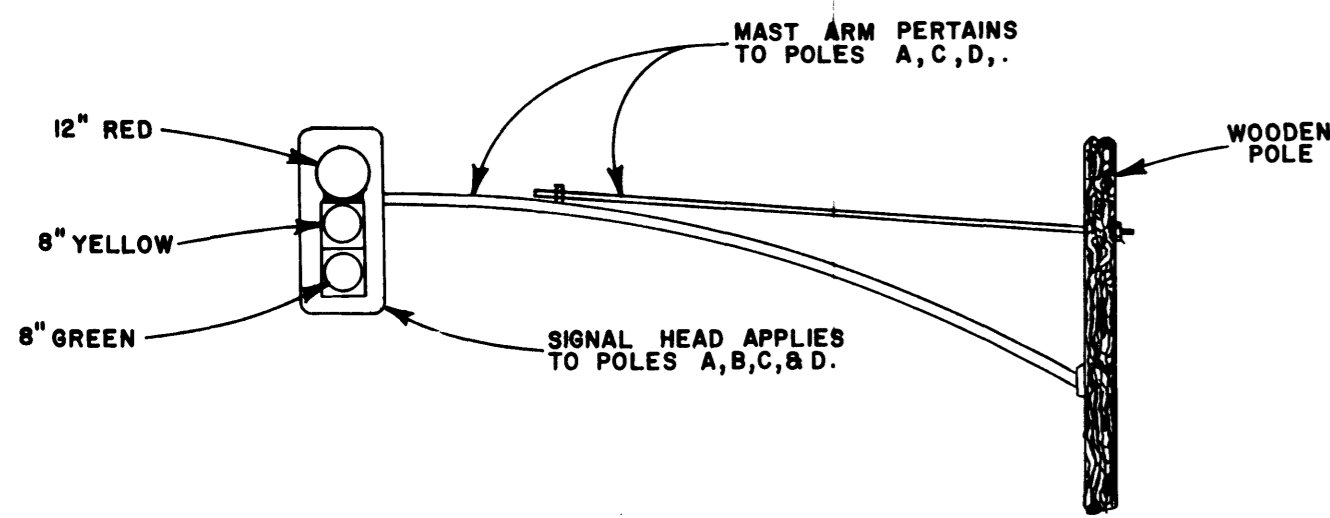


COMMERCE

WYOMING AVE.

ST.

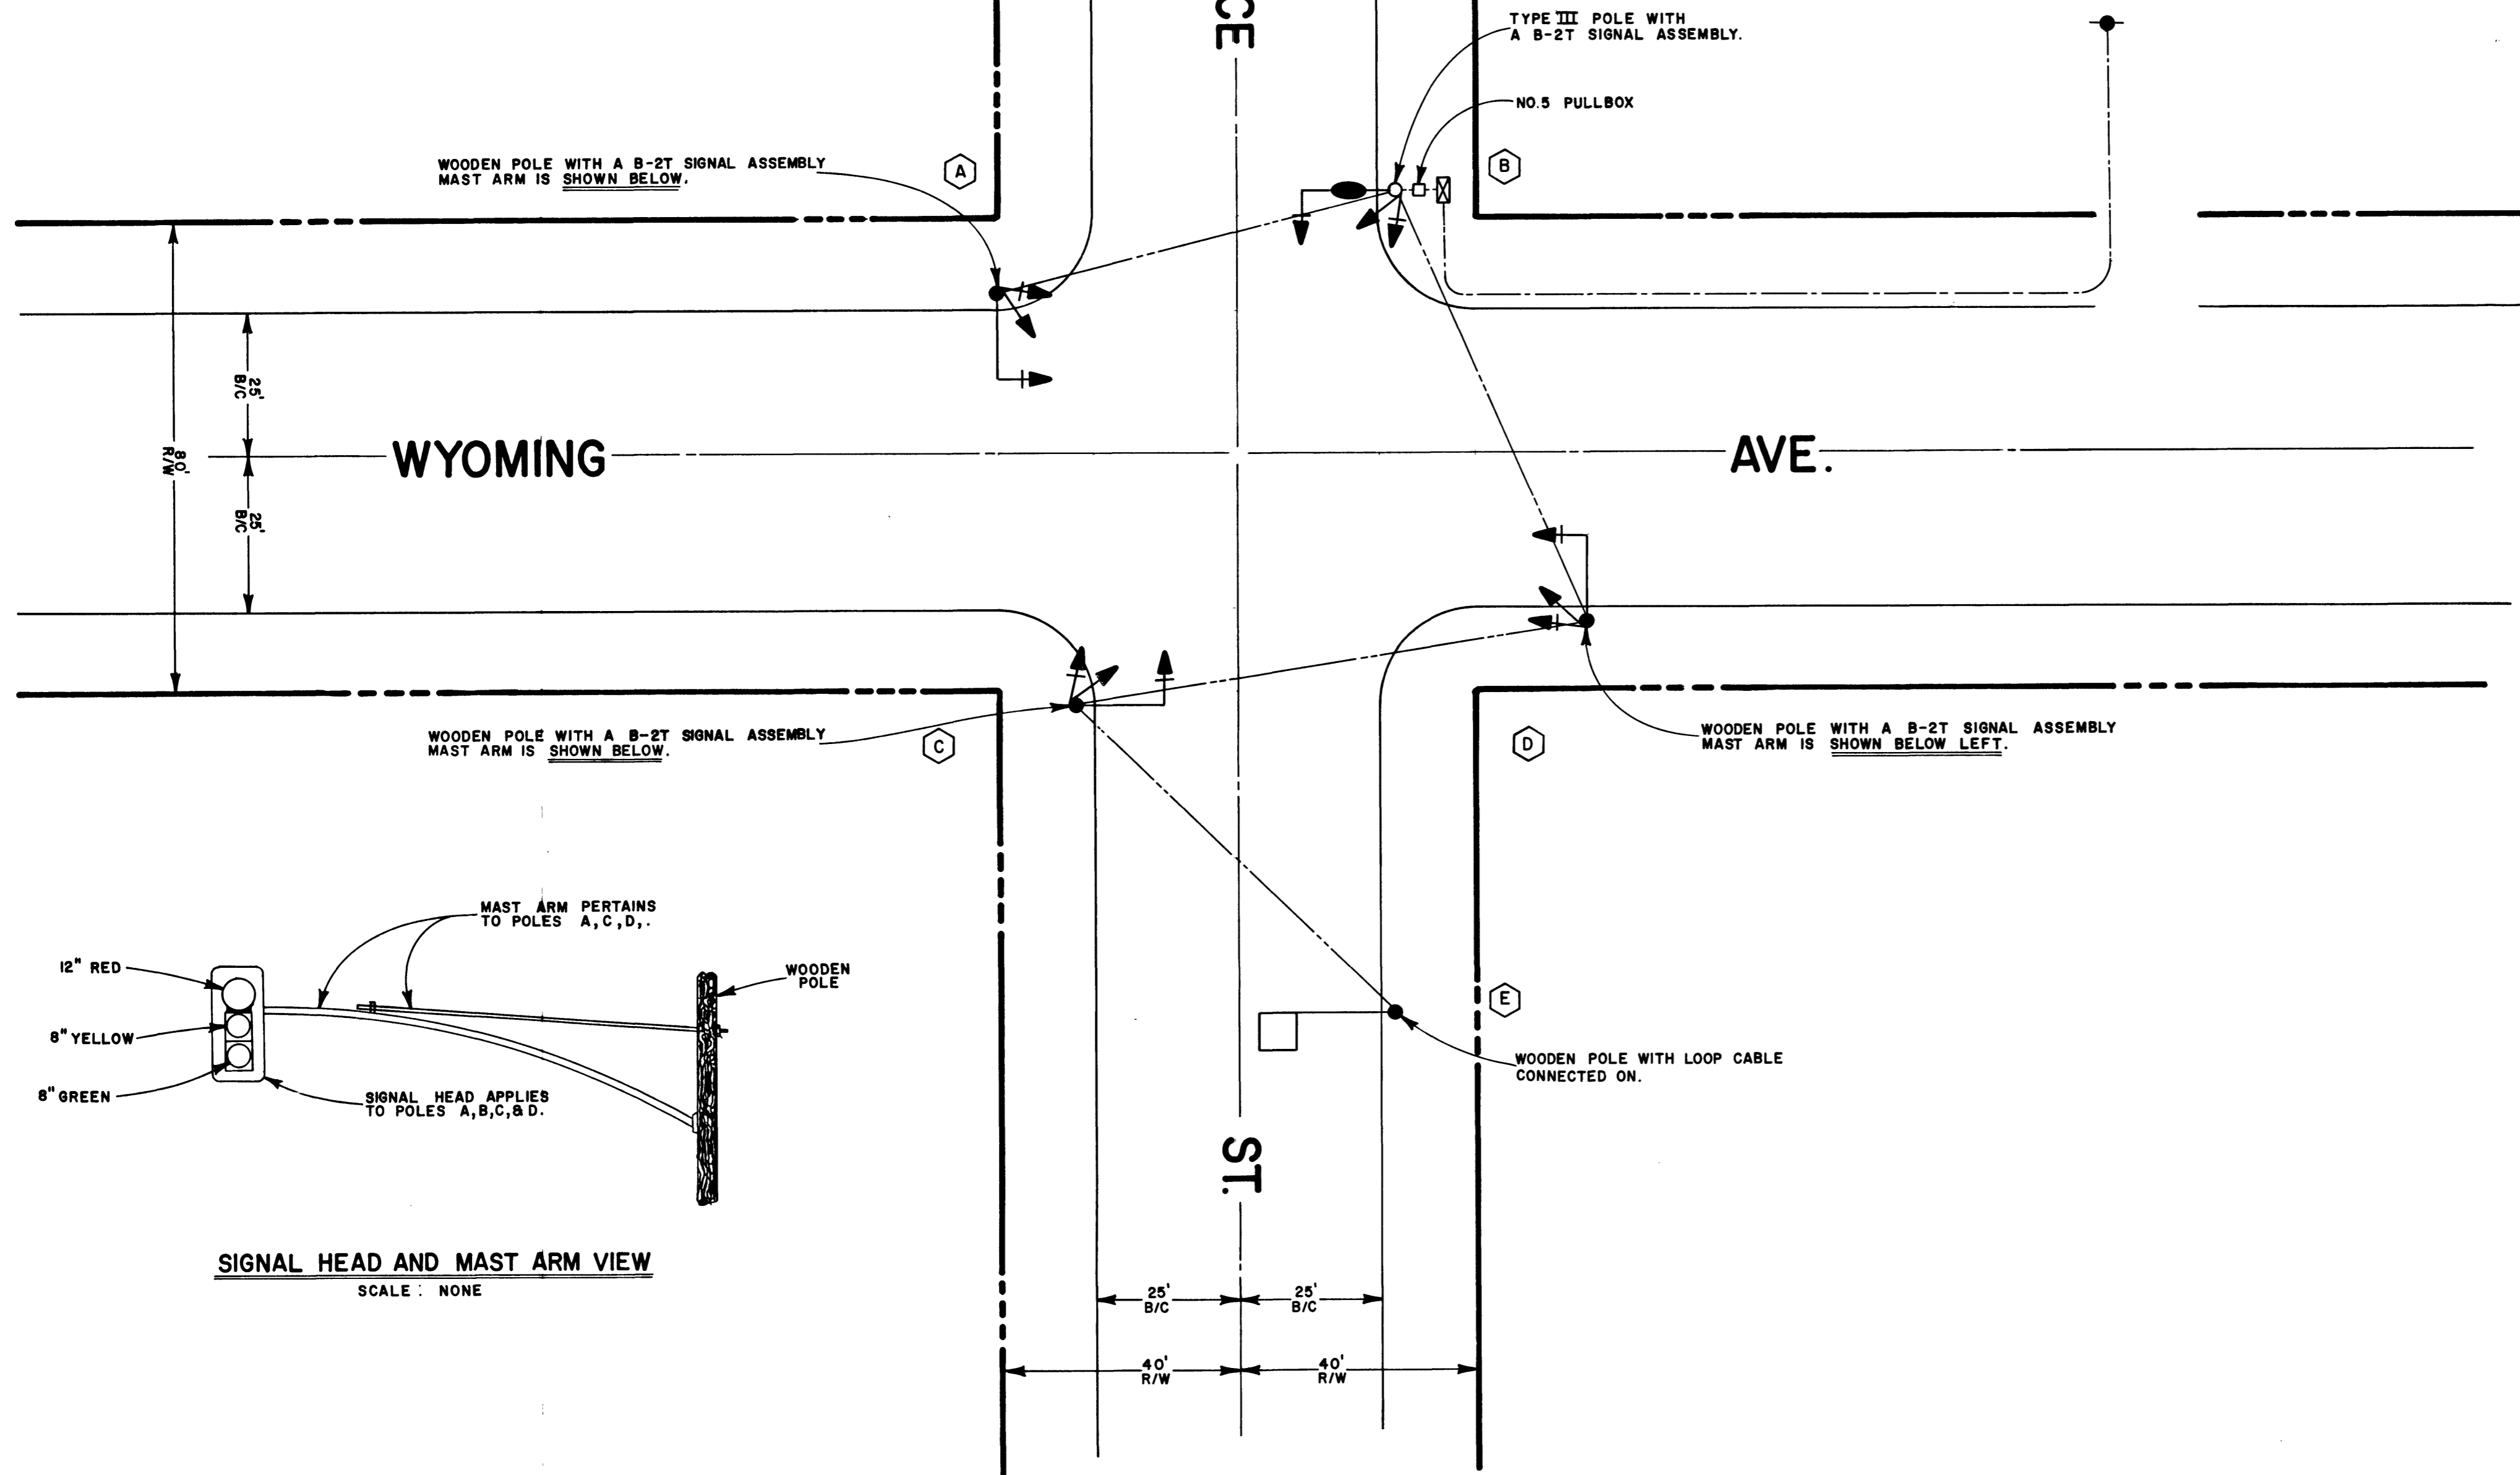

SIGNAL HEAD AND MAST ARM VIEW
SCALE: NONE

AS BUILT

CITY OF LAS VEGAS NEVADA
DEPARTMENT OF PUBLIC WORKS
TRAFFIC ENGINEERING DIVISION

WYOMING AVE. & COMMERCE ST.

George D. Smith
APPROVED BY TRAFFIC SIGNAL SUPERVISOR DATE 3/29/76

W.O. NO. 7701	SCALE 1"=20'	DATE 3-30-76	DRAWING NO. 208-V219
DR. ANTONE SMITH		3-29-76	FILE NO.
APPROVED BY TRAFFIC ENGINEER		3/29/76	
APPROVED BY DIRECTOR OF PUBLIC WORKS		3/29/76	SHEET 1 OF 1

41585