
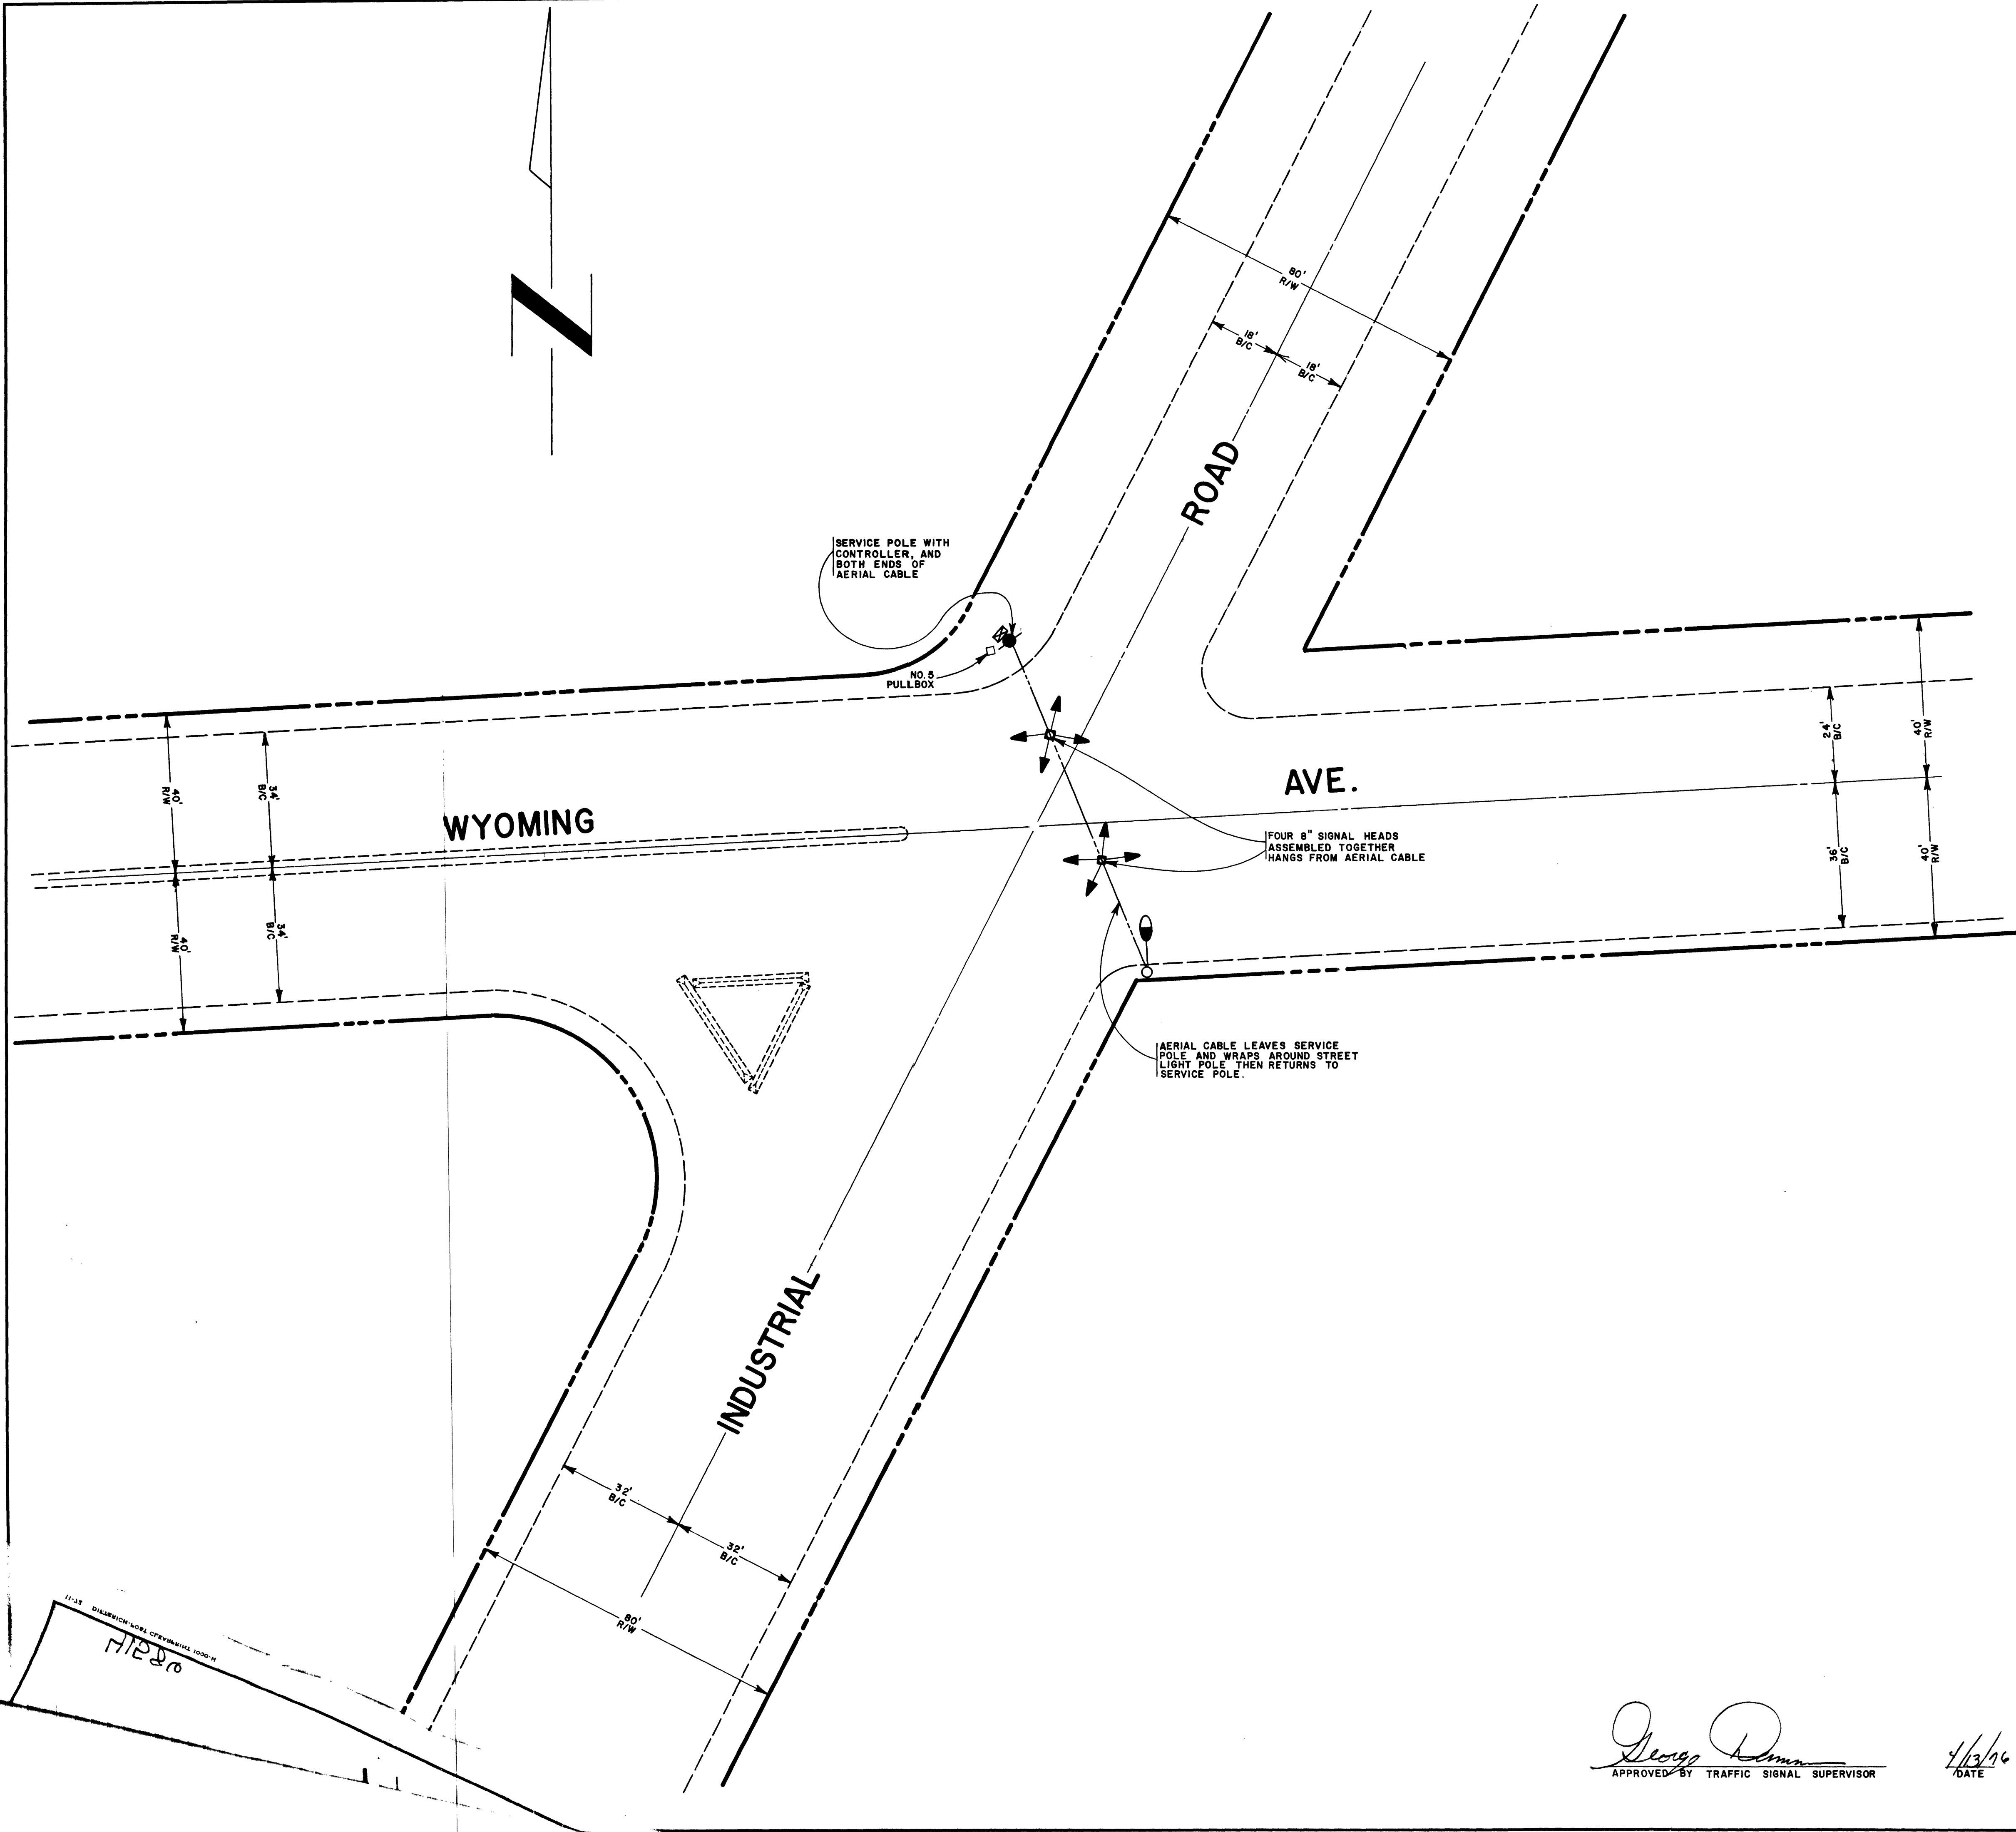


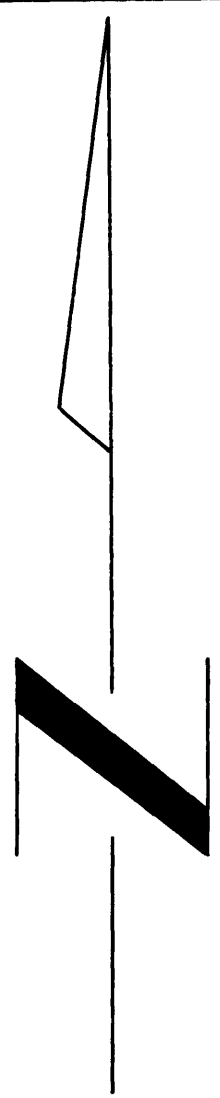

SERVICE POLE WITH
CONTROLLER, AND
BOTH ENDS OF
AERIAL CABLE

NO. 5
PULL BOX

ROAD

AVE.

WYOMING

INDUSTRIAL

FOUR 8" SIGNAL HEADS
ASSEMBLED TOGETHER
HANGS FROM AERIAL CABLE

AERIAL CABLE LEAVES SERVICE
POLE AND WRAPS AROUND STREET
LIGHT POLE THEN RETURNS TO
SERVICE POLE

George D...
APPROVED BY TRAFFIC SIGNAL SUPERVISOR

1/13/76
DATE

AS BUILT

CITY OF LAS VEGAS NEVADA DEPARTMENT OF PUBLIC WORKS TRAFFIC ENGINEERING DIVISION			
WYOMING AVE & INDUSTRIAL RD			
W.O. NO. 7701	SCALE 1"=20'	DATE 4-12-76	DRAWING NO. 208-V220
DR. ANTONE SMITH	APPROVED BY TRAFFIC ENGINEER	4-14-76	FILE NO.
APPROVED BY DIRECTOR OF PUBLIC WORKS			4/14/76
SHEET 1 OF 1			