
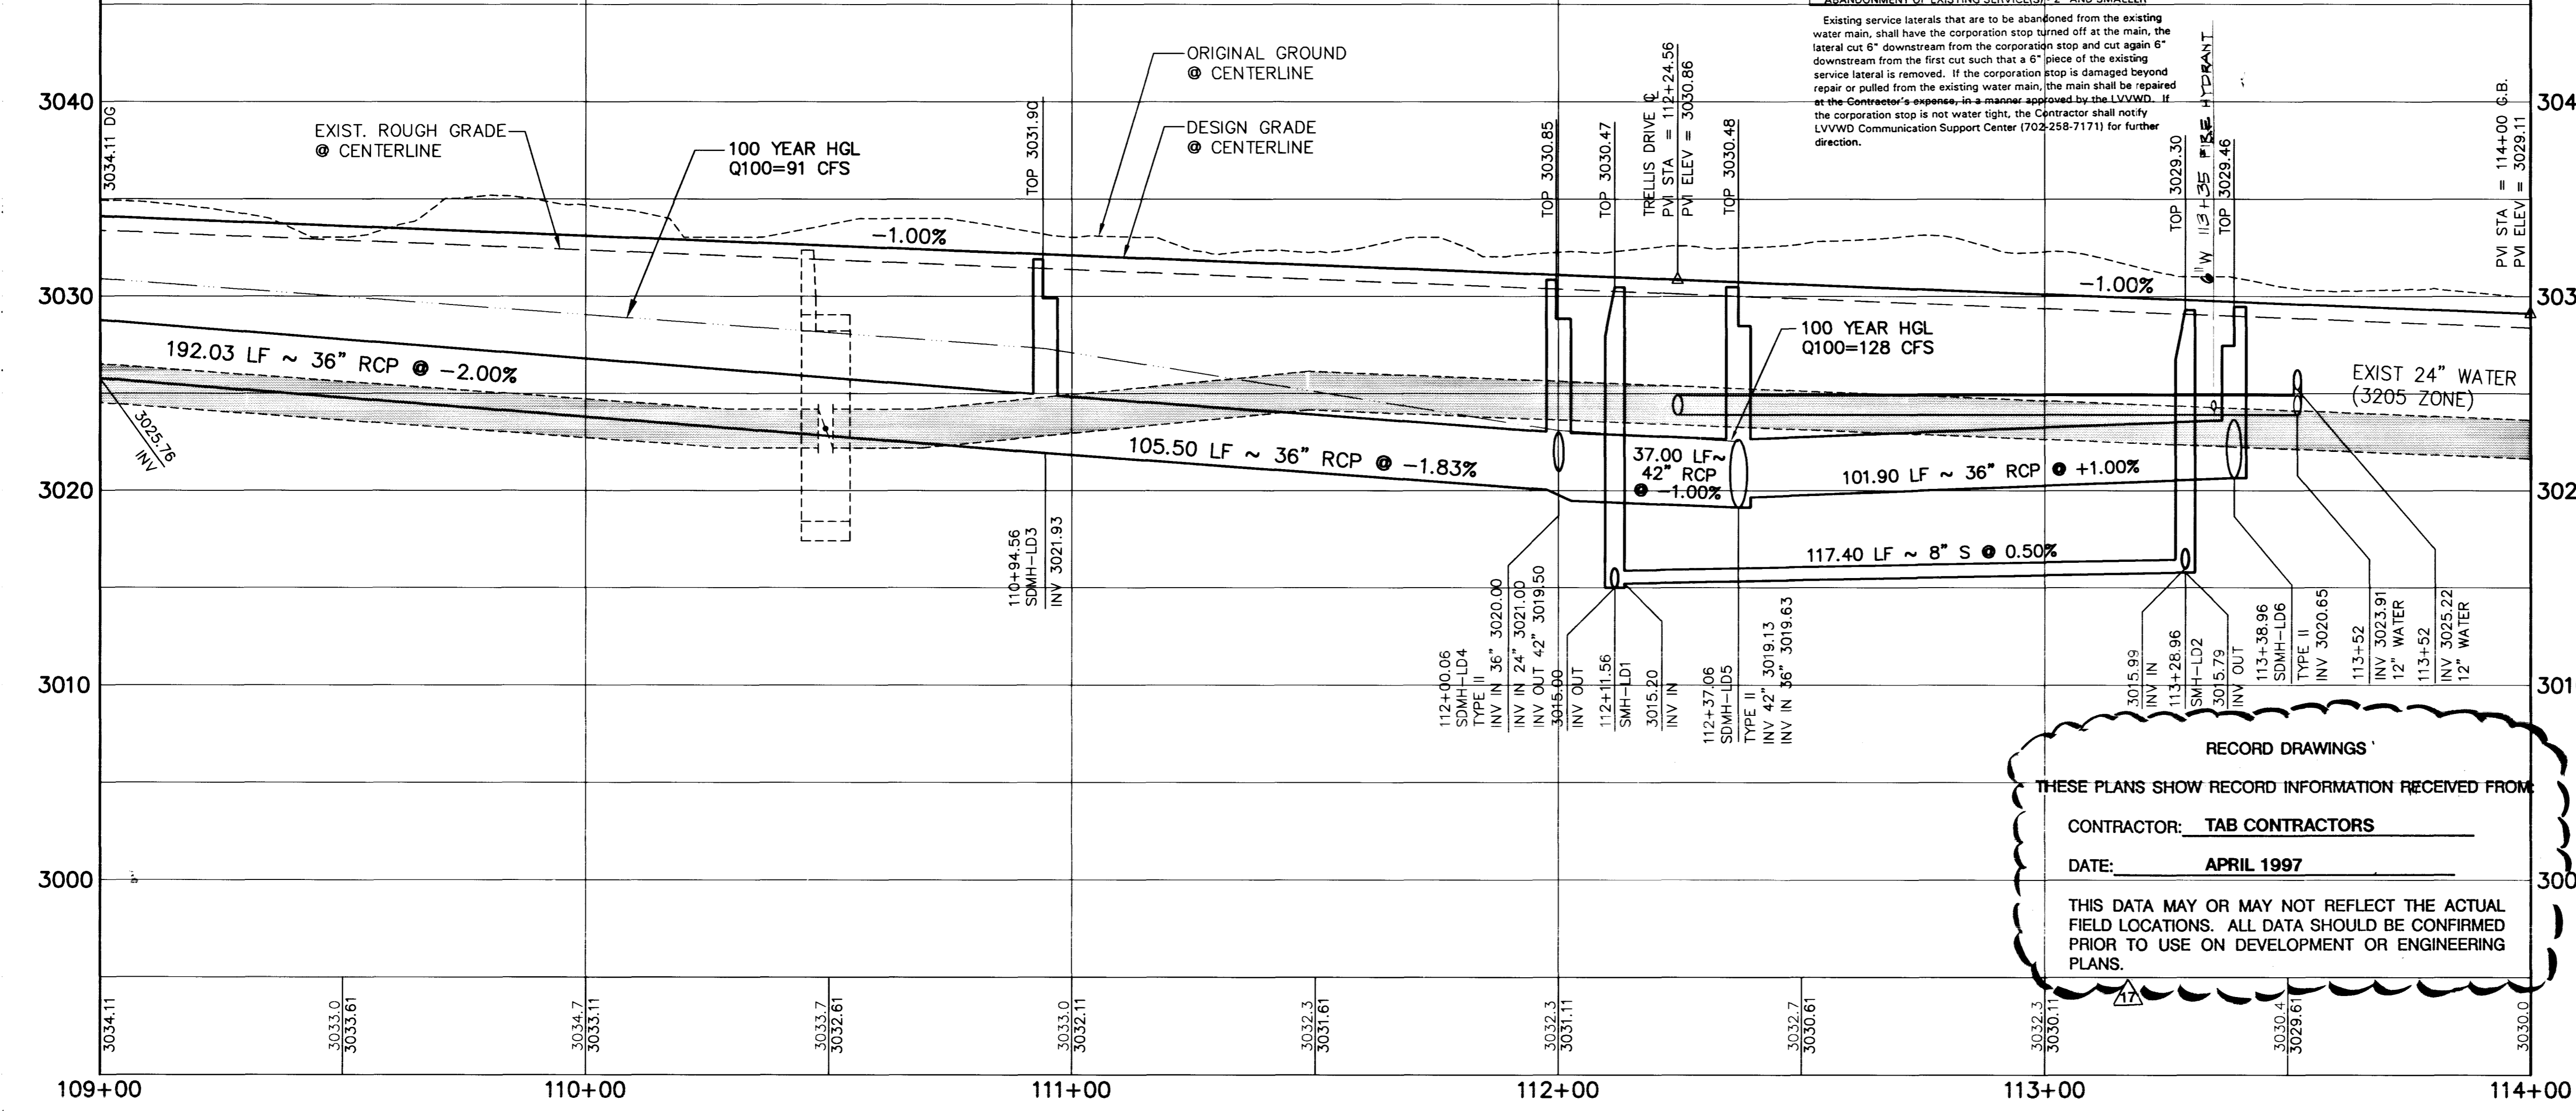



Job No. 62011.212 August 07, 1996 1:13:07 p.m. Drawing: C:\DWG\11-12\12A\LOOP-PPS.DWG Drawing: C:\DWG\11-12\12A\LOOP-PPS.DWG Xrefs: XR-LOOP.DWG LOOP.TOP.DWG LOOP.SID.DWG

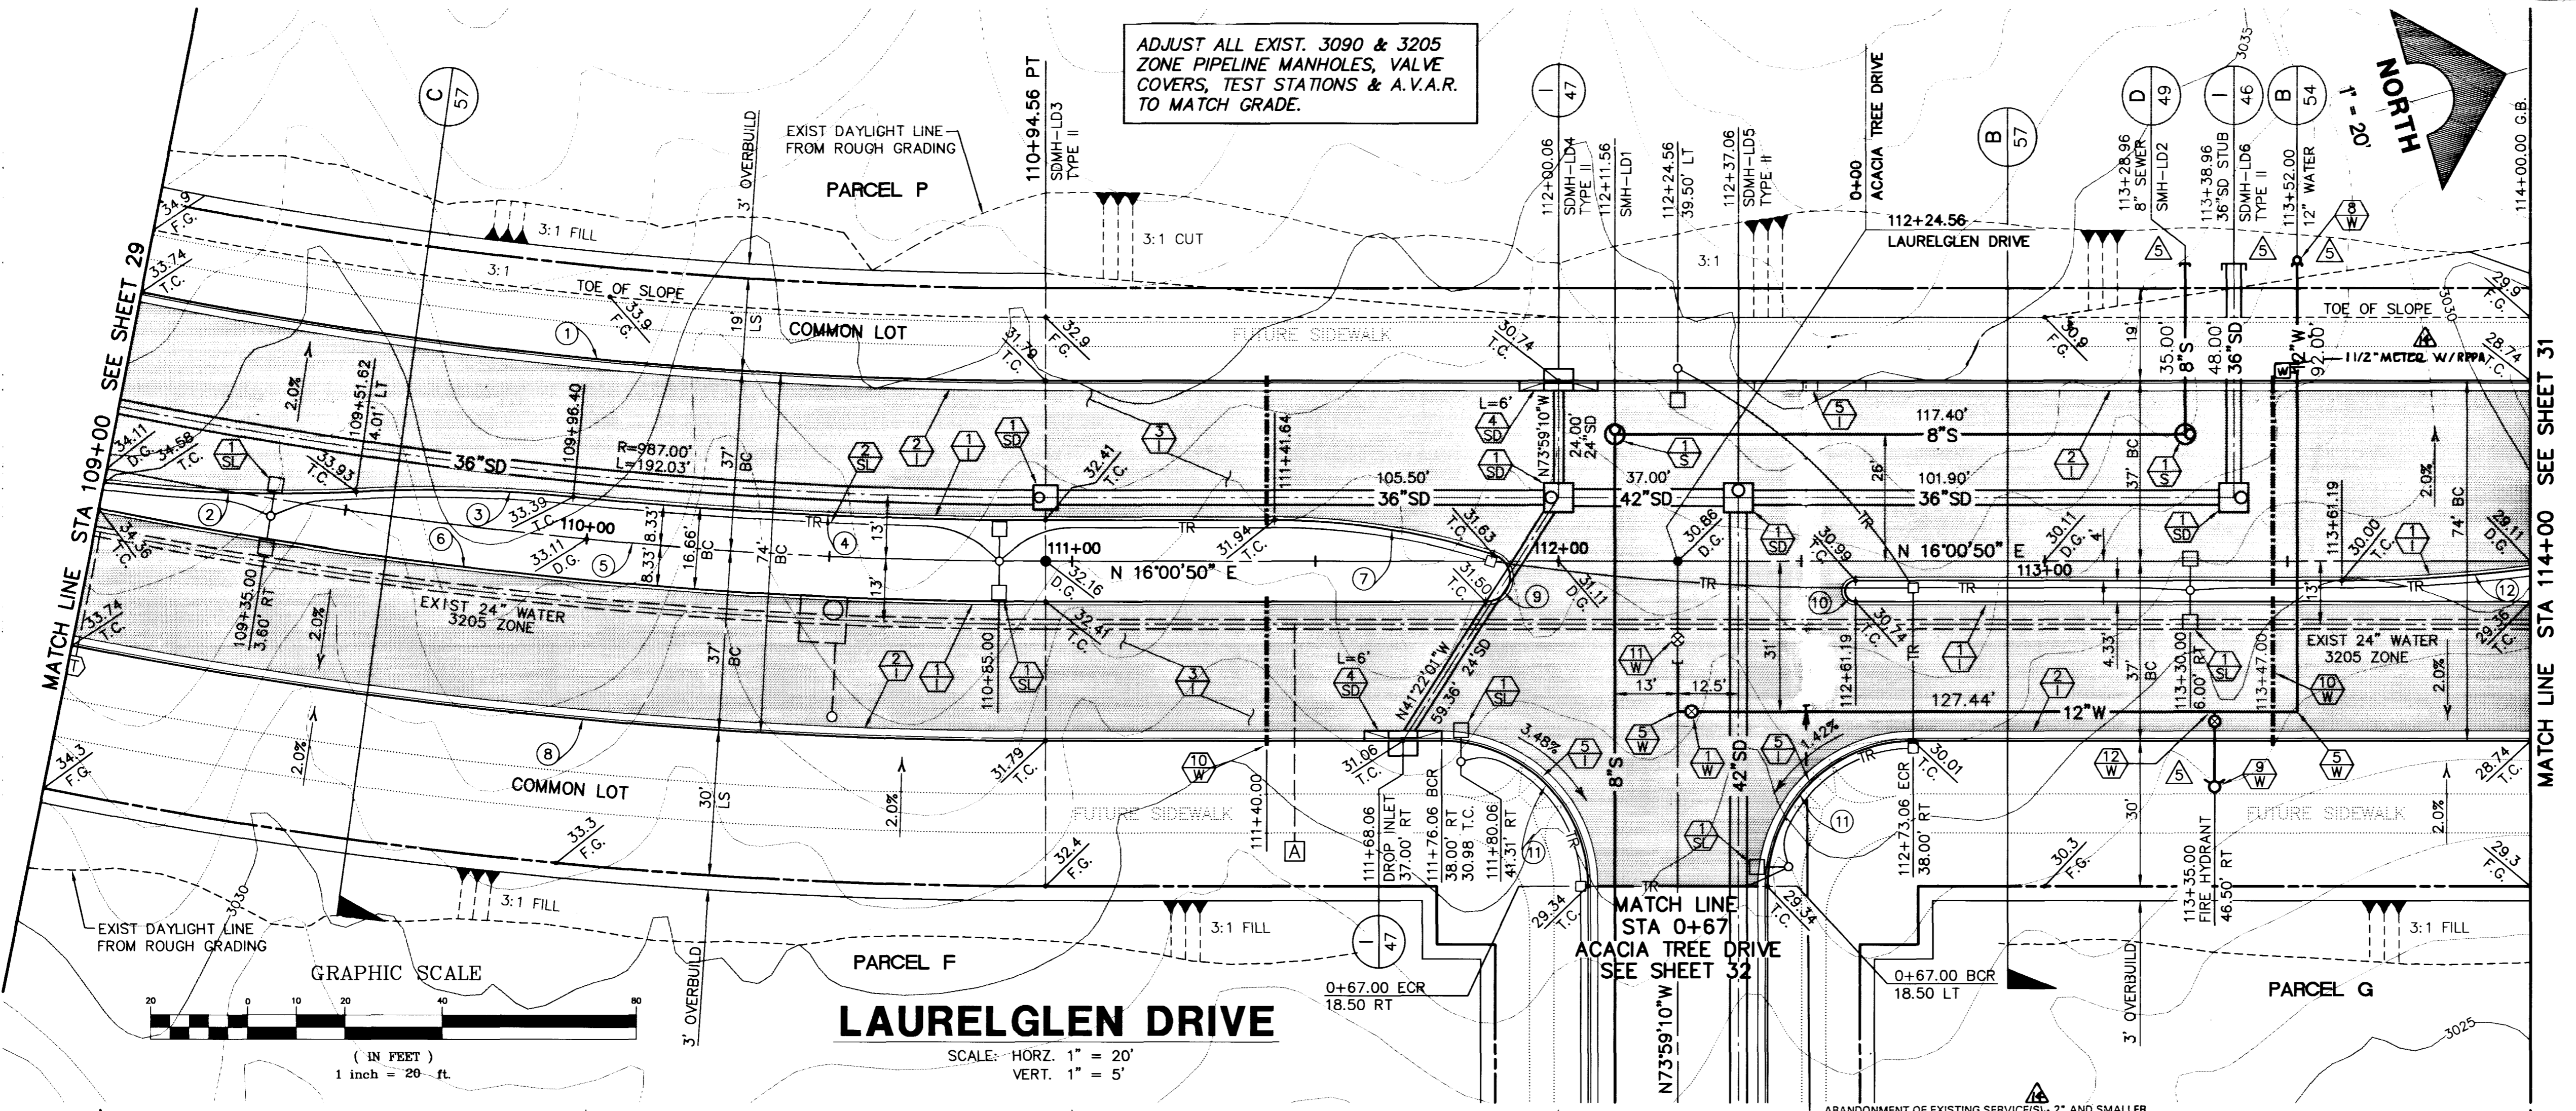

INDICATES CURVE NUMBER (THIS SHEET ONLY)

CURVE	DELTA	RADIUS	LENGTH	TANGENT
1	1108.52	963.00	187.37	93.98
2	99.70	300.00	52.11	26.12
3	08.32.44	300.00	44.74	22.41
4	05.37.28	991.67	97.35	48.71
5	1108.52	1000.00	194.57	97.59
6	1108.52	1000.00	194.57	97.59
7	1726.46	150.00	45.67	23.02
8	1108.52	1037.00	201.76	101.20
9	162.33.14	5.00	14.19	32.59
10	180.00.00	2.17	6.82	17.00
11	90.00.00	30.00	47.12	30.00
12	0726.00	300.00	38.92	19.49

- CONSTRUCTION NOTES**
- IMPROVEMENTS**
- INSTALL "A" TYPE CURB (S-50)
 - INSTALL "L" TYPE CURB & GUTTER (S-47)
 - INSTALL AC PAVEMENT PER SECTION SHEETS 56, 57, & 58
 - INSTALL CROSSWALK (S-78)
 - INSTALL DEPRESSED CURB (S-75)
- WATER**
- INSTALL WATER PIPES PER SUMMERLIN STD. U-20
 - INSTALL 12" DIA. GATE VALVE & BOX (U-34)
 - INSTALL 8" DIA. GATE VALVE & BOX (U-34)
 - INSTALL 12"x12"x12" TEE
 - INSTALL 12"x12"x12"x12" CROSS
 - INSTALL 12"x12" ELBOW
 - INSTALL 12"x12"x8" TEE
 - INSTALL 12"x12"x8"x6" CROSS (U-32)
 - INSTALL 2" TEMP. BLOW-OFF & CAP (U-33)
 - INSTALL FIRE HYDRANT ASSEMBLY COMPLETE PER (U-18)
 - IRRIGATION SLEEVE (U-18)
 - EXISTING GATE VALVE MUST BE IN CLOSED POSITION PRIOR TO REMOVAL OF CAP
 - INSTALL 12" X 12" X 6" TEE
- STORM DRAIN**
- INSTALL STORM DRAIN PIPES PER SUMMERLIN STD. U-20
 - INSTALL STORM DRAIN MANHOLE (D1-D10)
 - INSTALL 4" TYPE "A" DROP INLET (D-12)
 - INSTALL TYPE "B" DROP INLET (D-13)
 - INSTALL TYPE "C" MODIFIED DROP INLET (SEE PLANS FOR LENGTH) (D-14)
 - INSTALL 6" TYPE "A" DROP INLET (D-12)
- SEWER**
- INSTALL SEWER PIPES PER SUMMERLIN STD. U-20
 - INSTALL SEWER MANHOLE (SD1-B CLV)
- STREET LIGHTING**
- INSTALL STREET LIGHT, SEE ELECTRICAL PLANS (E-2)
 - STREET LIGHT OR COMMON TRENCH, SEE ELECTRICAL PLANS
- TRAFFIC**
- INSTALL 2-3" CONDUIT (E-32)
 - INSTALL NO. 5 PULLBOX (E-32)

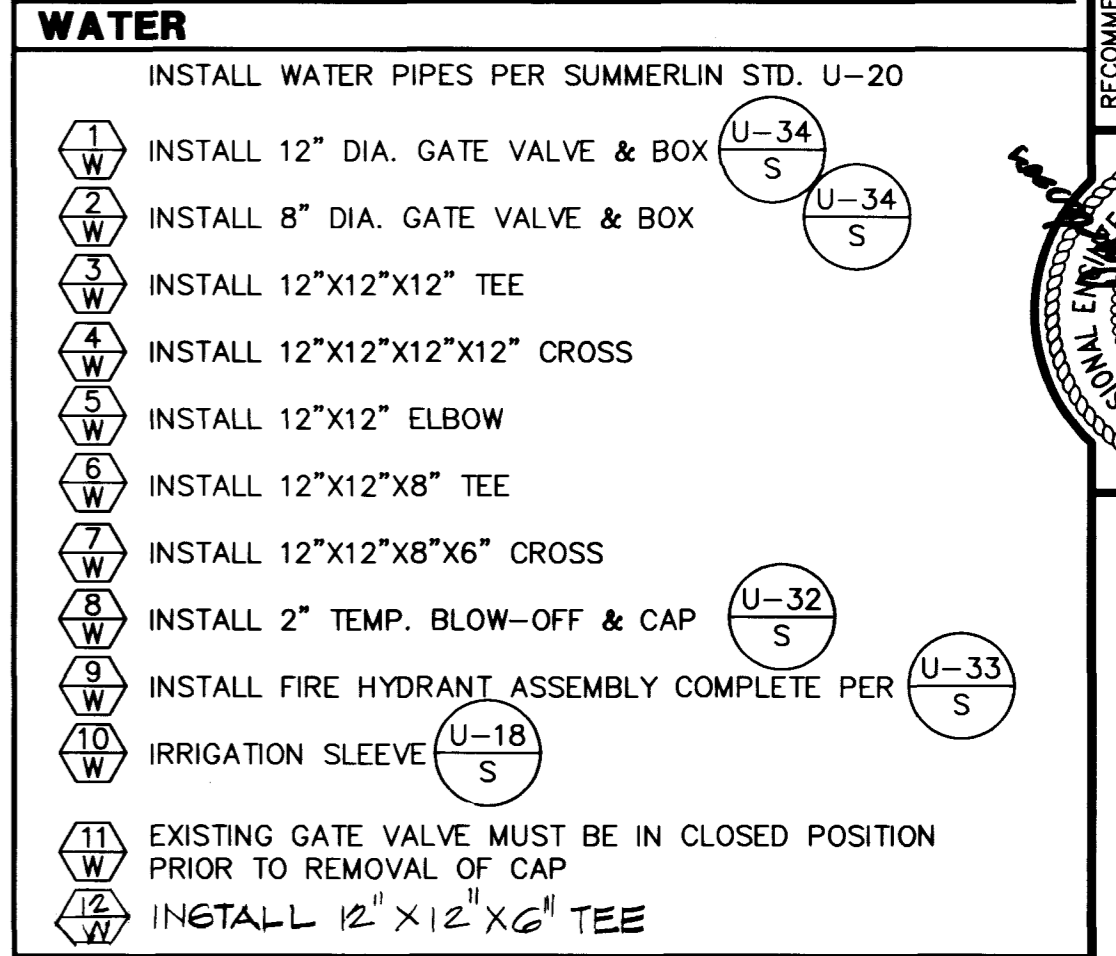

APPROVAL: 1ST MPM 5-31-96

DATE: 8-28-96

LAS VEGAS VALLEY WATER DISTRICT

SUMMERLIN VILLAGE 11/12 THE ARBORS - UNIT 2A LAUREL GLEN DRIVE PLAN & PROFILE STA 109+00 TO 114+00

SHEET 30

SHT 30 OF 65

FINAL SUBMITTAL

RECOMMENDED RECORD DRAWING INFORMATION

DATE: 05/05/98

REVISION: 1

REV. ST. NAME: CHRISTOPHER W. ANDERSON

DATE: 11/15/98

REVISION: 2

REV. ST. NAME: ANDERSON

DATE: 11/15/98

REVISION: 3

REV. ST. NAME: ANDERSON

DATE: 11/15/98

REVISION: 4

REV. ST. NAME: ANDERSON

DATE: 11/15/98

REVISION: 5

REV. ST. NAME: ANDERSON

DATE: 11/15/98

REVISION: 6

REV. ST. NAME: ANDERSON

DATE: 11/15/98

REVISION: 7

REV. ST. NAME: ANDERSON

DATE: 11/15/98

REVISION: 8

REV. ST. NAME: ANDERSON

DATE: 11/15/98

REVISION: 9

REV. ST. NAME: ANDERSON

DATE: 11/15/98

REVISION: 10

REV. ST. NAME: ANDERSON

DATE: 11/15/98

REVISION: 11

REV. ST. NAME: ANDERSON

DATE: 11/15/98

REVISION: 12

REV. ST. NAME: ANDERSON

DATE: 11/15/98

REVISION: 13

REV. ST. NAME: ANDERSON

DATE: 11/15/98

REVISION: 14

REV. ST. NAME: ANDERSON

DATE: 11/15/98

REVISION: 15

REV. ST. NAME: ANDERSON


REV. ST. NAME: ANDERSON

DATE: 11/15/98

REVISION: 100

REV. ST. NAME: ANDERSON

DATE: 11/15/98

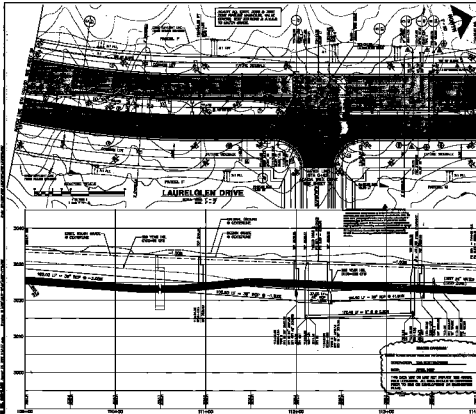

SHOULDER DATA

STATION	WIDTH	FINISH	GRADE	THICKNESS
108+00				
108+10				
108+20				
CONSTRUCTION NOTES

1. SHALL BE THE SAME AS THE ROAD & SIDE DRIVE.
2. SHALL BE PROVIDED FOR THE ENTIRE LENGTH OF THE ROAD.
3. SHALL BE PROVIDED FOR THE ENTIRE LENGTH OF THE ROAD.
4. SHALL BE PROVIDED FOR THE ENTIRE LENGTH OF THE ROAD.

- GENERAL NOTES**
1. SHALL BE THE SAME AS THE ROAD & SIDE DRIVE.
 2. SHALL BE PROVIDED FOR THE ENTIRE LENGTH OF THE ROAD.
 3. SHALL BE PROVIDED FOR THE ENTIRE LENGTH OF THE ROAD.
 4. SHALL BE PROVIDED FOR THE ENTIRE LENGTH OF THE ROAD.
 5. SHALL BE PROVIDED FOR THE ENTIRE LENGTH OF THE ROAD.
 6. SHALL BE PROVIDED FOR THE ENTIRE LENGTH OF THE ROAD.
 7. SHALL BE PROVIDED FOR THE ENTIRE LENGTH OF THE ROAD.
 8. SHALL BE PROVIDED FOR THE ENTIRE LENGTH OF THE ROAD.
 9. SHALL BE PROVIDED FOR THE ENTIRE LENGTH OF THE ROAD.
 10. SHALL BE PROVIDED FOR THE ENTIRE LENGTH OF THE ROAD.

APPROVAL: [Signature] DATE: 10/10/10

PROJECT: LAURELOLEN DRIVE