




- 1
SIG INSTALL 2-3" CONDUIT
- 2
SIG INSTALL NO. 5 PULLBOX

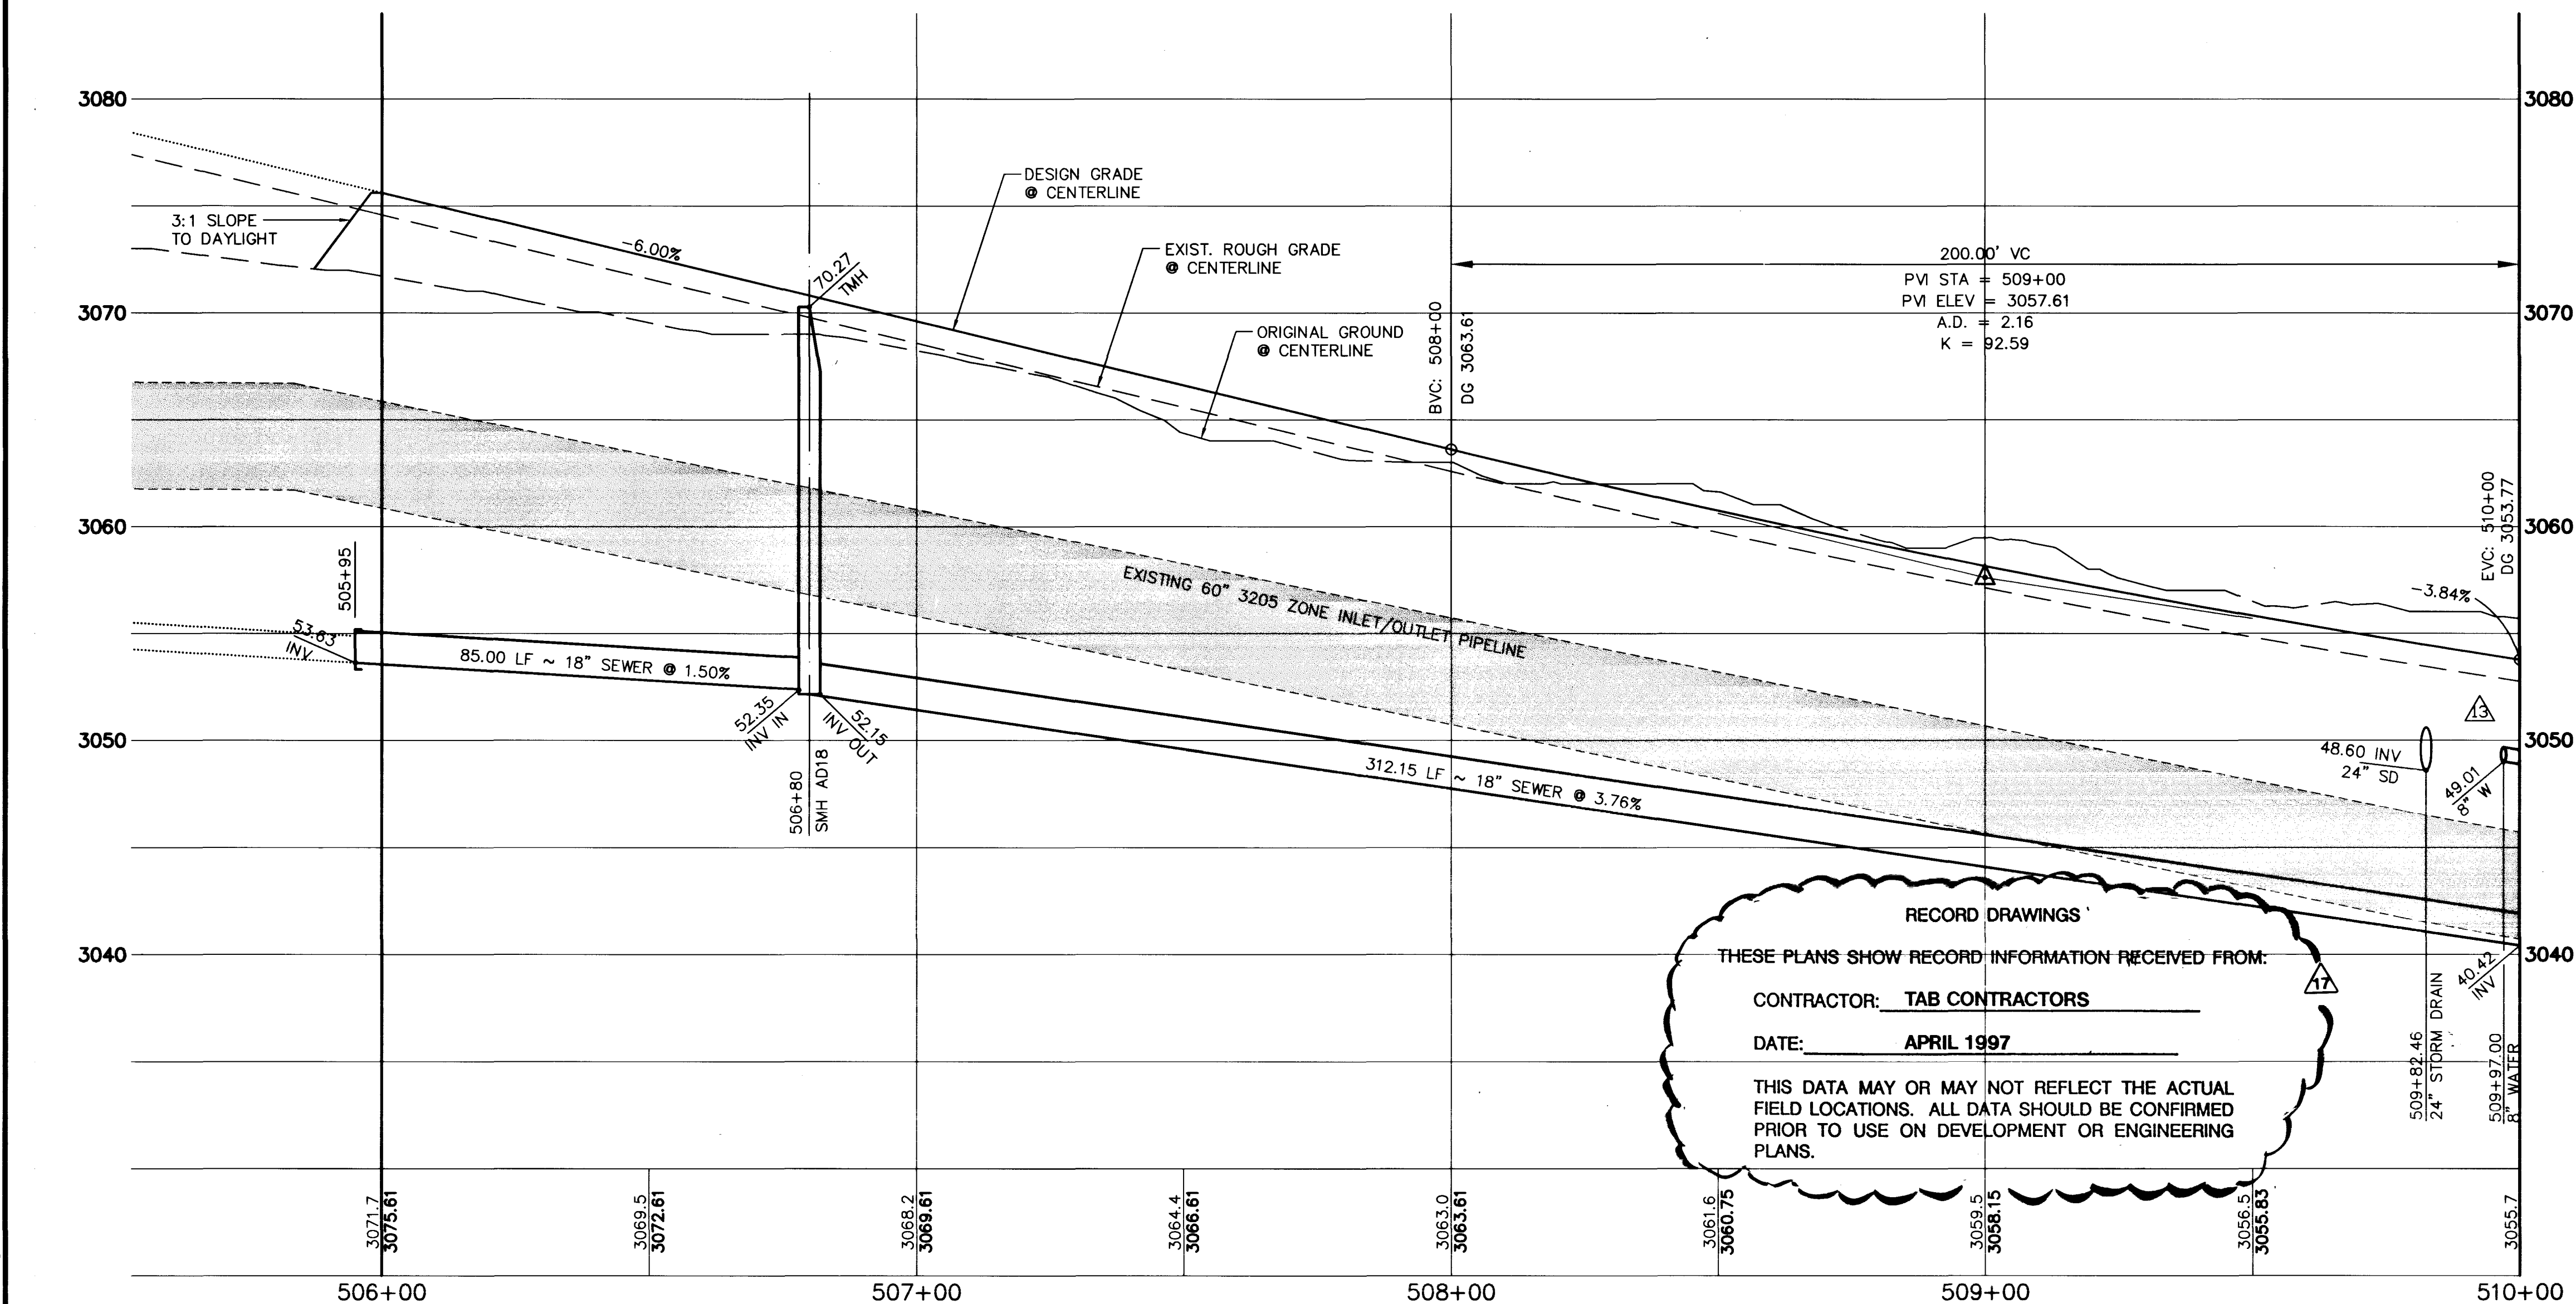

1270 JB 1-14-97
LAS VEGAS VALLEY WATER DISTRICT DATE



SHEET 10	SUMMERLIN VILLAGE 11/12 THE ARBORS - UNIT 2A ALTA DRIVE PLAN & PROFILE STA 806+00 TO 810+00	 G.C. WALLACE, INC. Engineering/Architecture 1555 SOUTH RANNESE BLVD LAS VEGAS, NEVADA 89102		RECOMMENDED	05/05/98 RECORD DRAWING INFORMATION	
				CHRISTOPHER W. ANDERSON	1/28/98	REV. ST. NAME
				BY 08/97 ADD WATER SUB TO PARCEL NN-1	11/17	
				BY 07/97 ADJUSTMENT DELETE		
				STUD TO PARCEL NN-1		
				REV. TYPE "B" D.I. TO TYPE "C" MOD		
				R.F.E. NO. 5071	DATE	DATE
						APPROVAL
				FINAL SUBMITTAL		

DATE: 10/10/68 BY: J. L. BROWN

PROJECT: 107Y-4468-2A

SCALE: 1" = 100'

107Y-4468-2A

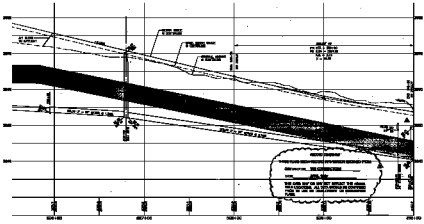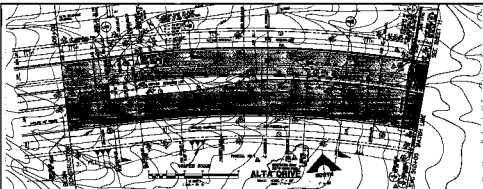

NOTES:
1. THE PROPOSED ROAD PROFILE IS BASED ON THE EXISTING GROUND PROFILE.
2. THE PROPOSED ROAD PROFILE IS BASED ON THE EXISTING GROUND PROFILE.
3. THE PROPOSED ROAD PROFILE IS BASED ON THE EXISTING GROUND PROFILE.

DATE	BY	CHKD	APPD	REV
10/10/68	J. L. BROWN			

THESE NOTES APPLY TO THE ENTIRE PROJECT AND SHOULD BE READ IN CONJUNCTION WITH THE SPECIFICATIONS.

GENERAL NOTES

- 1. ALL DIMENSIONS ARE IN FEET AND INCHES.
- 2. ALL DIMENSIONS ARE TO FACE UNLESS OTHERWISE NOTED.
- 3. ALL DIMENSIONS ARE TO FACE UNLESS OTHERWISE NOTED.
- 4. ALL DIMENSIONS ARE TO FACE UNLESS OTHERWISE NOTED.
- 5. ALL DIMENSIONS ARE TO FACE UNLESS OTHERWISE NOTED.

NOTES

- 1. ALL DIMENSIONS ARE IN FEET AND INCHES.
- 2. ALL DIMENSIONS ARE TO FACE UNLESS OTHERWISE NOTED.
- 3. ALL DIMENSIONS ARE TO FACE UNLESS OTHERWISE NOTED.
- 4. ALL DIMENSIONS ARE TO FACE UNLESS OTHERWISE NOTED.
- 5. ALL DIMENSIONS ARE TO FACE UNLESS OTHERWISE NOTED.

NOTES

- 1. ALL DIMENSIONS ARE IN FEET AND INCHES.
- 2. ALL DIMENSIONS ARE TO FACE UNLESS OTHERWISE NOTED.
- 3. ALL DIMENSIONS ARE TO FACE UNLESS OTHERWISE NOTED.
- 4. ALL DIMENSIONS ARE TO FACE UNLESS OTHERWISE NOTED.
- 5. ALL DIMENSIONS ARE TO FACE UNLESS OTHERWISE NOTED.



CROSS SECTION

APPROVED: 10/10/68

107Y-4468-2A