



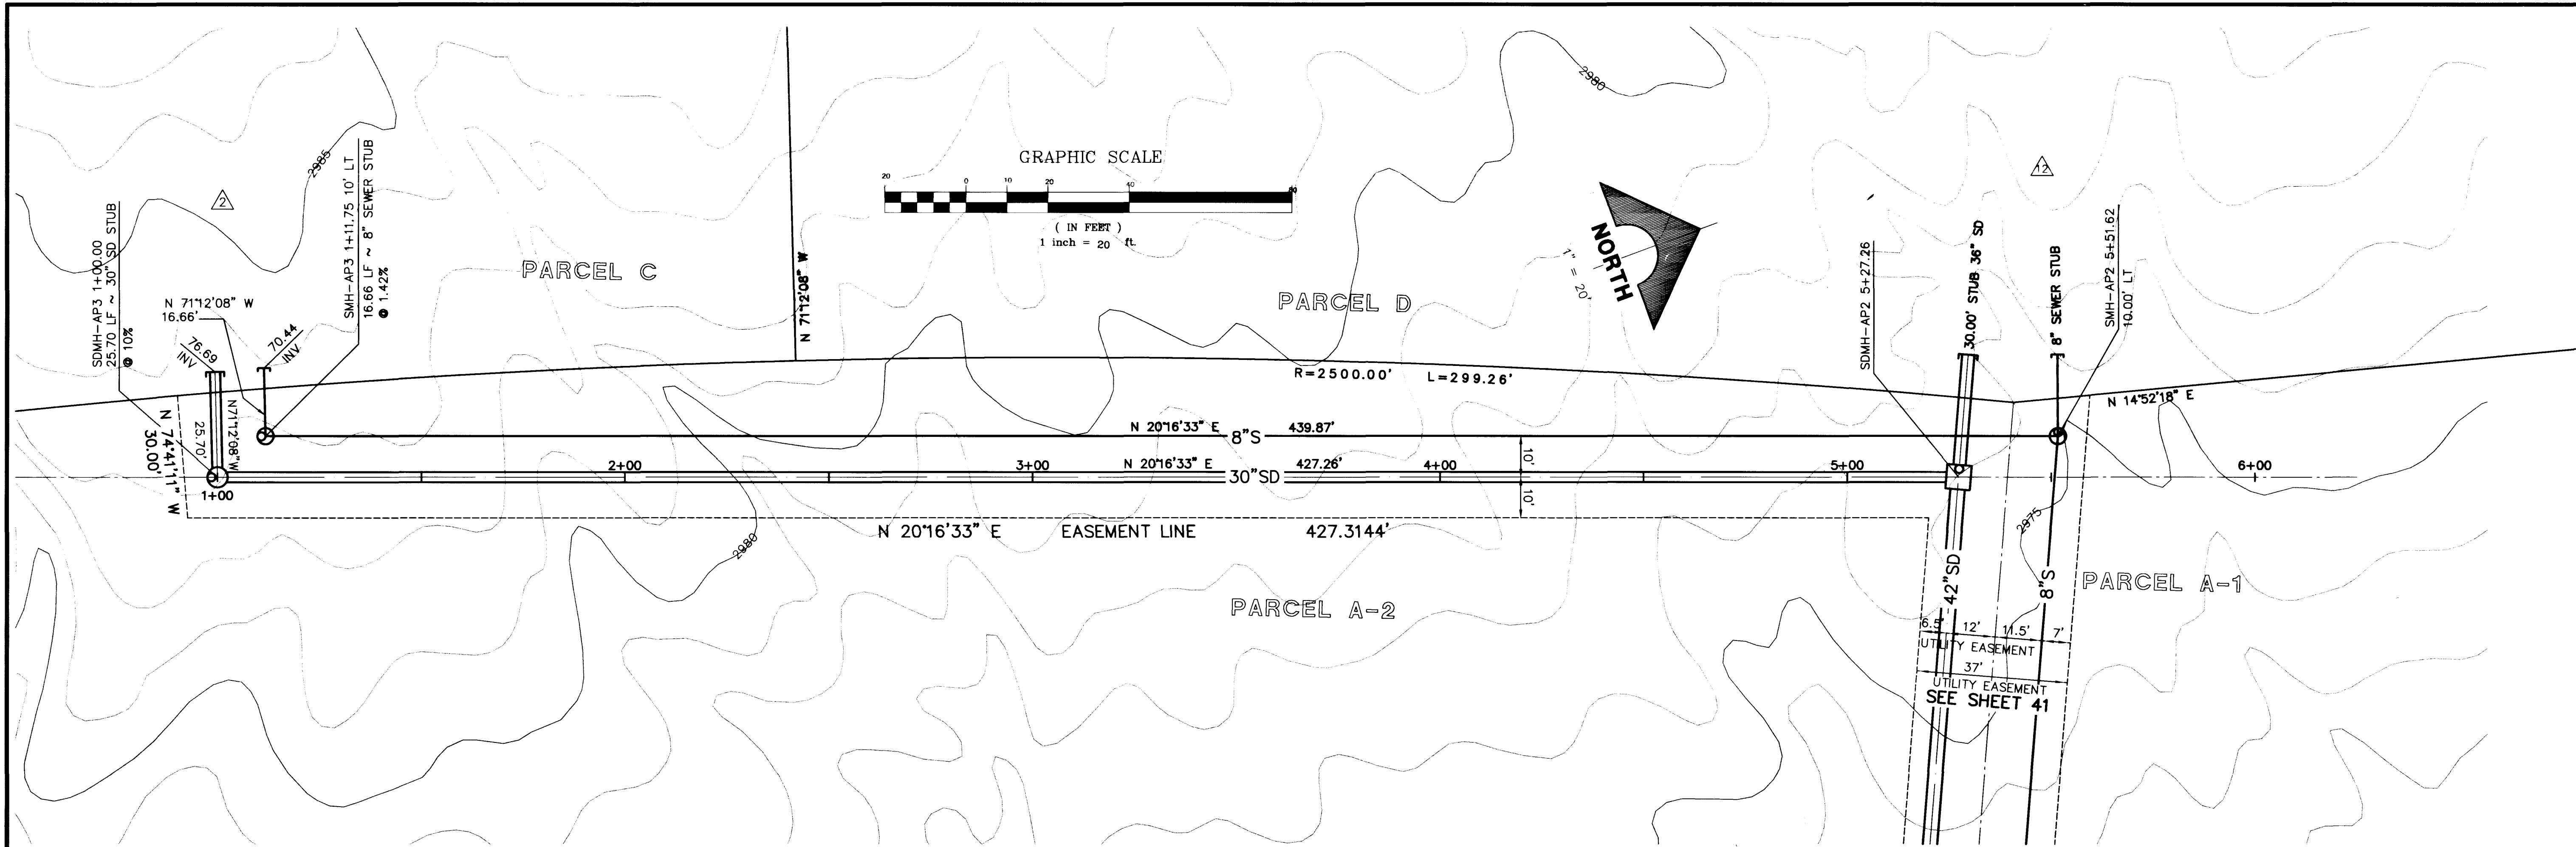


INTER-PARCEL UTILITY

SCALE: HORIZ. 1" = 20'
VERT. 1" = 5'

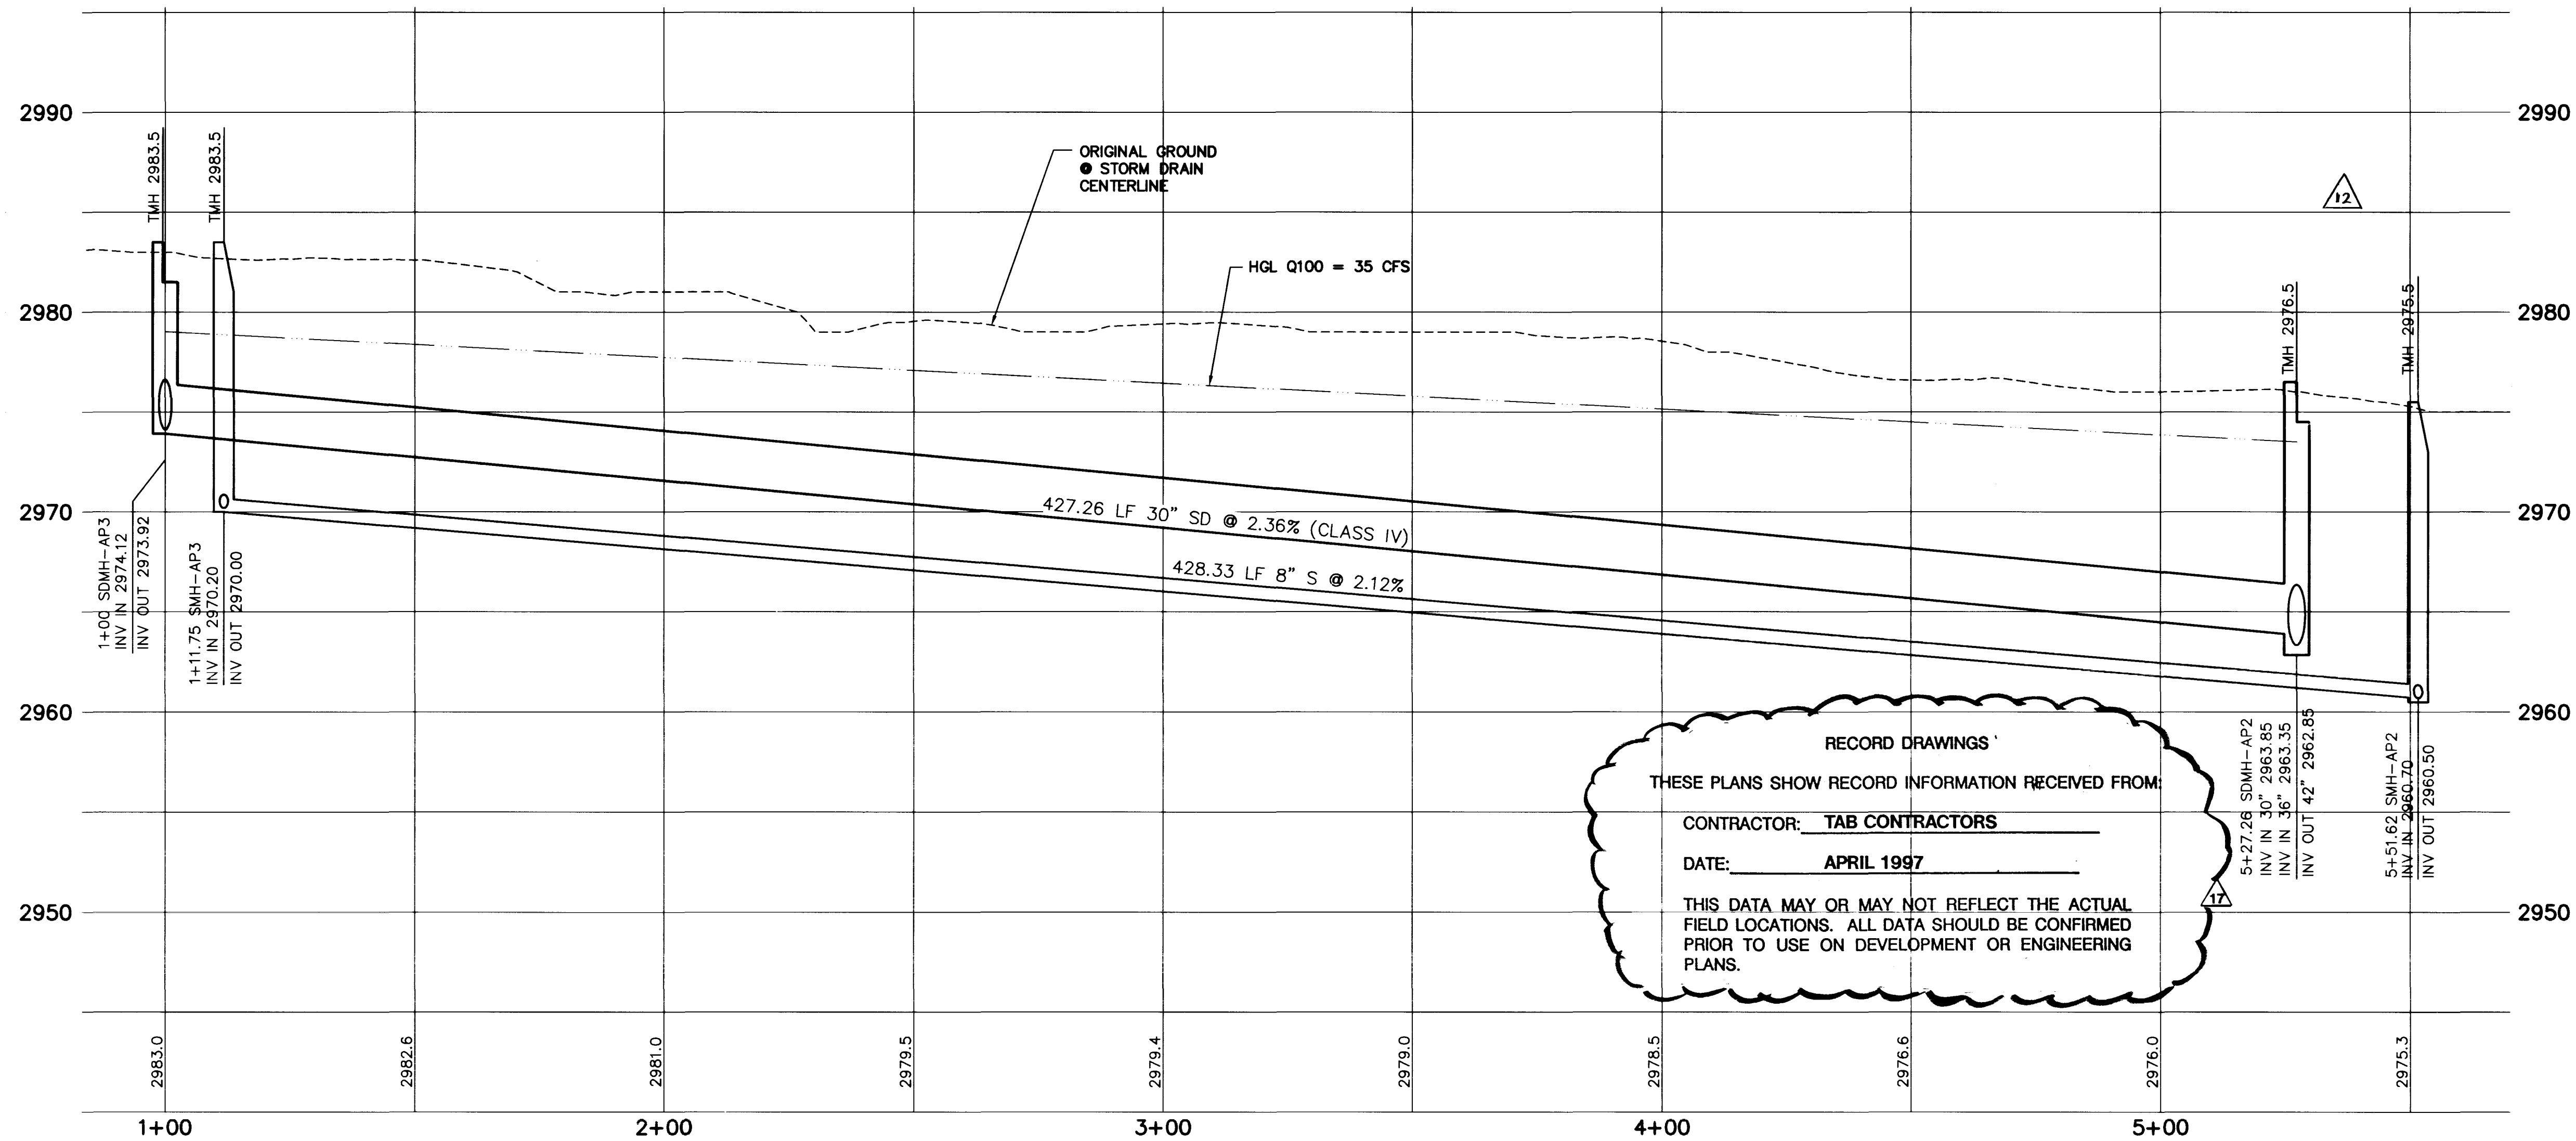

RECORD DRAWINGS
THESE PLANS SHOW RECORD INFORMATION RECEIVED FROM:
CONTRACTOR: TAB CONTRACTORS
DATE: APRIL 1997
THIS DATA MAY OR MAY NOT REFLECT THE ACTUAL
FIELD LOCATIONS. ALL DATA SHOULD BE CONFIRMED
PRIOR TO USE ON DEVELOPMENT OR ENGINEERING
PLANS.

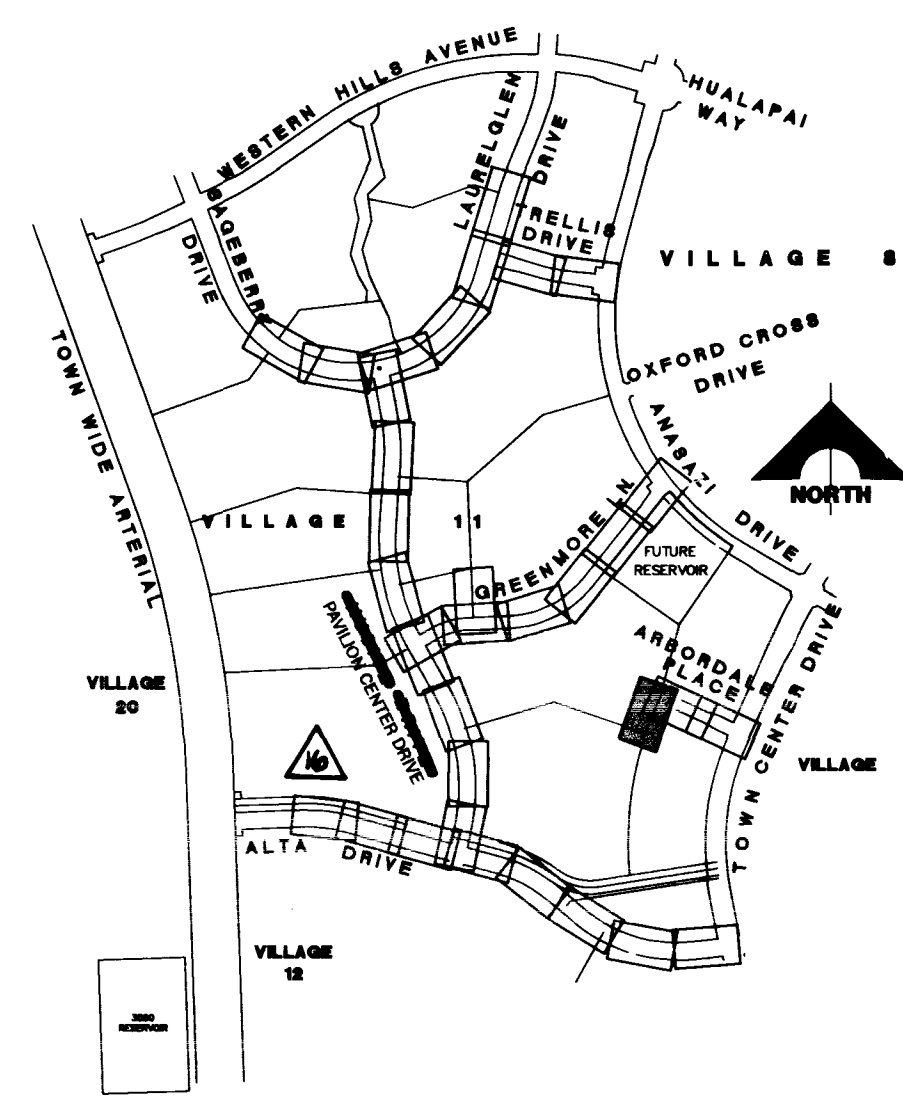


RECORD DRAWING INFORMATION			
NO.	REV.	ST. NAME	DATE
1	1/88	REVISED	1/88
2	11/95	REVISED	11/95
3	7/96	REVISED	7/96
4	11/96	REVISED	11/96
5	11/96	REVISED	11/96
RECOMMENDED
CHRISTOPHER W.
ANDERSON
R.P.E. NO. 5071
DATE
DESCRIPTION

REGISTERED PROFESSIONAL ENGINEER - STATE OF NEVADA
G.C. WALLACE, INC.
Engineering/Architecture
1555 SOUTH RANNEY BLVD./LAS VEGAS, NEVADA 89102

SHEET
43
SHT 43 OF 65

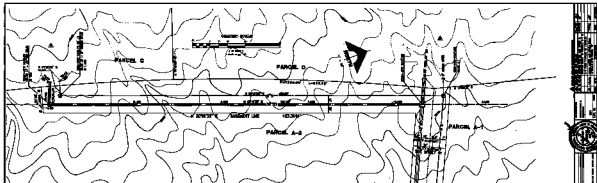

INTER-PARCEL UTILITY

