


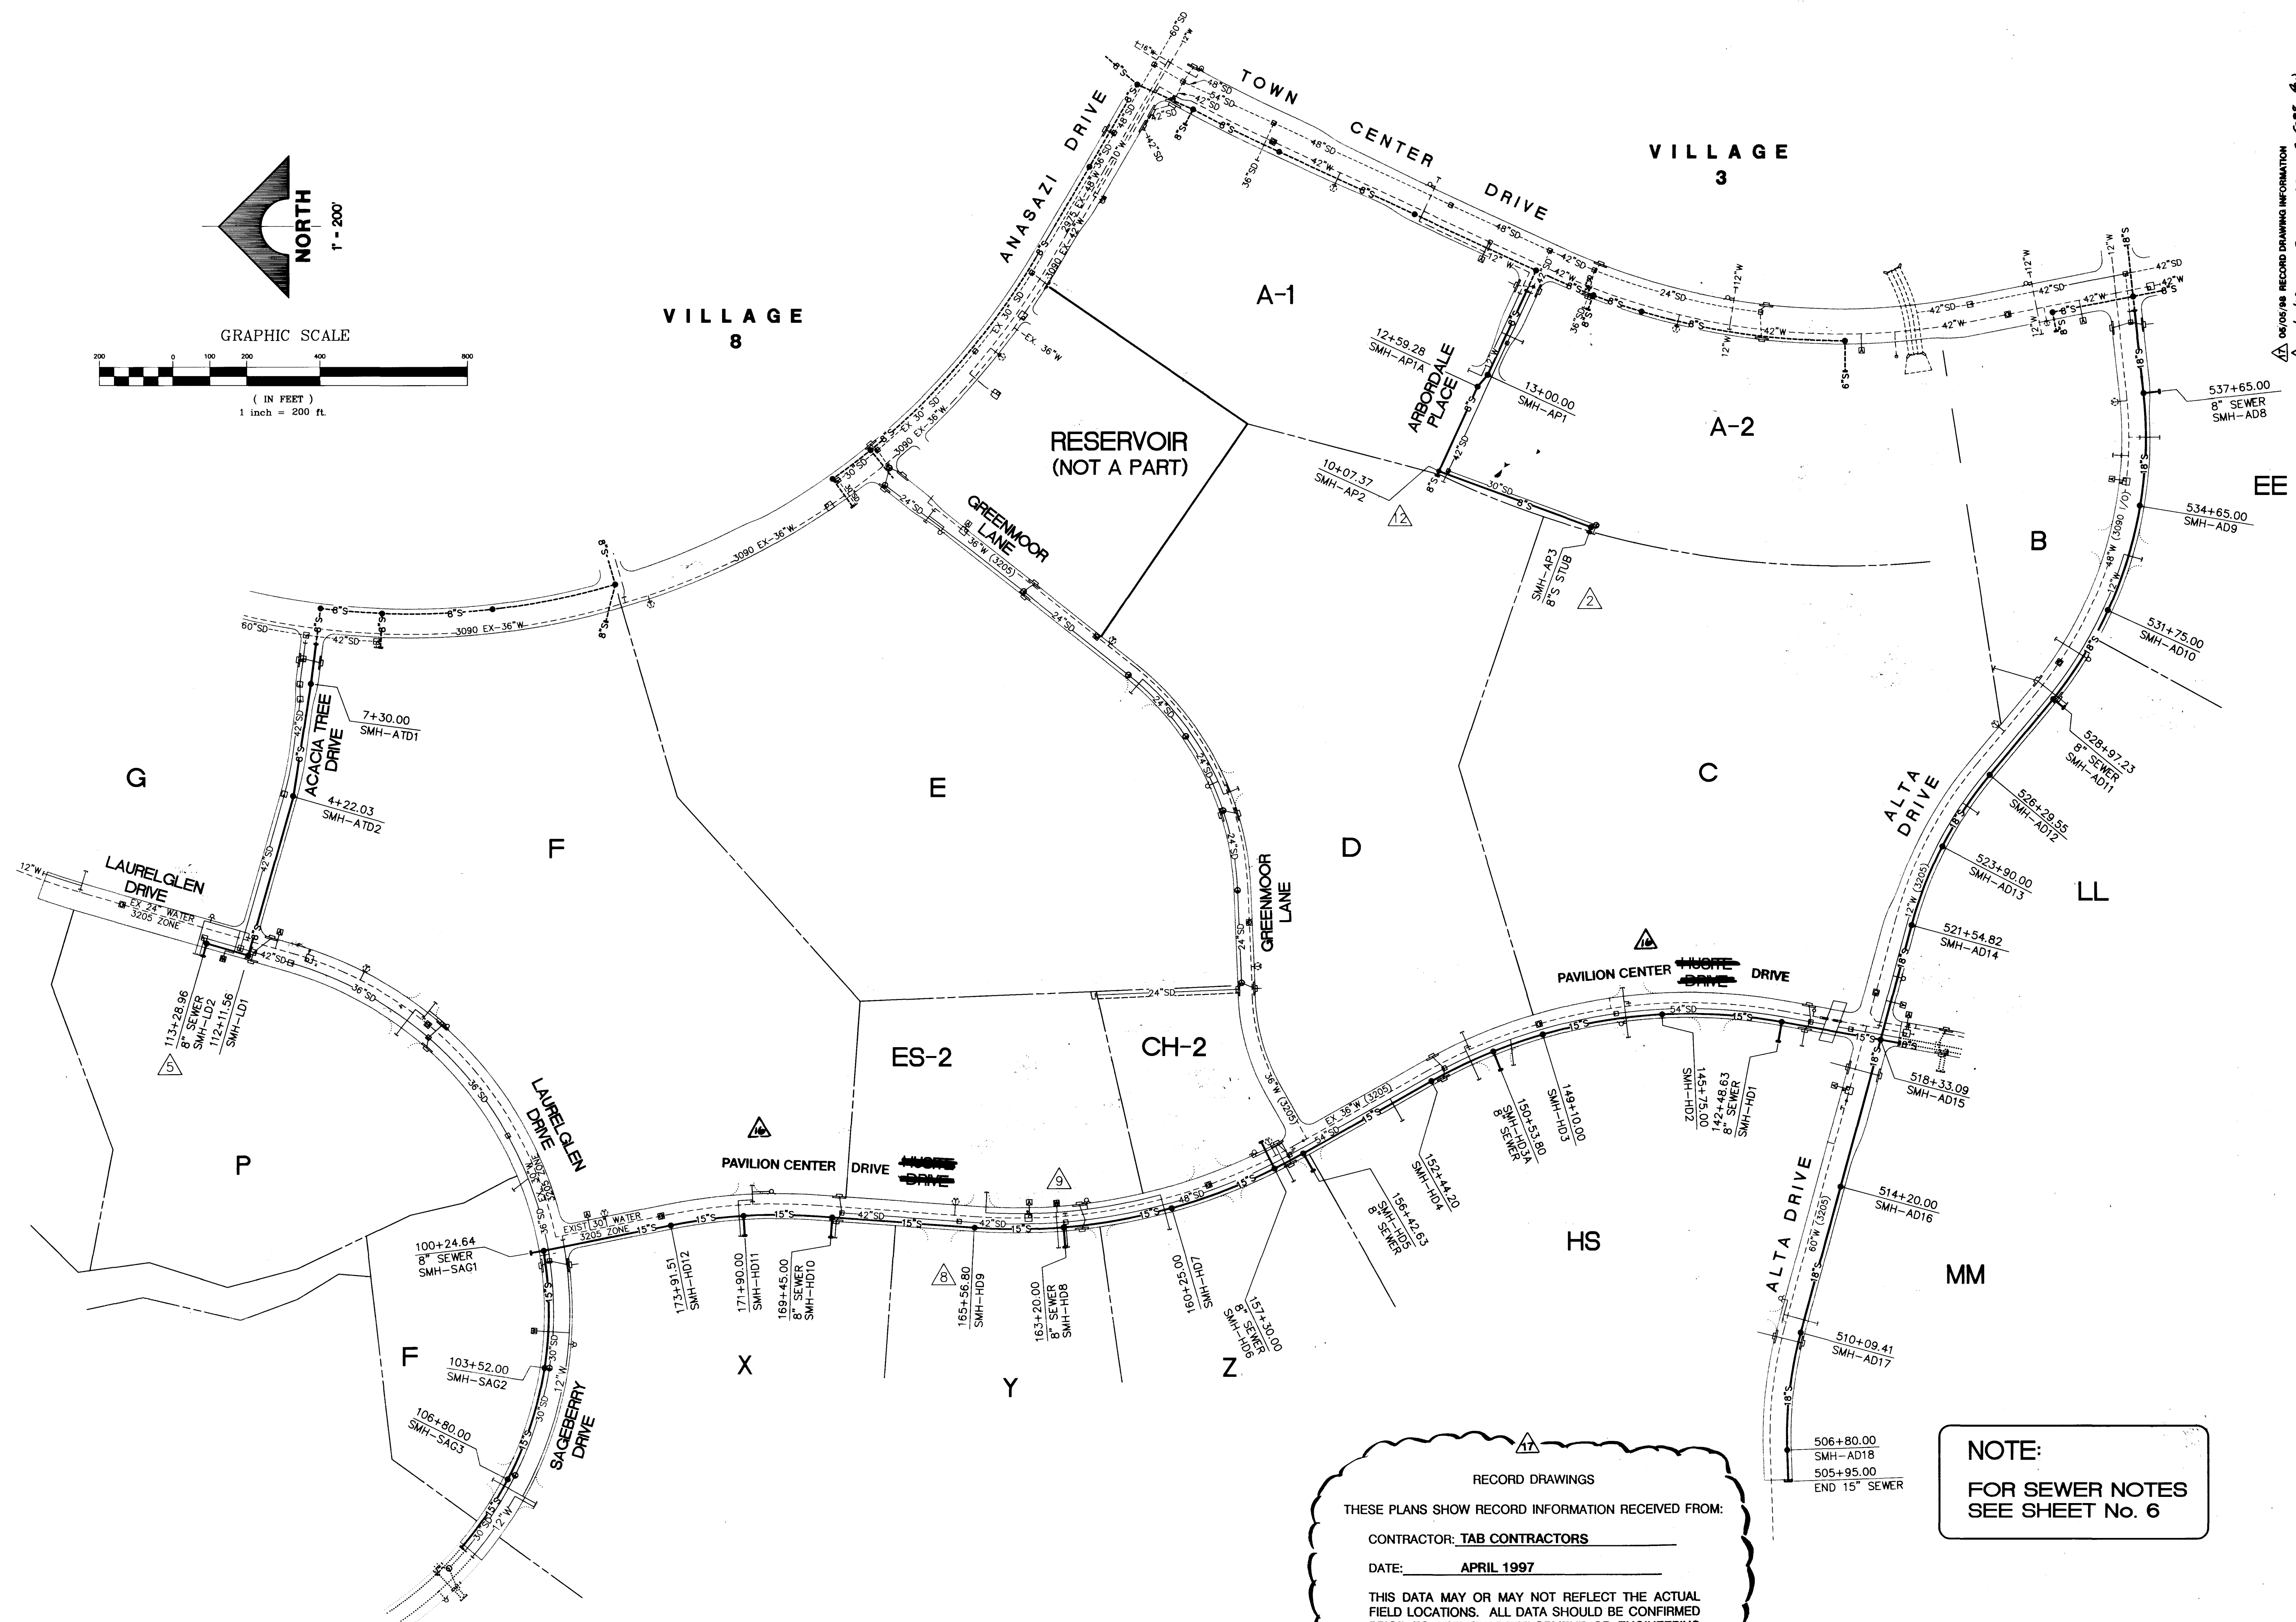

THESE PLANS SHOW RECORD INFORMATION RECEIVED FROM:


CONTRACTOR: TAB CONTRACTORS

DATE: **APRIL 1997**

THIS DATA MAY OR MAY NOT REFLECT THE ACTUAL
FIELD LOCATIONS. ALL DATA SHOULD BE CONFIRMED
PRIOR TO USE ON DEVELOPMENT OR ENGINEERING
PLANS.

NOTE:
FOR SEWER NOTES
SEE SHEET No. 6

17	05/05/98	RECORD DRAWING INFORMATION	
18	1/25/98	REV. ST NAMES	3-5-98 <i>AL</i>
19	11/25/98	MODIFIED UTILITIES AND MOVE & MODIFY ENTRY TO PARCELS A-1 & A-2 FROM 11+/-9.68 TO 12+78.28	12/6/98 <i>DB</i>

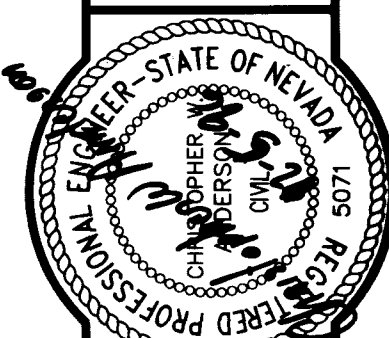

 **G.C. WALLACE, INC.**
Engineering/Architecture 1555 SOUTH RANNEY BLVD./LAS VEGAS, NEVADA 89102

SUMMERLIN
VILLAGE 11/12 THE ARBORS - UNIT 2A
MASTER UTILITY SEWER PLAN

SHEET
9
SHT 9 OF 65

PERSON
DATE
APPROVAL

FINAL SUBMITTAL

