
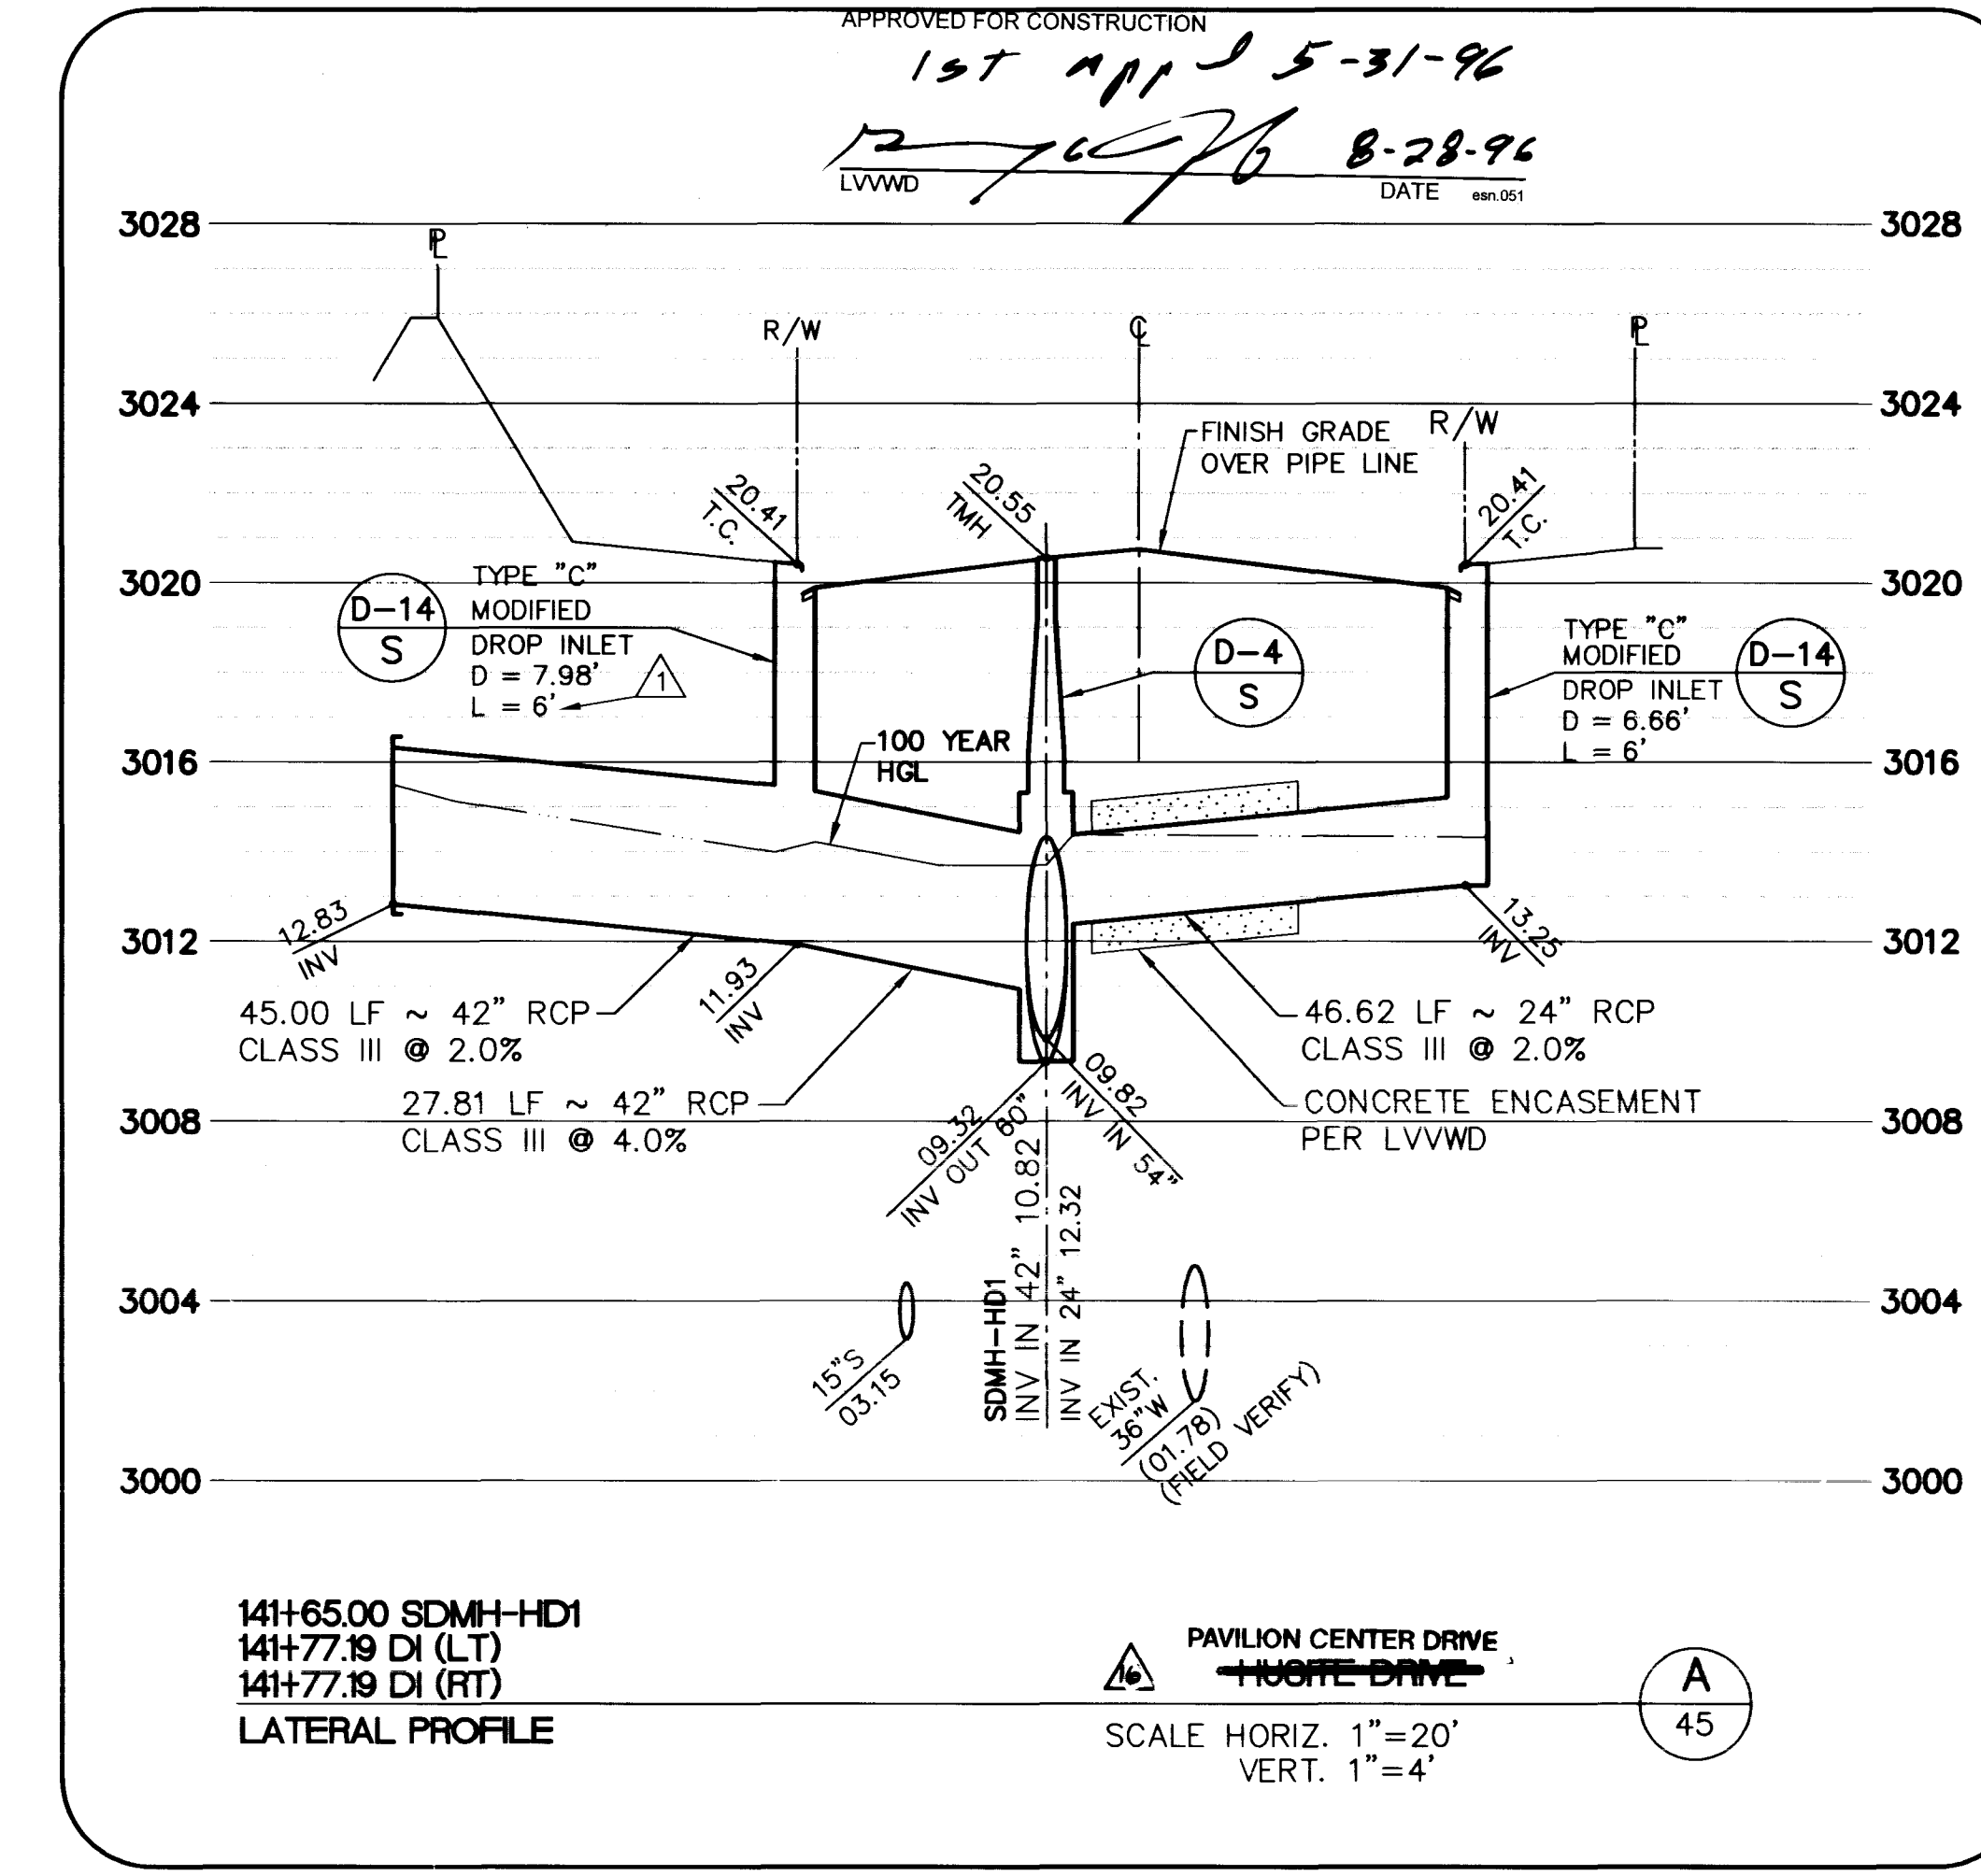
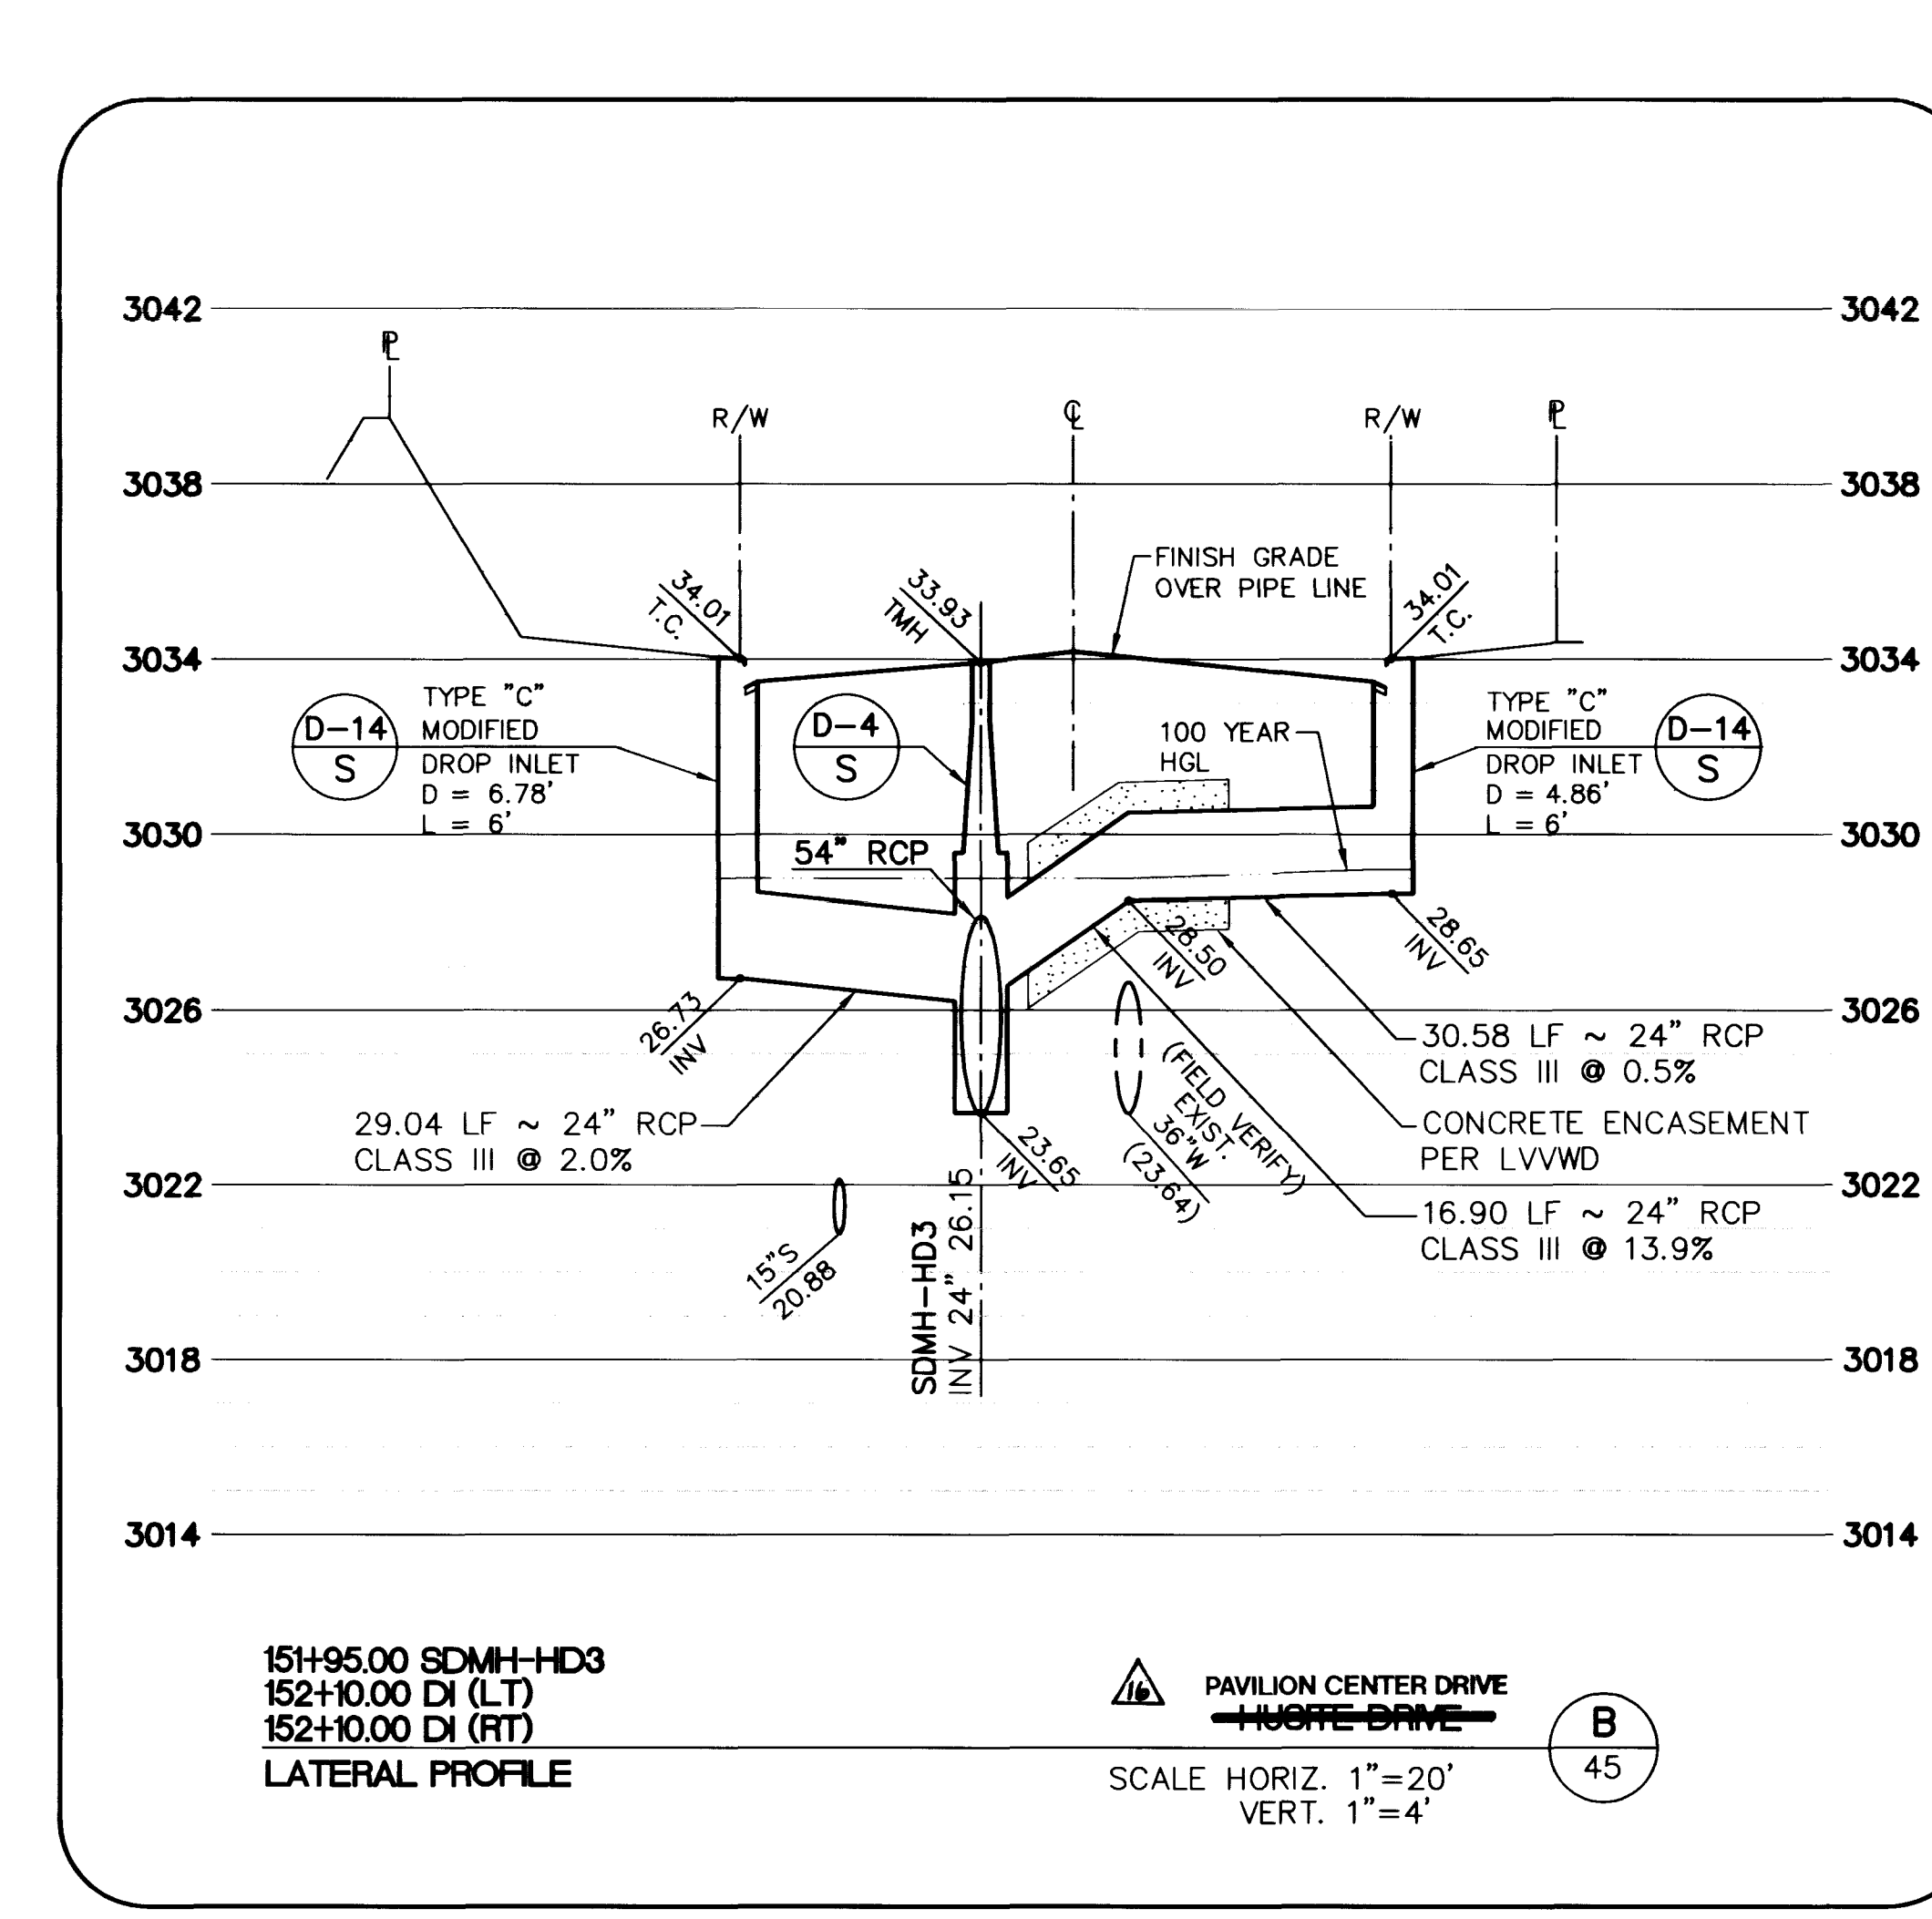
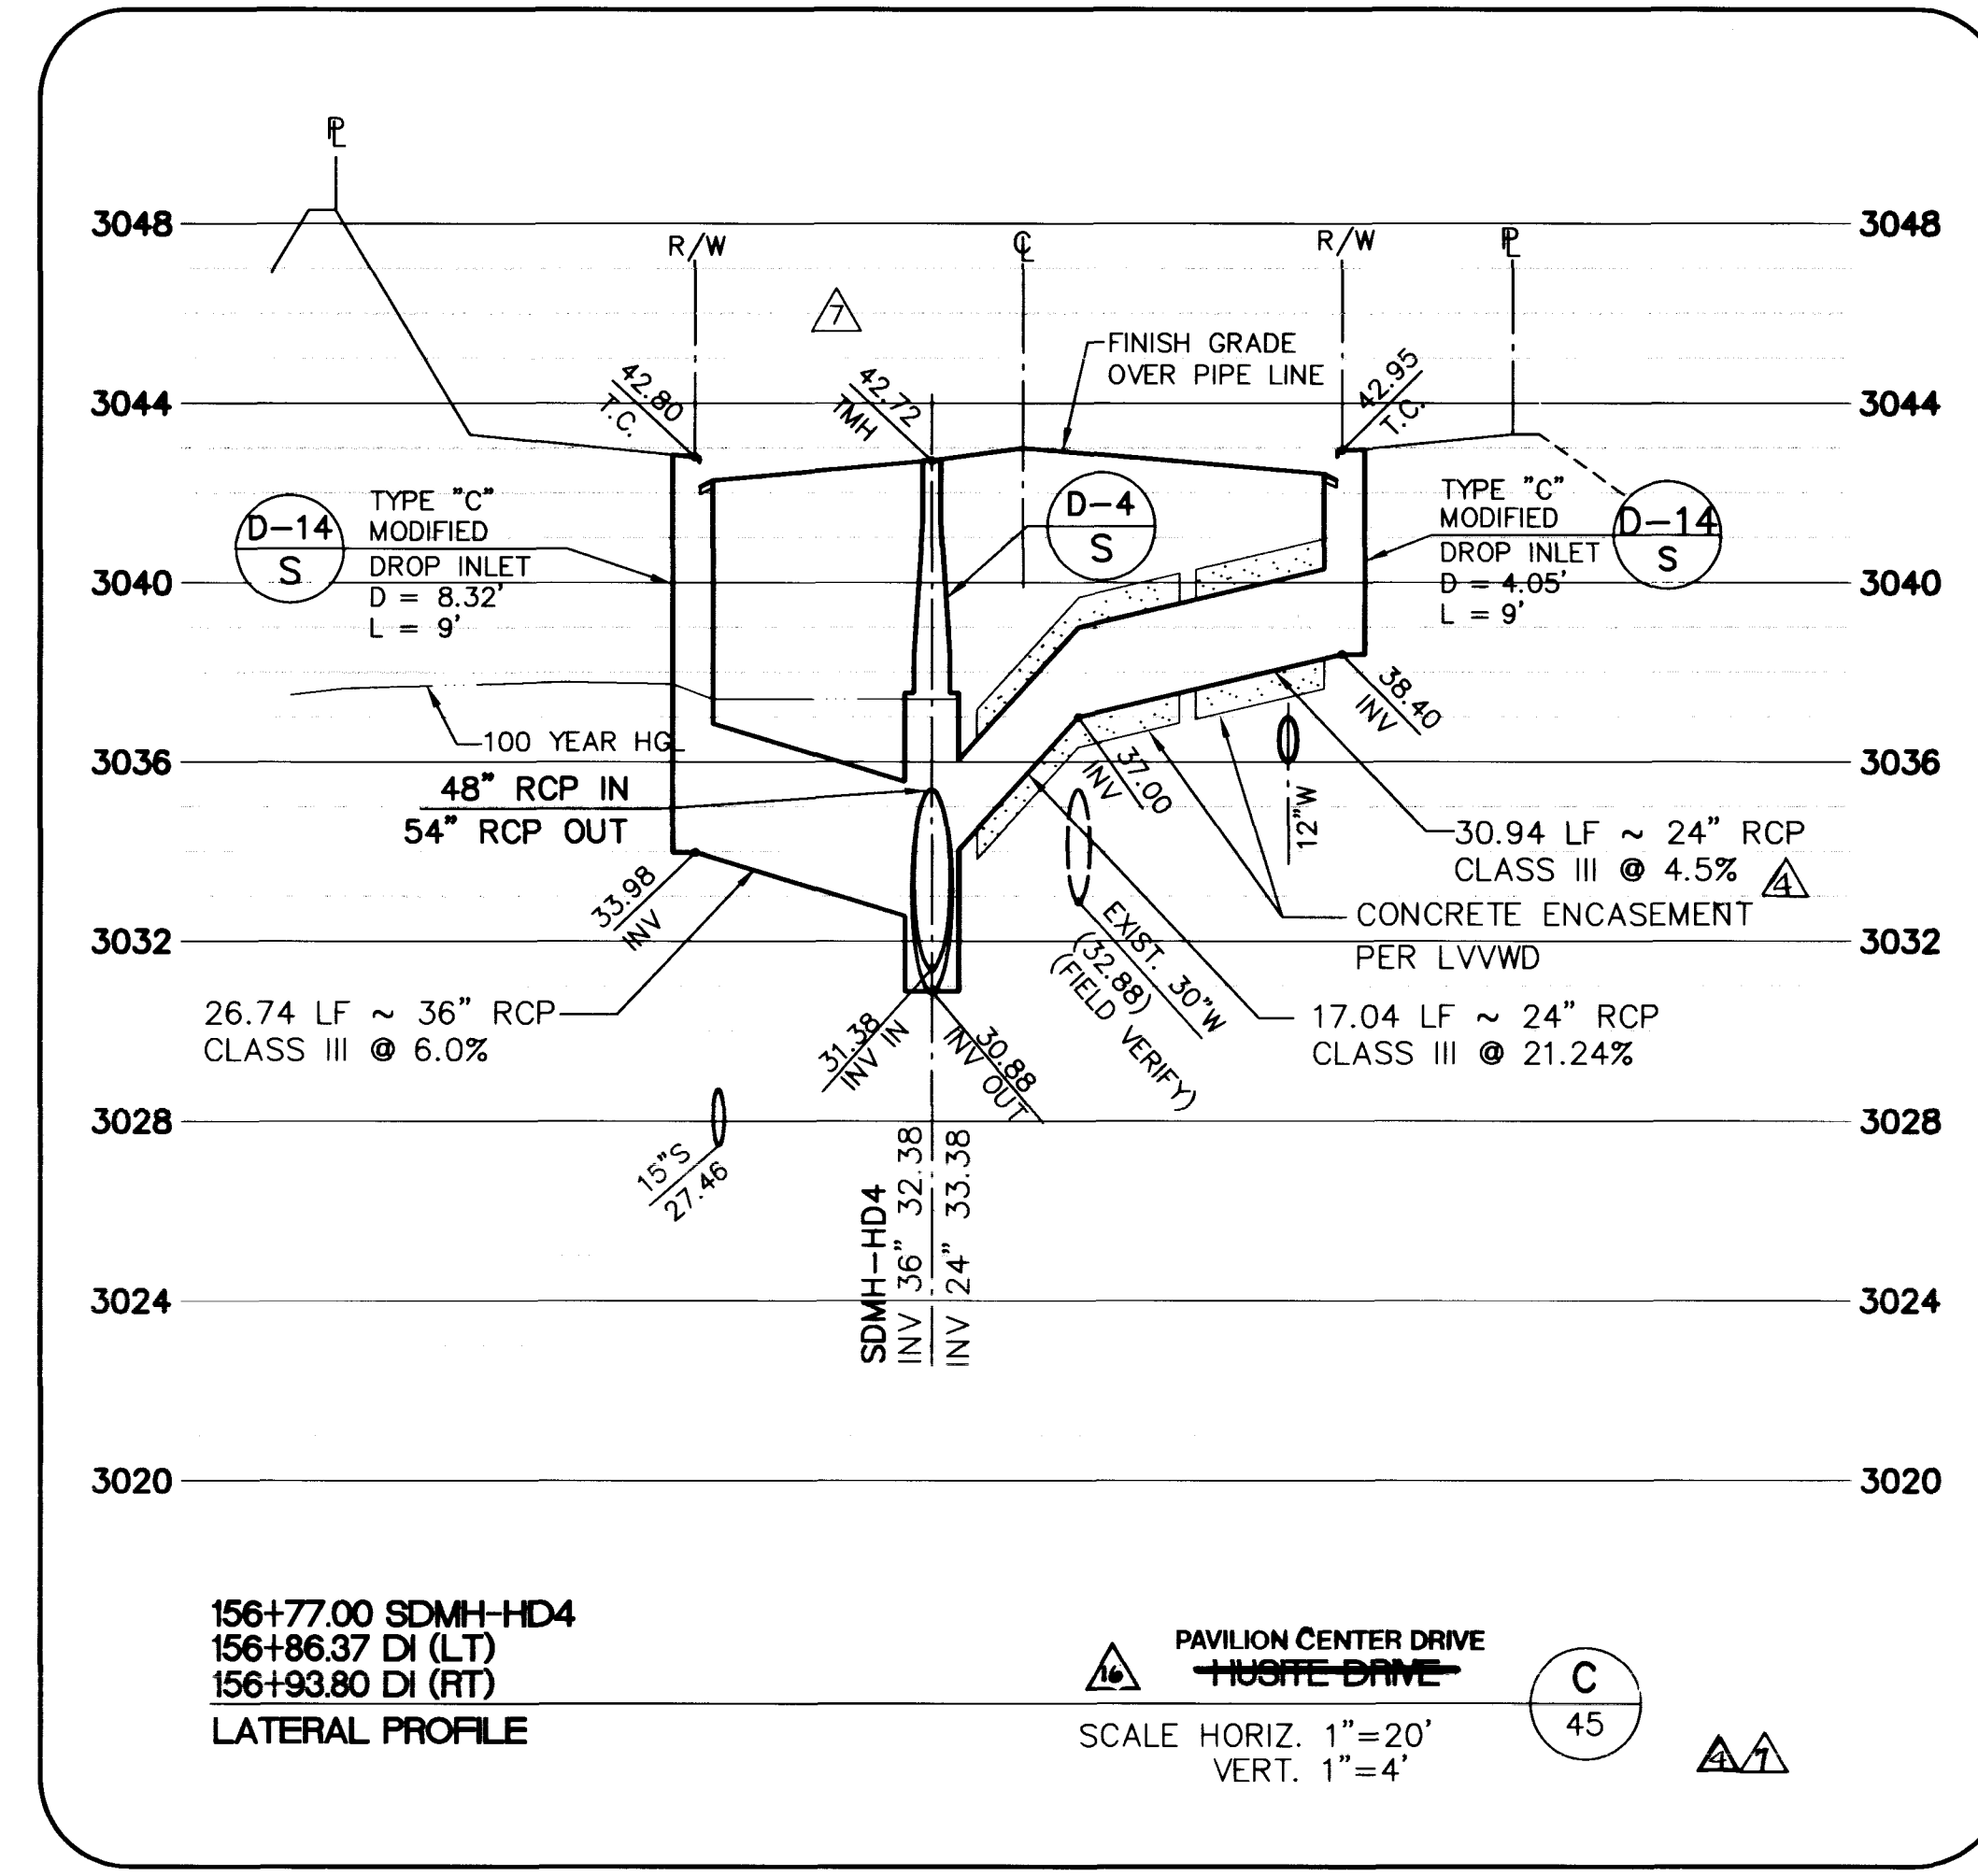
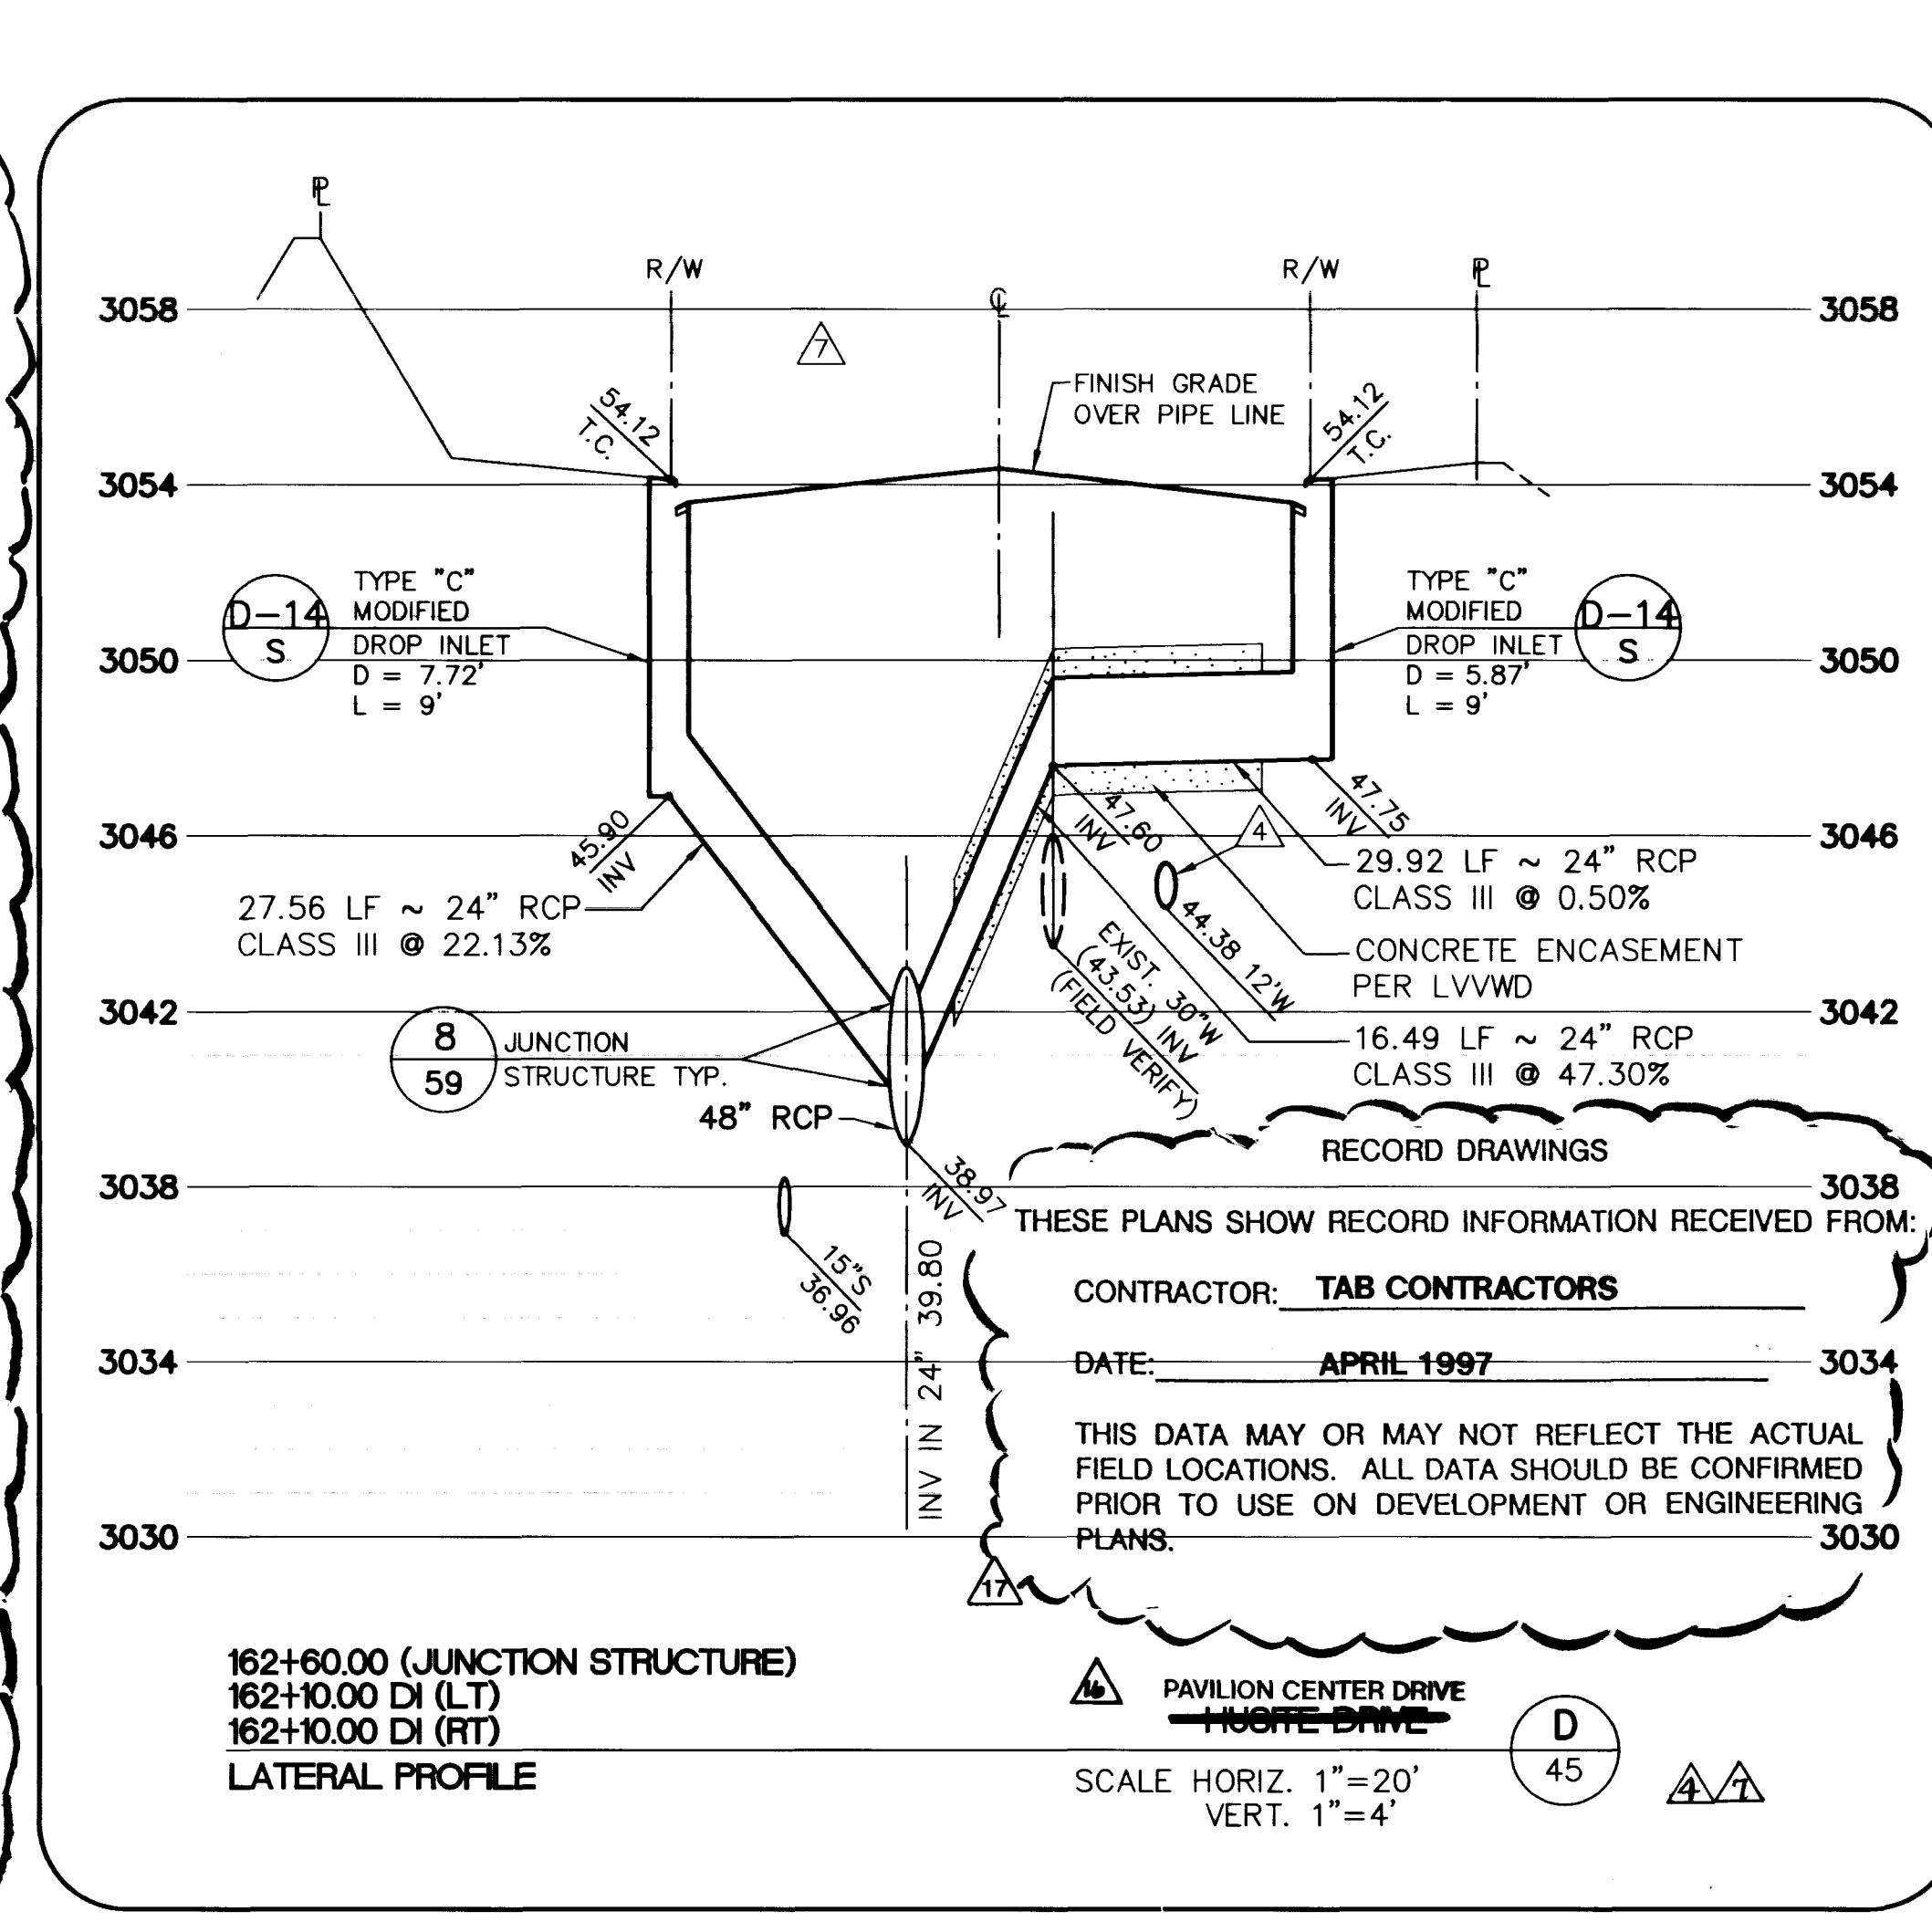
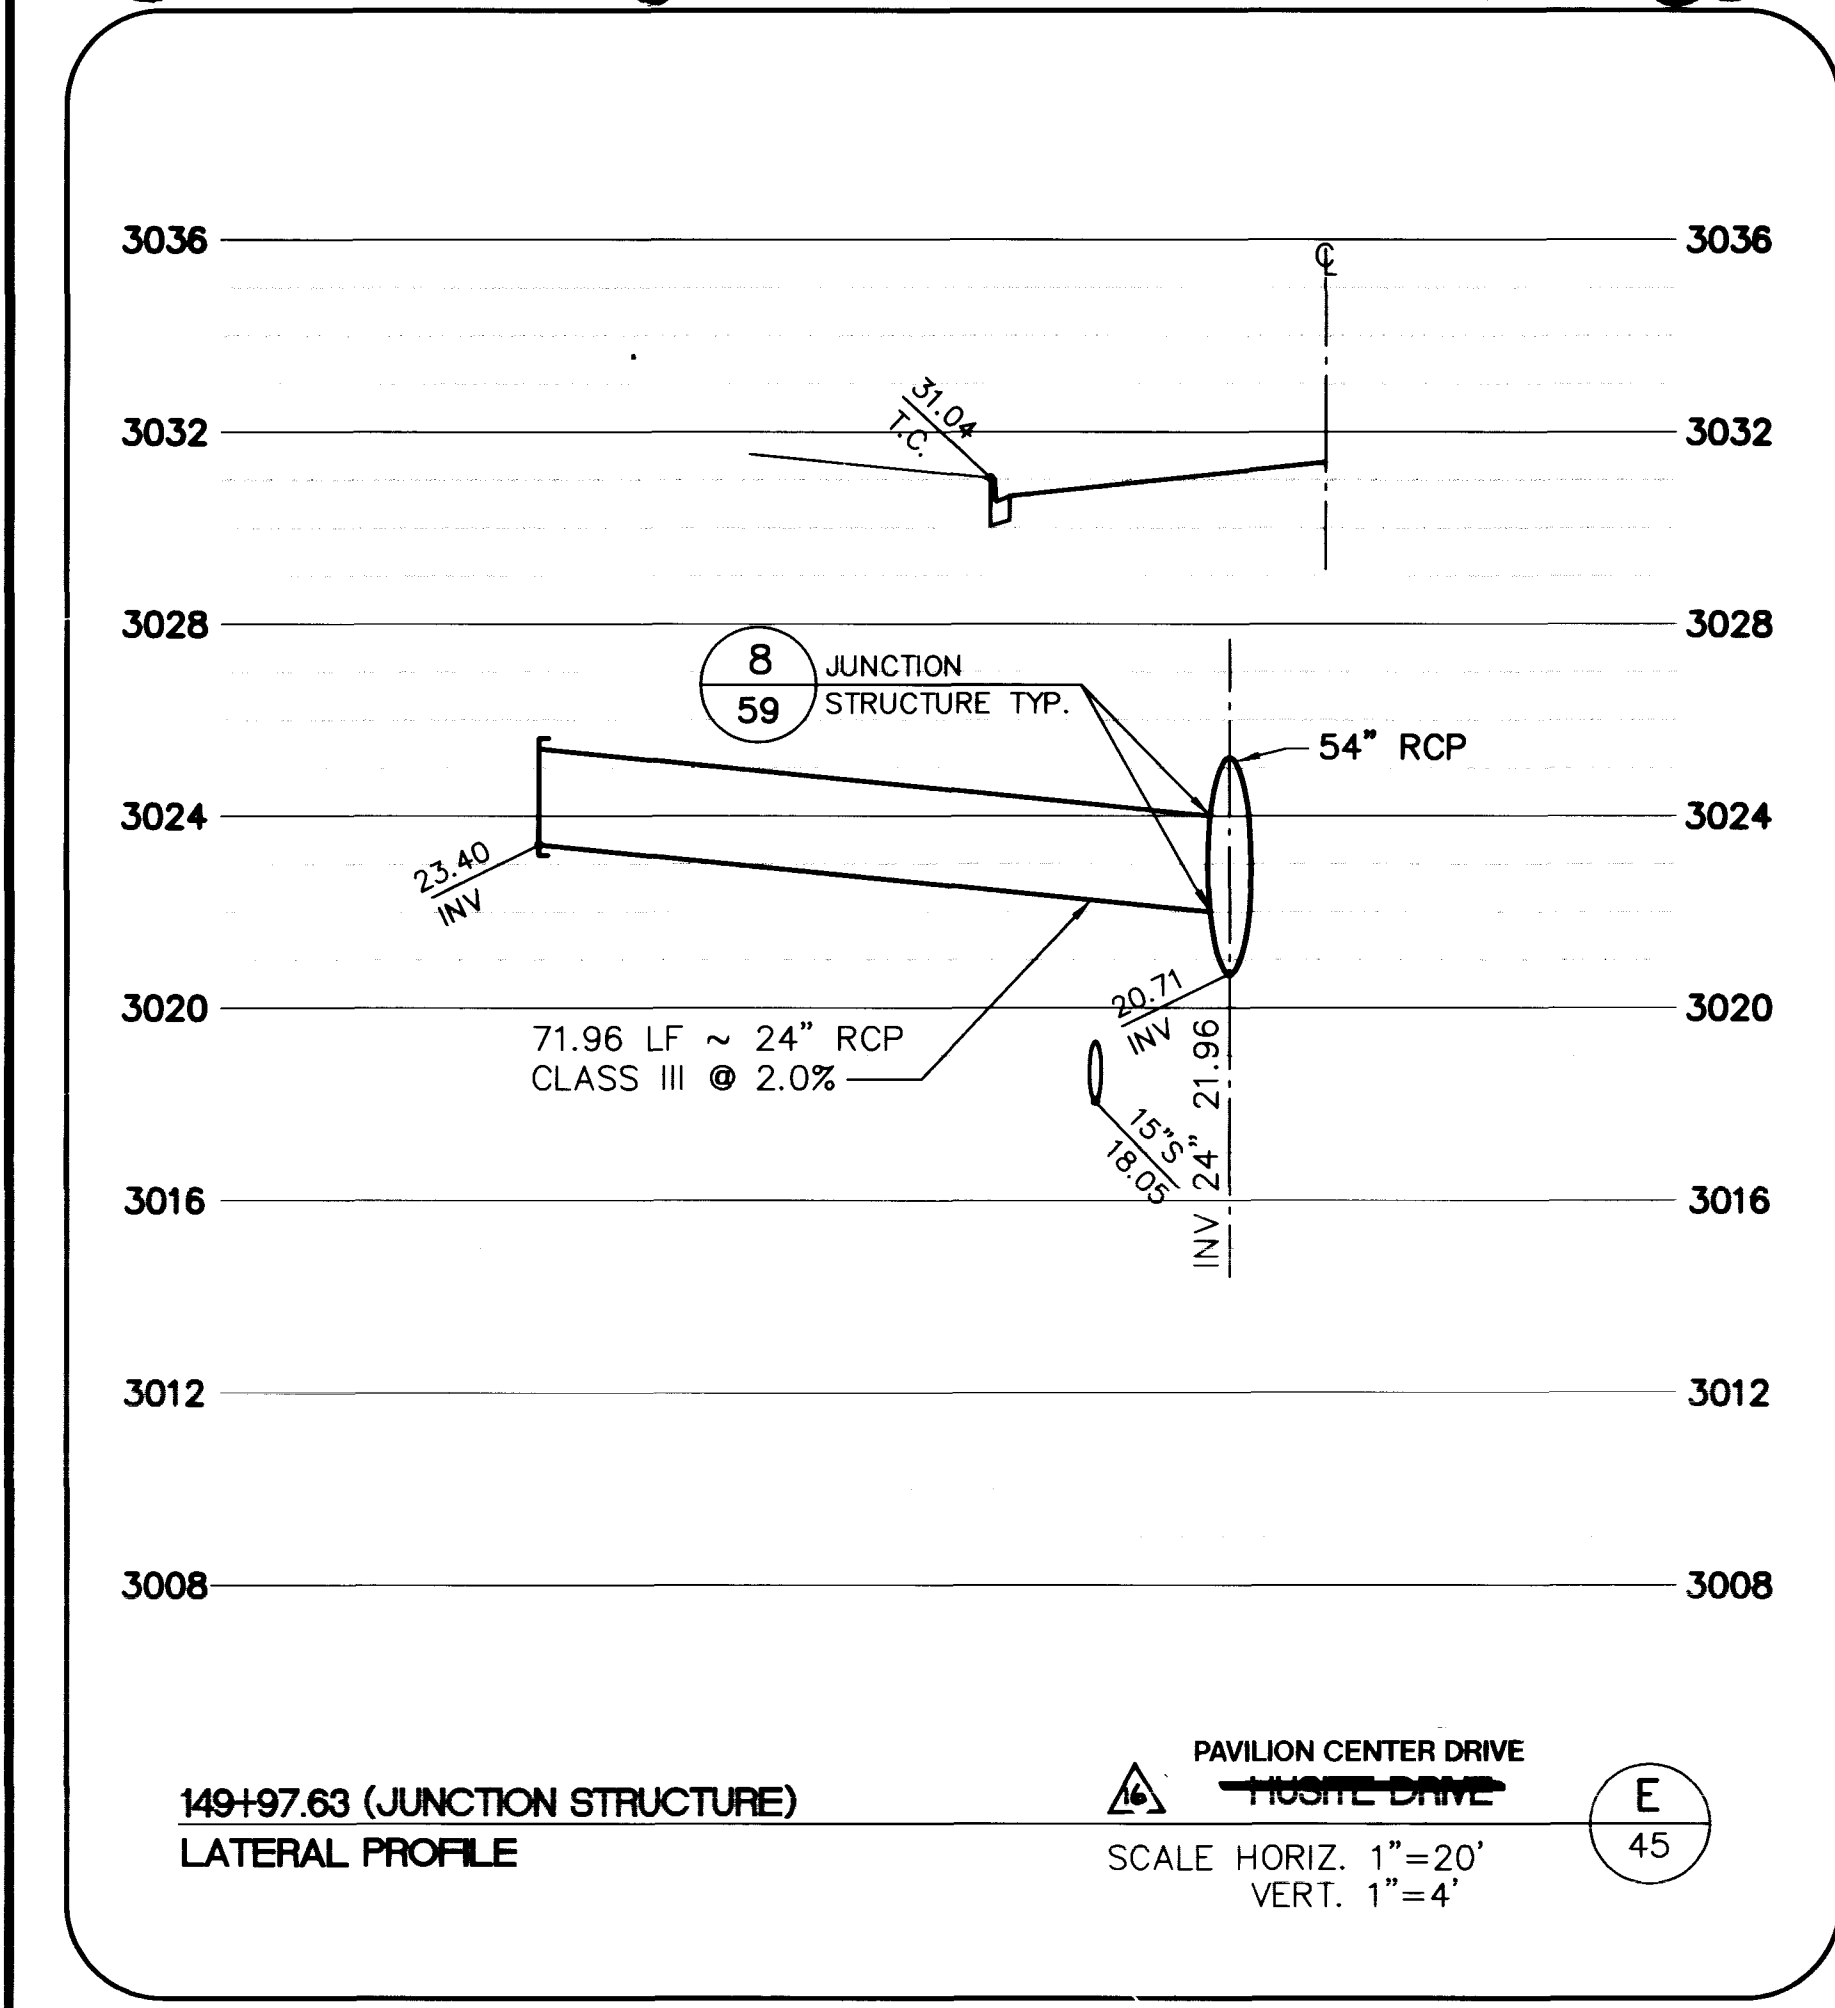


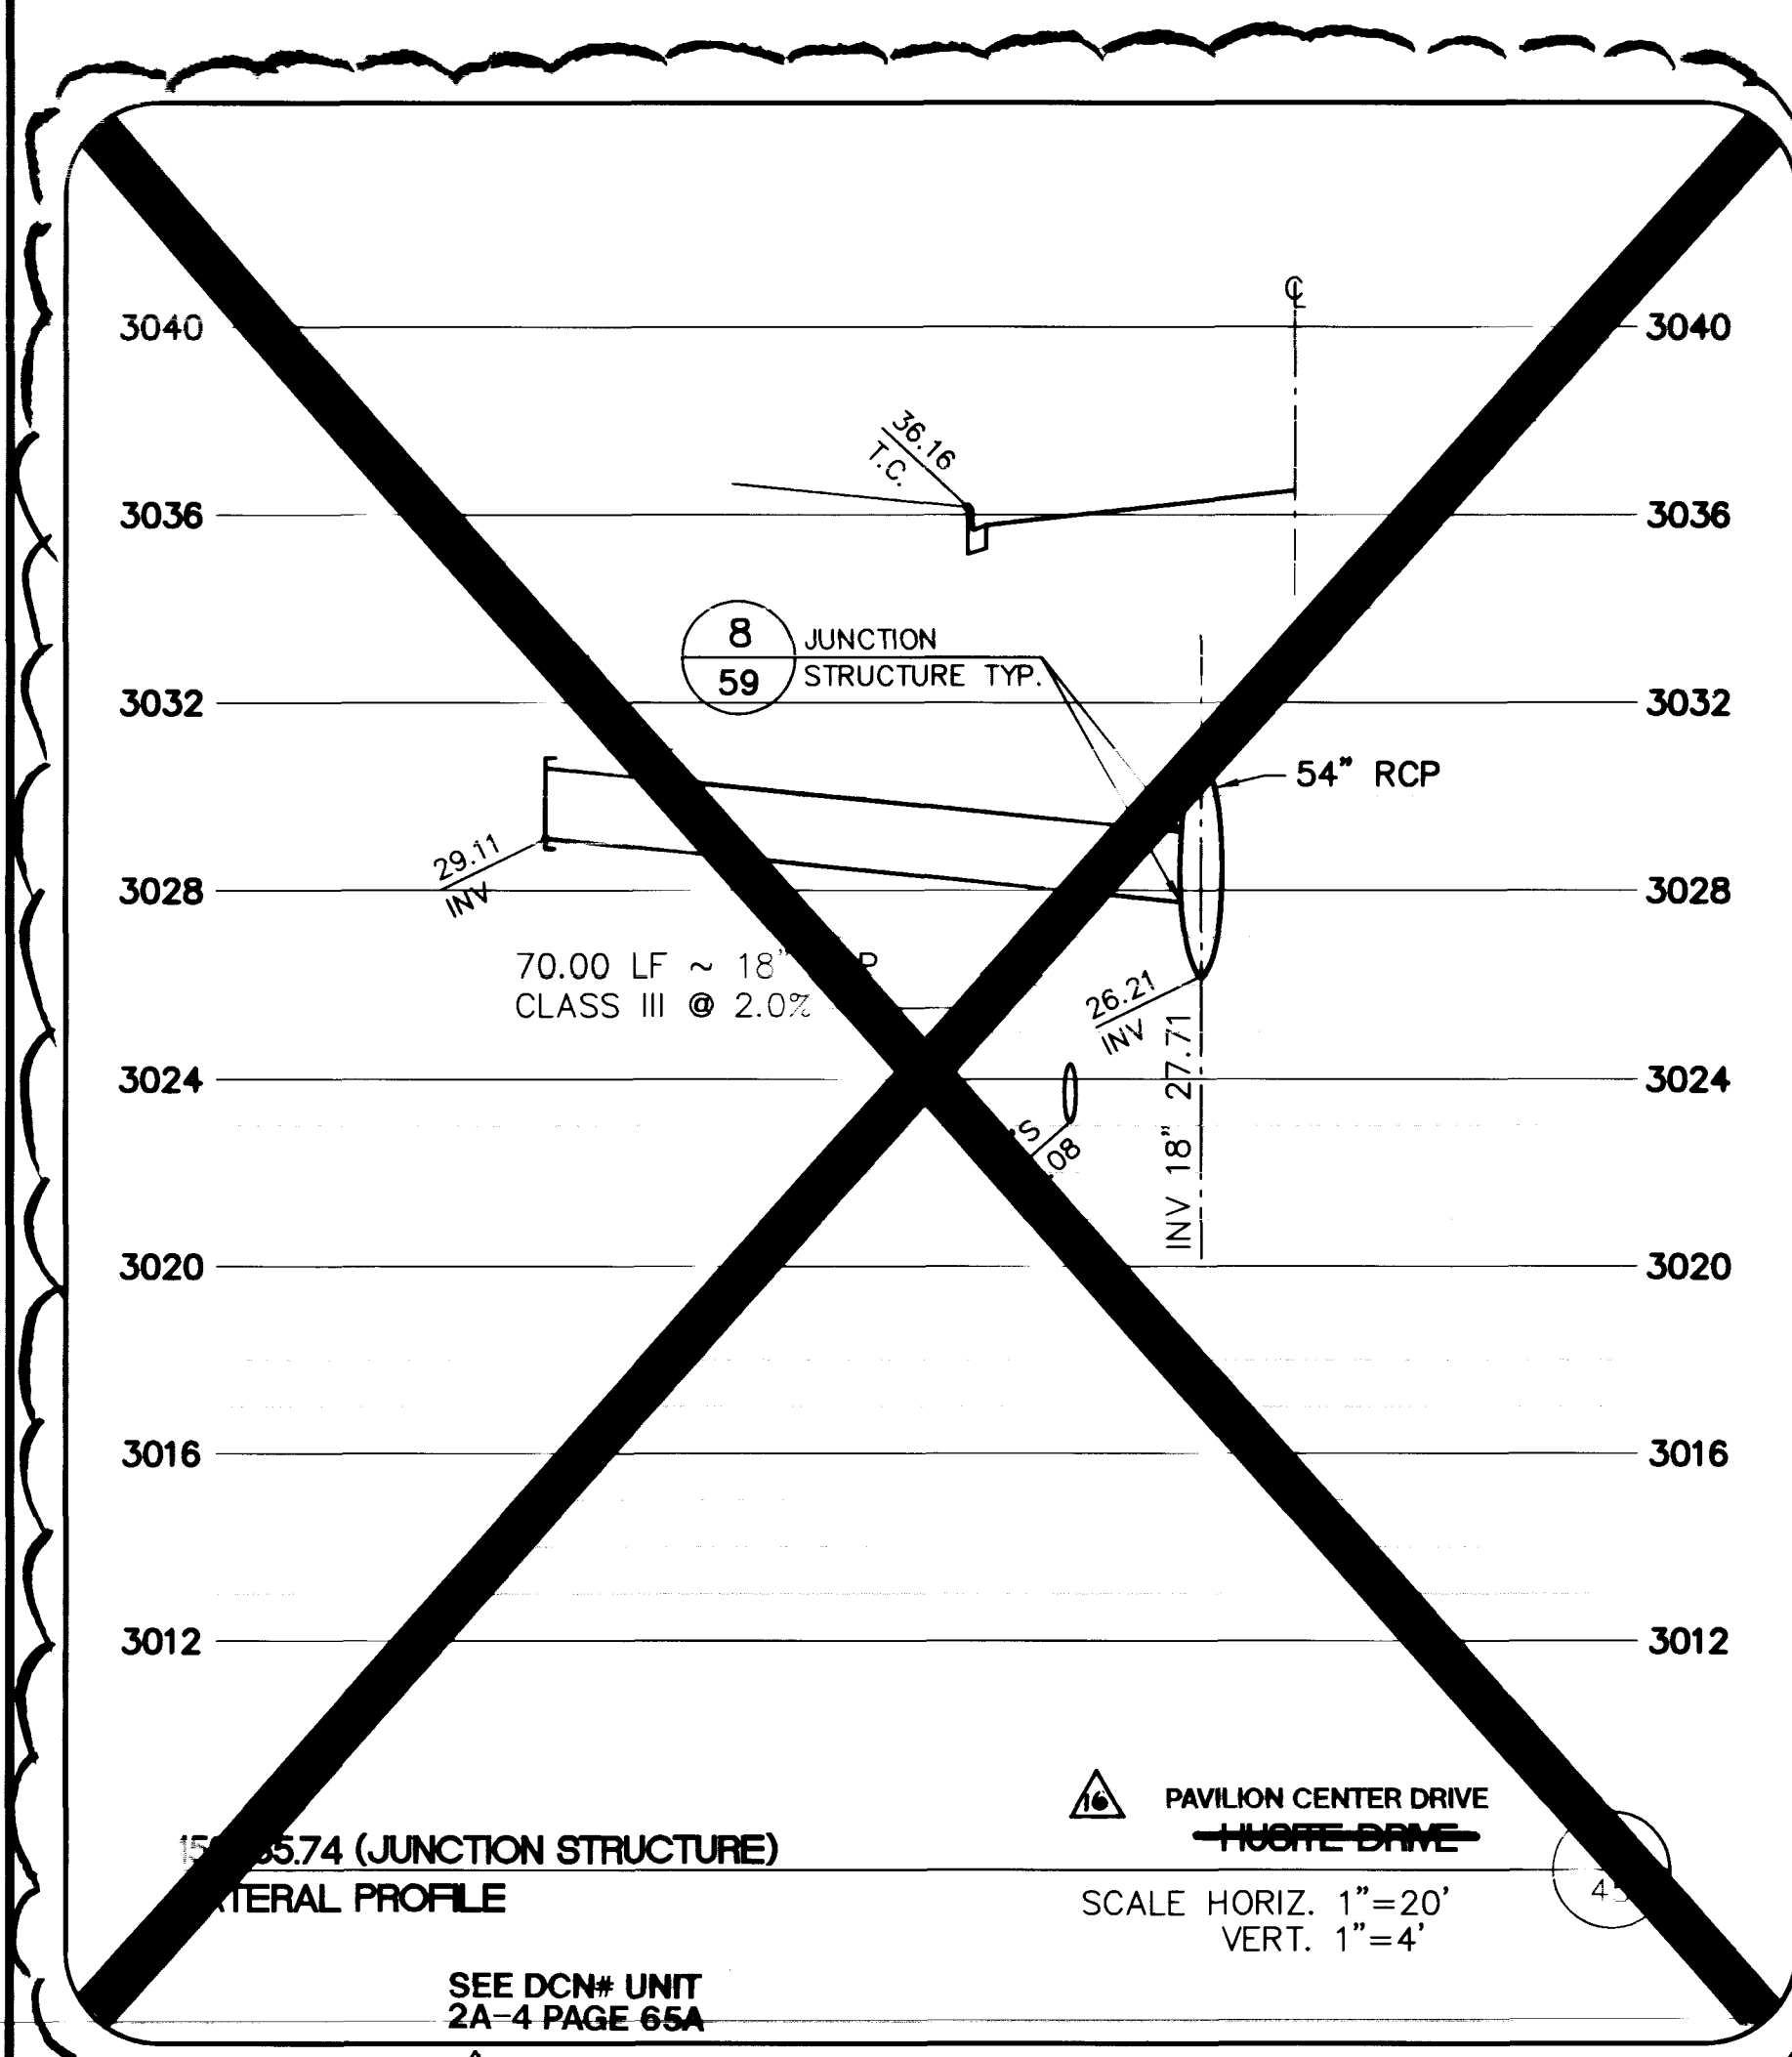

RECORD DRAWING INFORMATION		RECOMMENDED		APPROVED	
REV.	DATE	BY	DATE	BY	DATE
1	7/22/96	REV. ST. NAME	CHRISTOPHER W. ANDERSON	APPROVED	APPROVED
2	8/22/96	REVISED DESIGN GRADE AND ELEV.	CHRISTOPHER W. ANDERSON	APPROVED	APPROVED
3	8/7/96	REVISED WATER STUDY TO	CHRISTOPHER W. ANDERSON	APPROVED	APPROVED
4	7/13/96	REVISED D.I. LINE	CHRISTOPHER W. ANDERSON	APPROVED	APPROVED

STATE OF NEVADA
REGISTERED PROFESSIONAL ENGINEER
CHRISTOPHER W. ANDERSON
NO. 5071
R.P.E. NO. 5071

G.C. WALLACE, INC.
Engineering/Architecture
1535 SOUTH RAINBOW BLVD. LAS VEGAS, NEVADA 89102

SUMMERLIN
VILLAGE 11/12 THE ARBORS - UNIT 2A
PAVILION CENTER DRIVE
STORM DRAIN LATERALS

SHEET
45
SHT 45 OF 65

FINAL SUBMITTAL

