

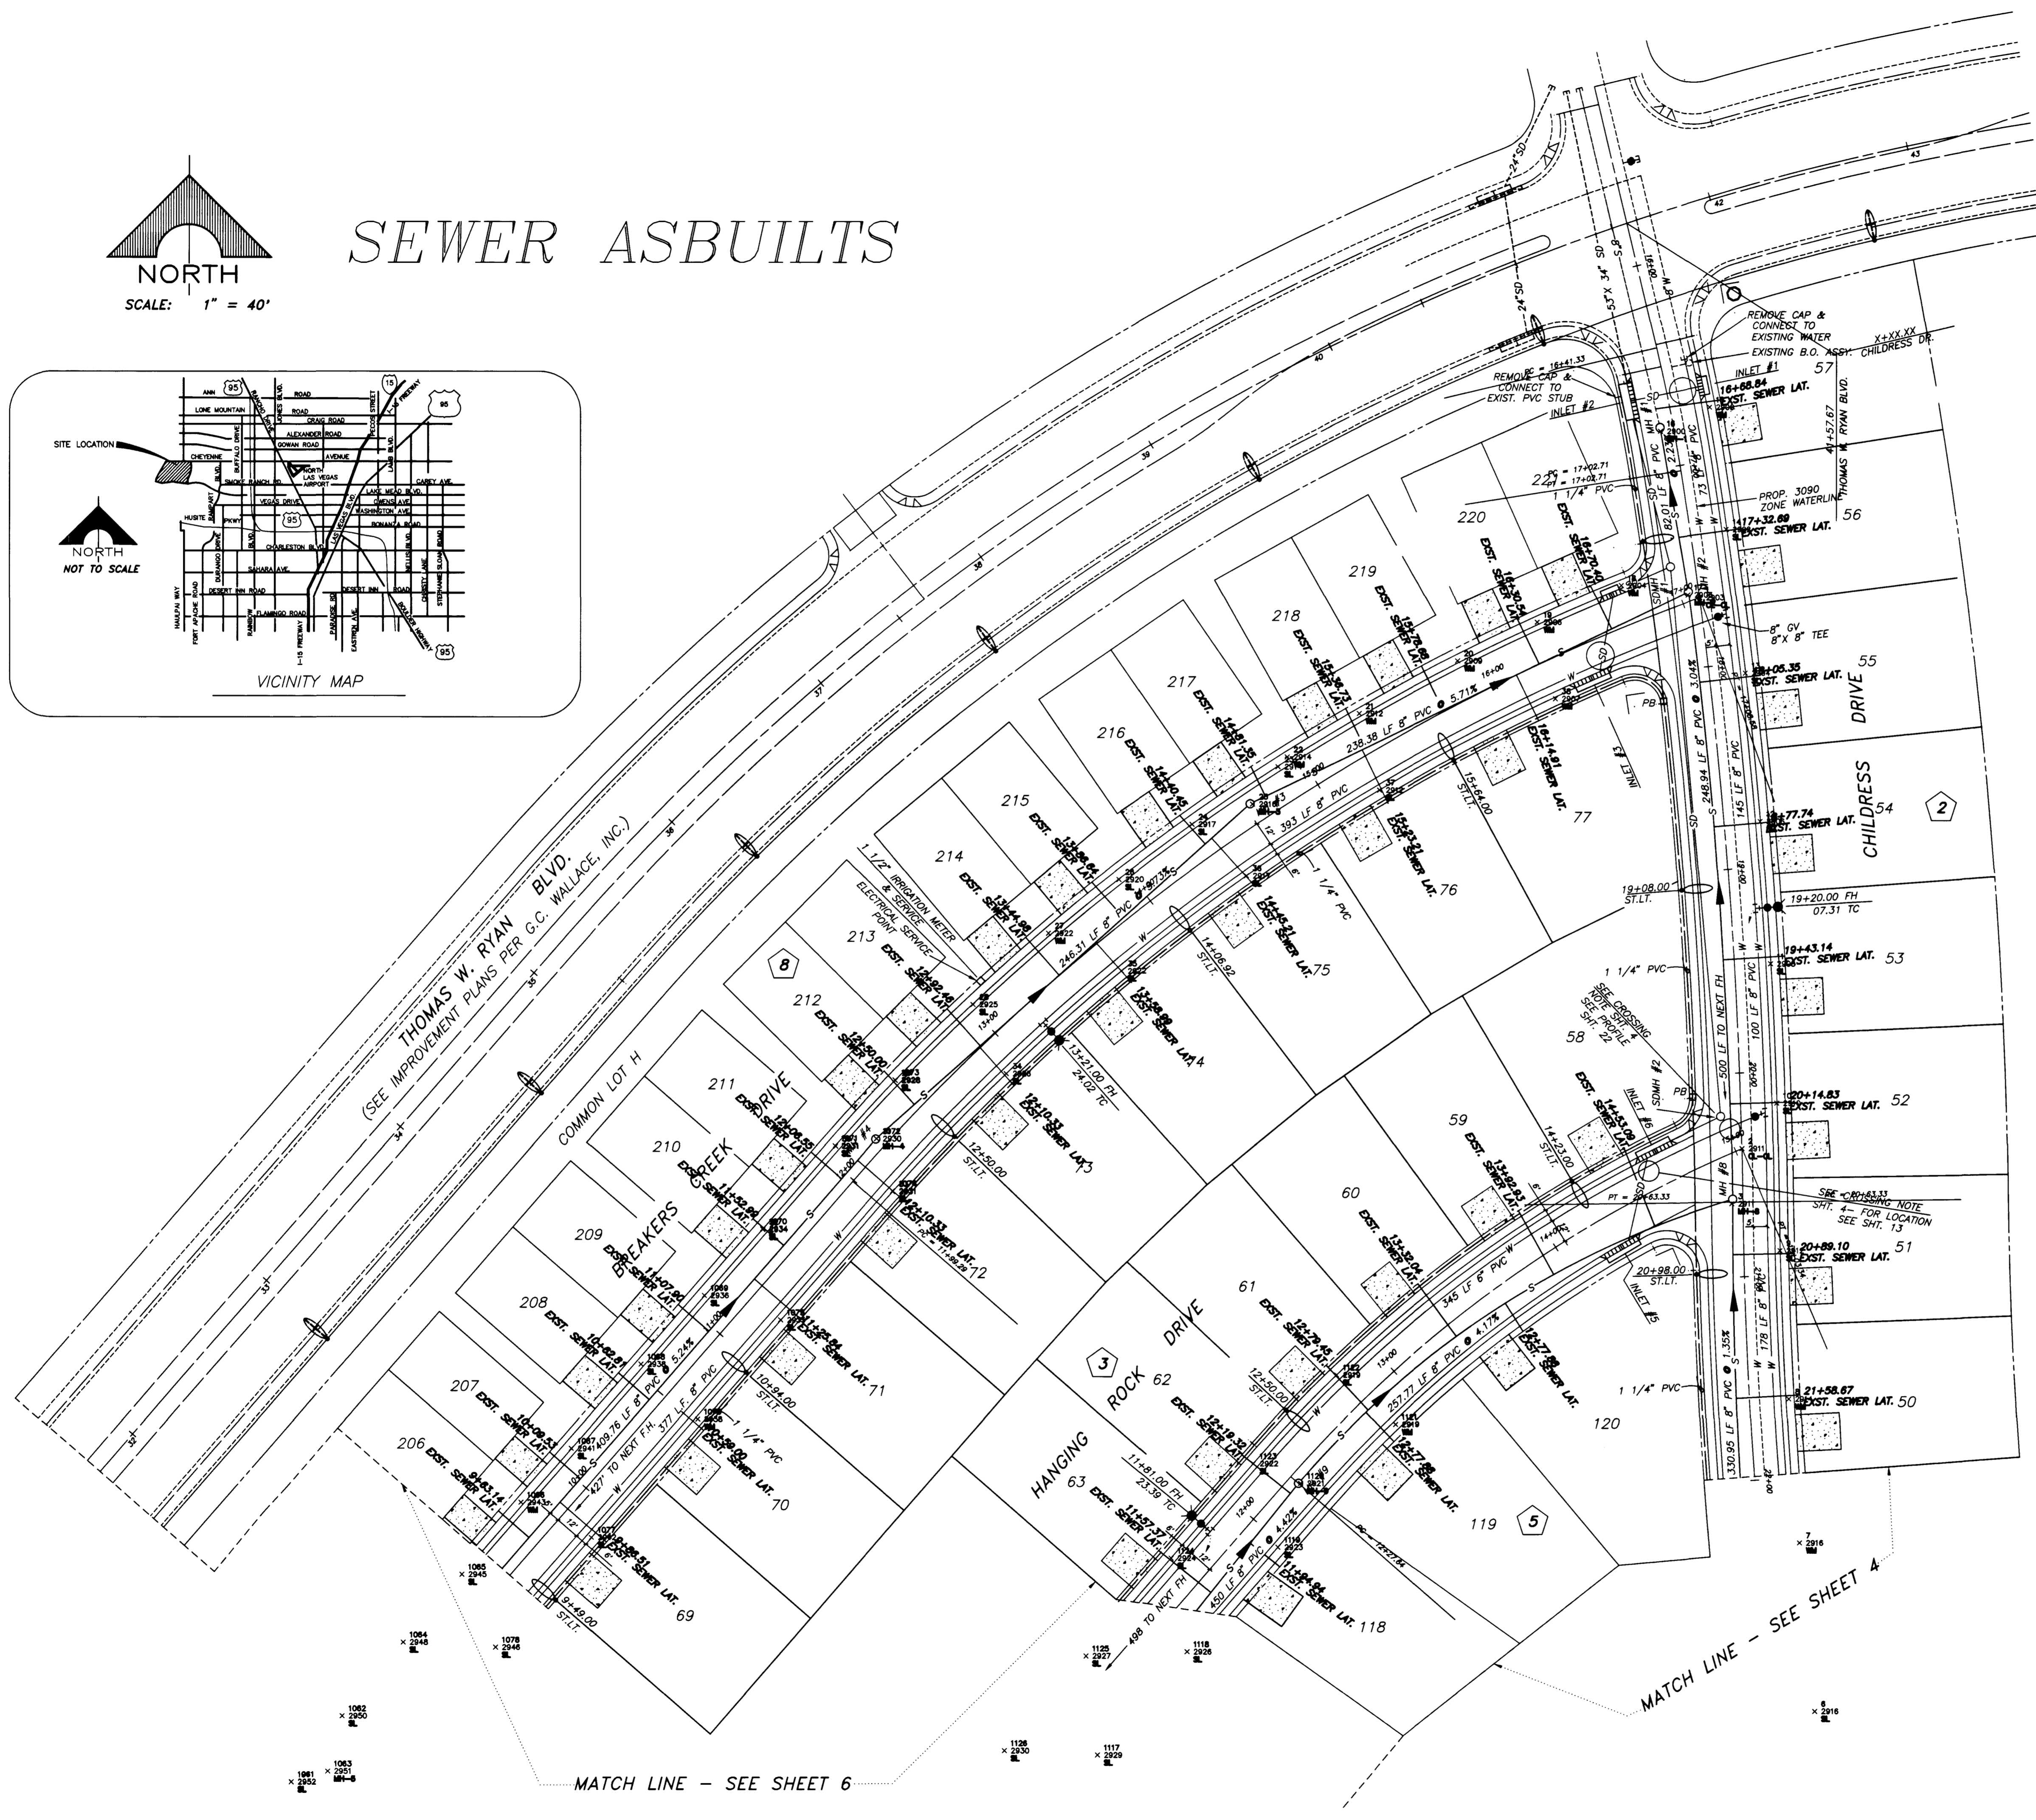
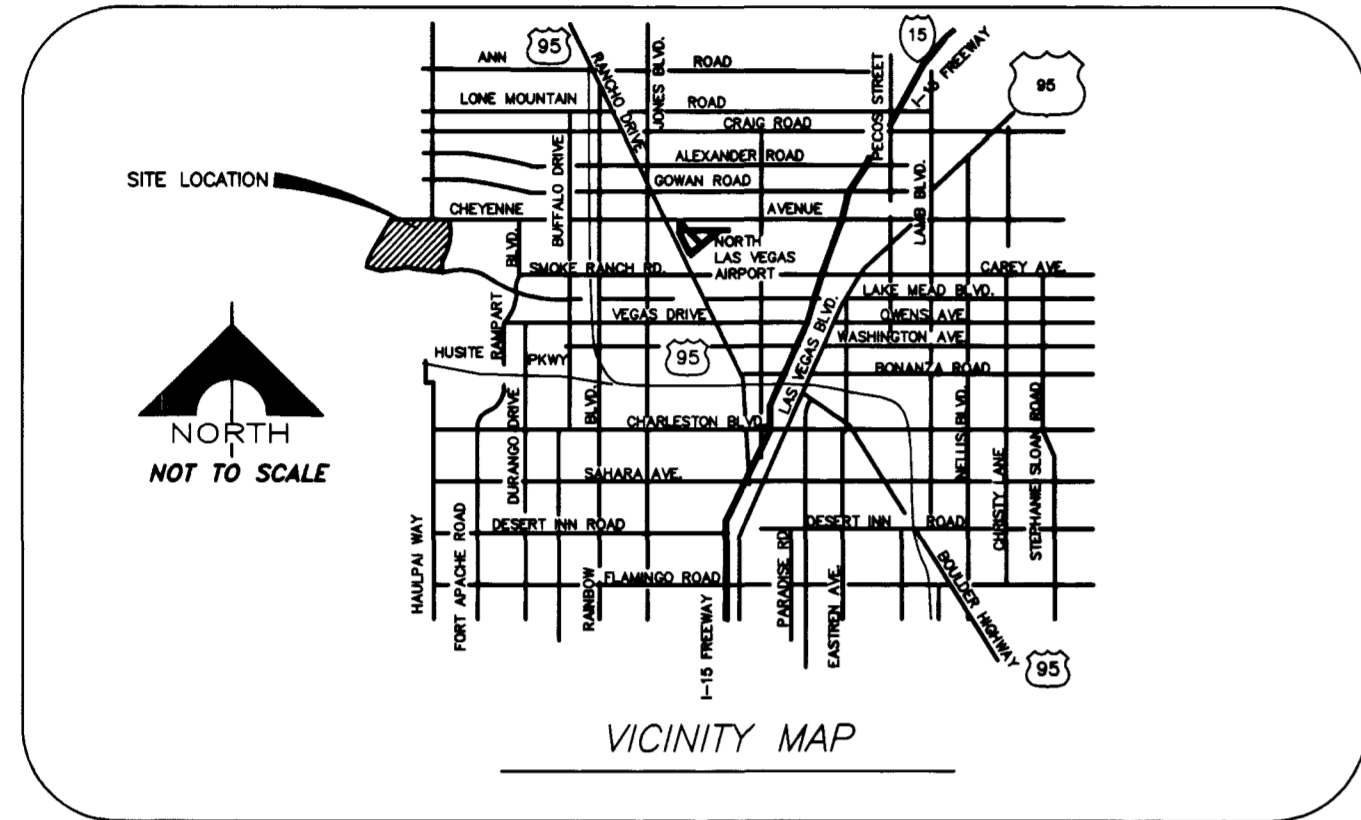


SEWER ASBUILTS

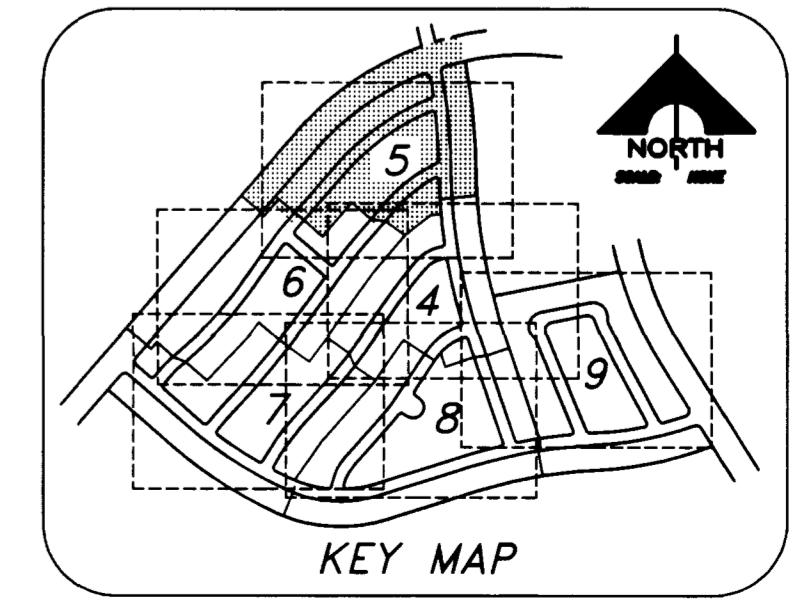

FUTURE
SUN CITY LAS VEGAS
RECREATION CENTER

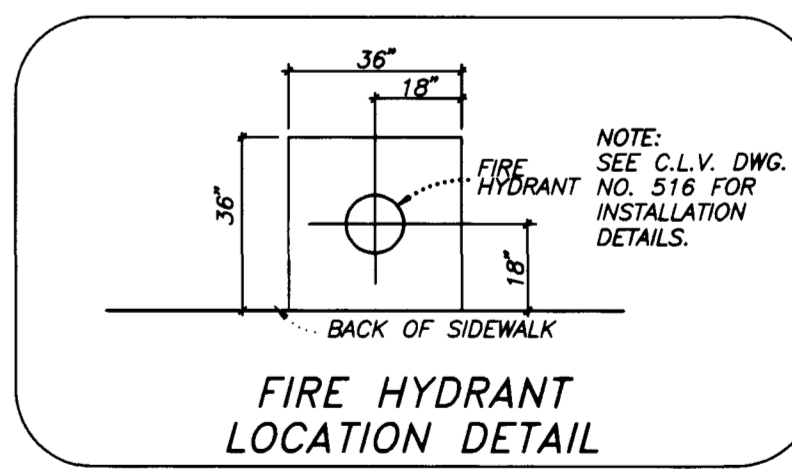

JOB NO. 701.170 PLOTTED 03/24/93 4:08 PM

REV	DATE	DESCRIPTION	C.L.V.	DATE

RECOMMENDED	MICHAEL D. ROSS	P.E. NO.	6218	DATE
G. C. WALLACE, INC. Engineering/Architecture 1555 SOUTH RAINBOW BLVD./LAS VEGAS, NEVADA 89102				
DEL WEBB COMMUNITIES, INC.				
SUN CITY LAS VEGAS UNIT NO. 40				
UTILITY PLAN II				
SHEET				
5				
OF 32 SHEETS				

