




SEWER AS-BUILTS

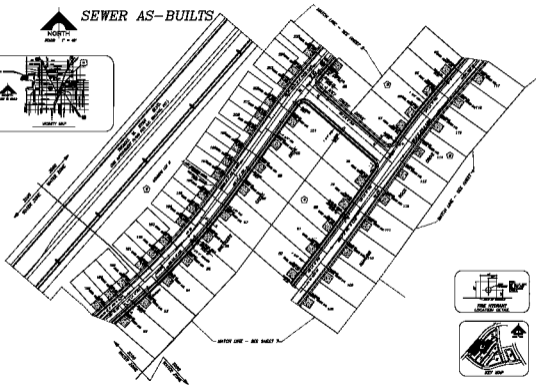

DATE	NOV 19 1984
DRAWN BY	J. WALLACE
CHECKED BY	J. WALLACE
SCALE	AS SHOWN
TITLE	SEWER AS-BUILTS
PROJECT NO.	84-001
SHEET NO.	6
TOTAL SHEETS	6
DESIGNED BY	J. WALLACE
ENGINEER	J. WALLACE
REGISTERED PROFESSIONAL ENGINEER	STATE OF CALIFORNIA
NO. 10000	