


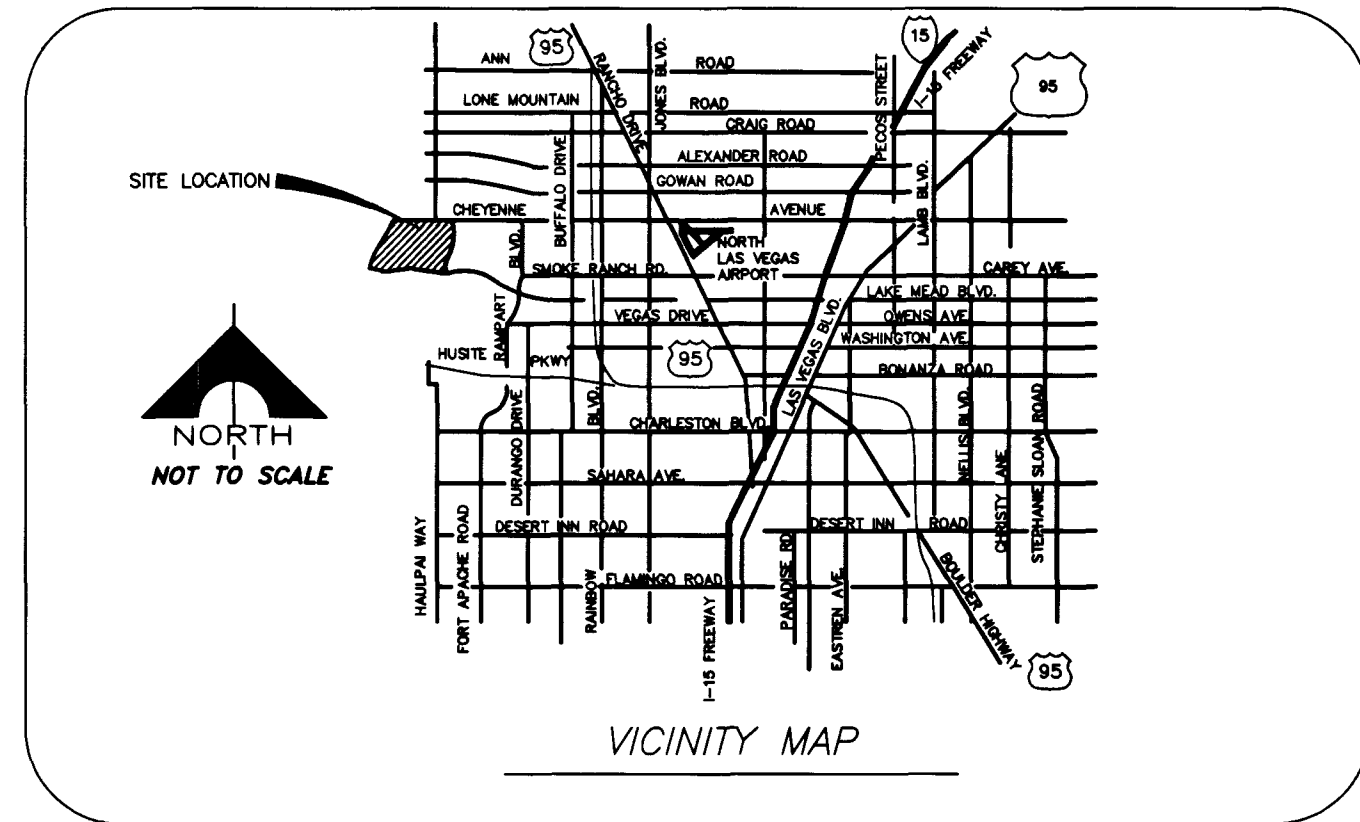


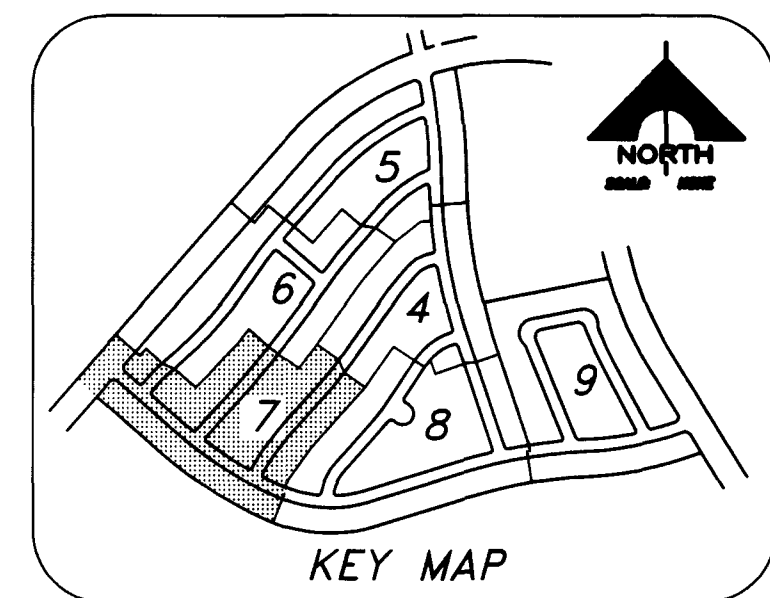

SEWER AS-BUILTS

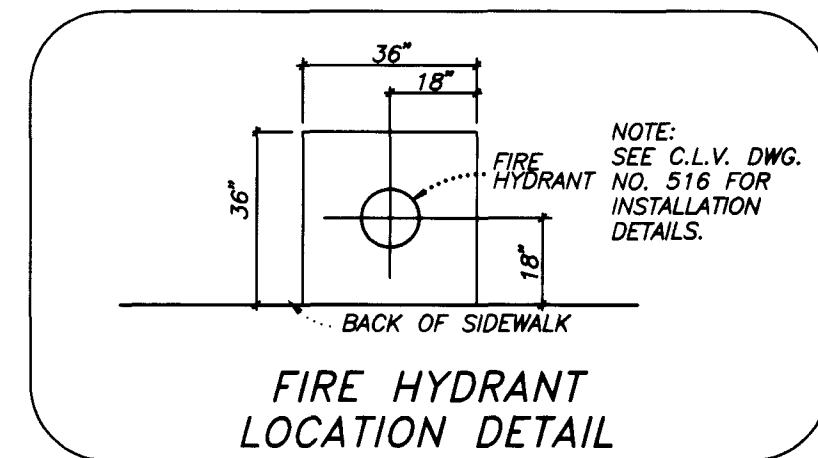

RECOMMENDED		REV		DESCRIPTION		CL		DATE	
MICHAEL D. ROSS		6218		P.E. NO.					
G.C. WALLACE, INC.		6218		P.E. NO.					
Engineering/Architecture		1555 SOUTH RAINBOW BLVD./LAS VEGAS, NEVADA 89102							
DEL WEBB COMMUNITIES, INC.		SUN CITY LAS VEGAS UNIT NO. 40		UTILITY PLAN IV					
SHEET		7		OF 32 SHEETS					

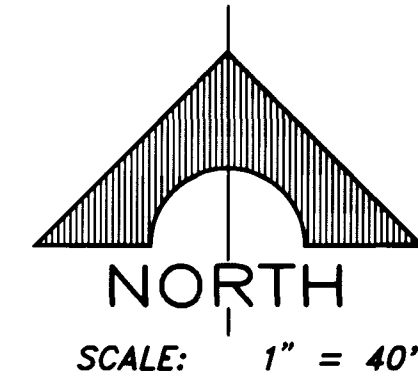