


JOB NO. 701.180 PLOTTED: 06/29/93 09:47 am DRAWING: C:\DRAWINGS\DWG\1\1\1\1-9 BP: JSE

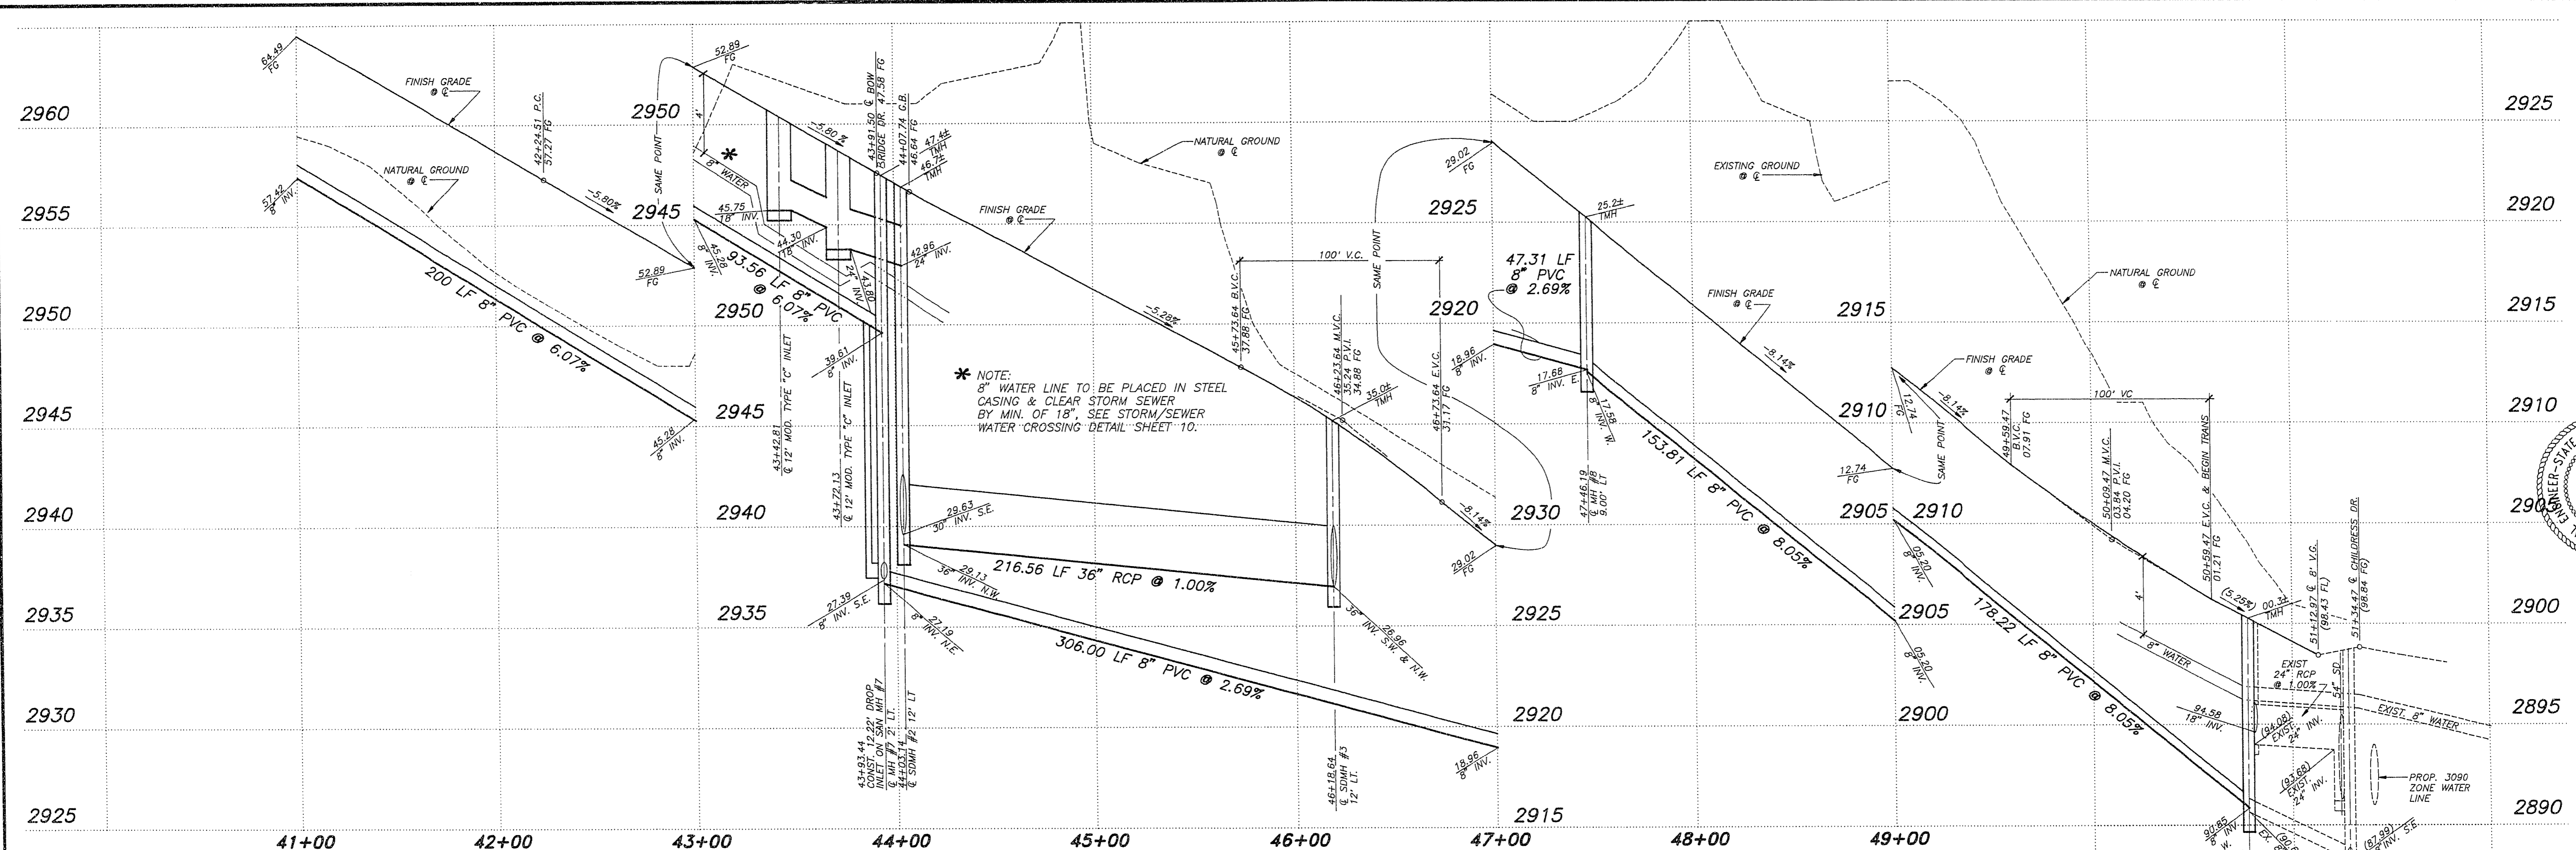

PROFILE

SCALE: HORIZ. 1" = 40'
VERT. 1" = 4'

① CURVE TABLE

CURVE	DELTA	RADIUS	LENGTH	TANGENT
1	01°01'59"	2288.00'	41.25'	20.63'
2	01°44'02"	2288.00'	69.24'	34.02'
3	01°23'59"	2252.00'	55.02'	27.51'
4	03°15'49"	2252.00'	128.28'	64.16'
5	04°12'53"	2270.00'	166.98'	83.53'
6	01°51'28"	2288.00'	74.19'	37.10'
7	01°51'50"	2252.00'	73.26'	36.63'
8	01°40'04"	2252.00'	65.55'	32.78'
9	01°48'06"	2252.00'	70.81'	35.41'

② CURVE TABLE

CURVE	DELTA	RADIUS	LENGTH	TANGENT
10	20°56'14"	2288.00'	836.09'	422.76'
11	01°54'45"	2252.00'	75.17'	37.59'
12	20°56'14"	2270.00'	829.51'	418.43'
13	01°54'40"	2252.00'	75.12'	37.56'
14	10°43'21"	2270.00'	662.53'	333.54'
15	15°43'19"	2252.00'	617.85'	310.93'
16	01°32'09"	2288.00'	61.33'	30.67'
17	00°56'29"	2288.00'	34.28'	12.14'
18	00°47'04"	2252.00'	30.53'	15.42'

SD LINE TABLE


LINE	BEARING	DISTANCE
1	S 01°17'10" E	43.37'
2	S 58°55'04" W	25.93'
3	N 48°13'42" W	216.56'
4	S 3°55'33" E	128.00'
5	S 42°15'57" W	130.00'
6	S 28°03'46" E	31.00'

SD MH COORDINATES

MH#	NORTH	EAST
2	N 532652.391	E 575812.857
3	N 532796.635	E 575974.368
4	N 532892.344	E 575887.035

SD INLET COORDINATES

INLET#	NORTH	EAST
1	N 532587.443	E 575792.828
4	N 532635.672	E 575785.441
5	N 533024.986	E 576380.674
6	N 533059.400	E 576362.326

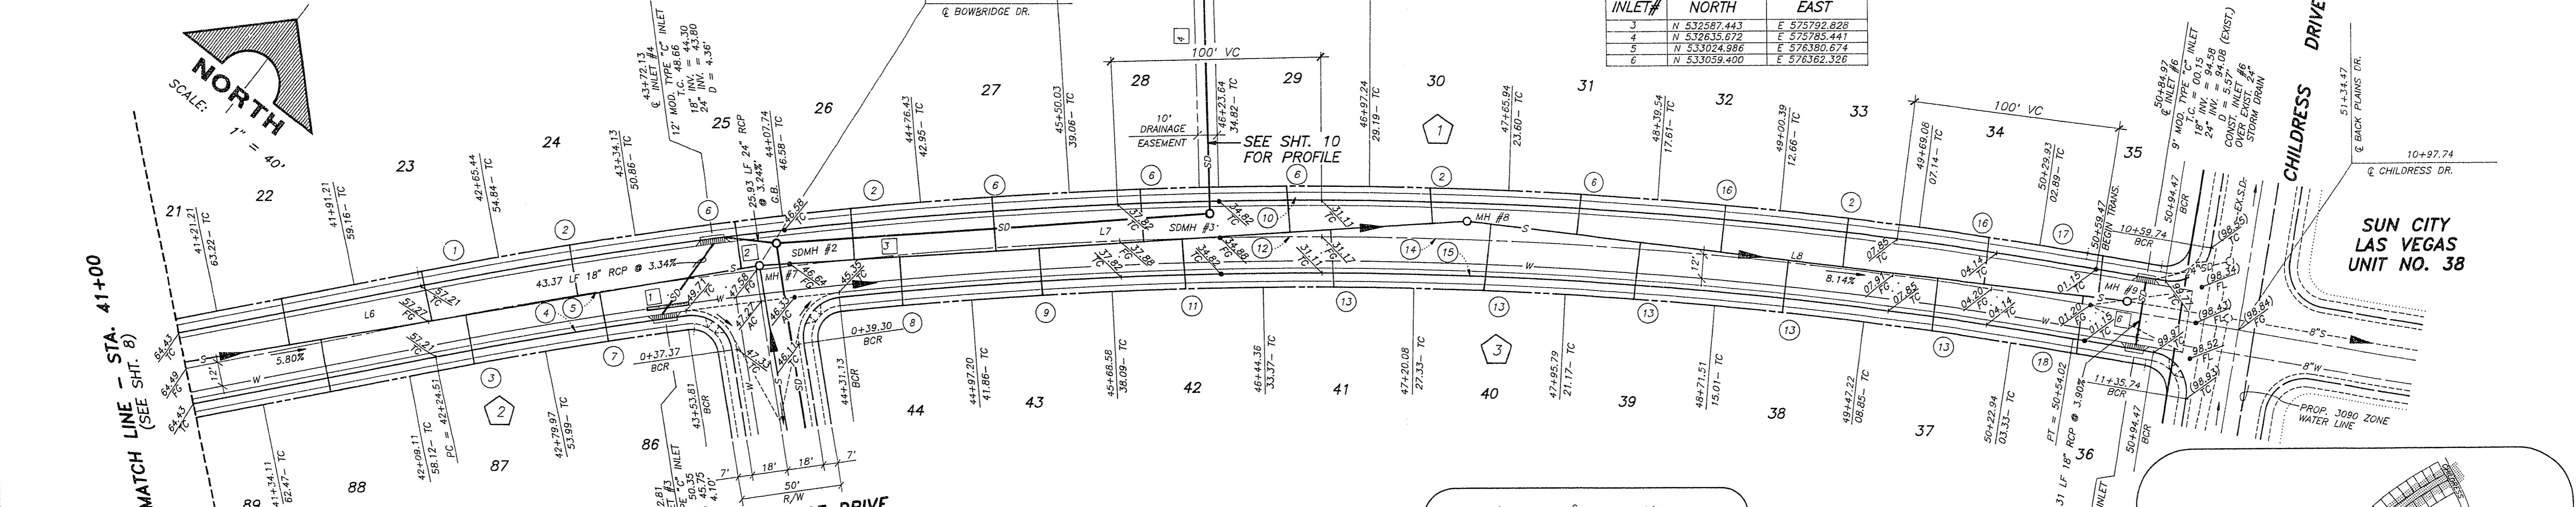


MH COORDINATES



MH#	NORTH	EAST
7	N 532638.443	E 575812.858
8	N 532872.168	E 576077.917
9	N 533042.994	E 576362.632

SEWER LINE TABLE

LINE	BEARING	DISTANCE
L6	N 42°27'19" E	365.76'
L7	N 48°35'02" E	353.31'
L8	N 59°02'12" E	332.03'

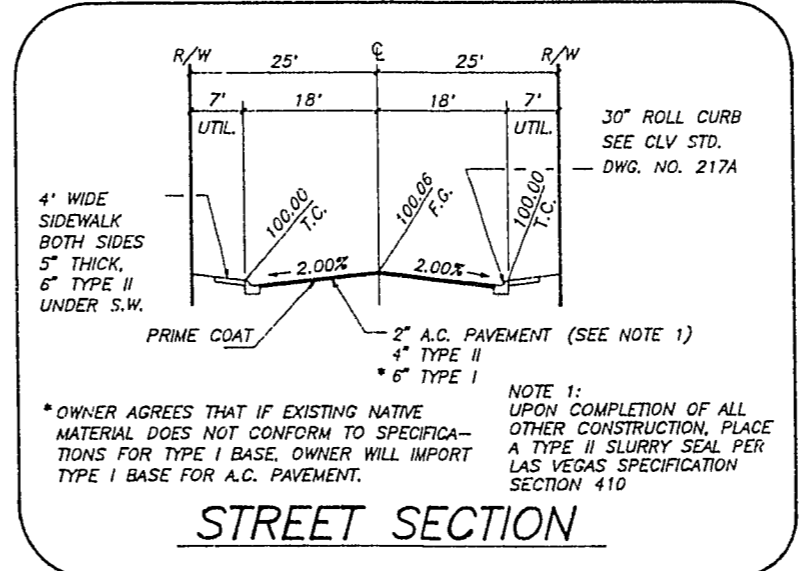

APPROVED FOR CONSTRUCTION
LAS VEGAS VALLEY WATER DISTRICT
DATE: 7/13/93

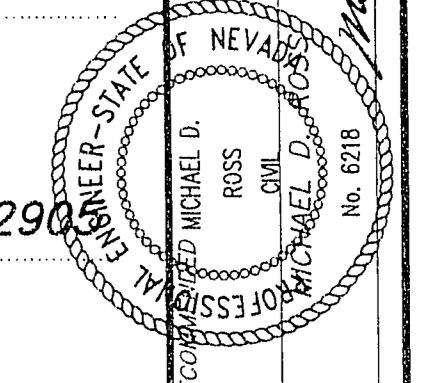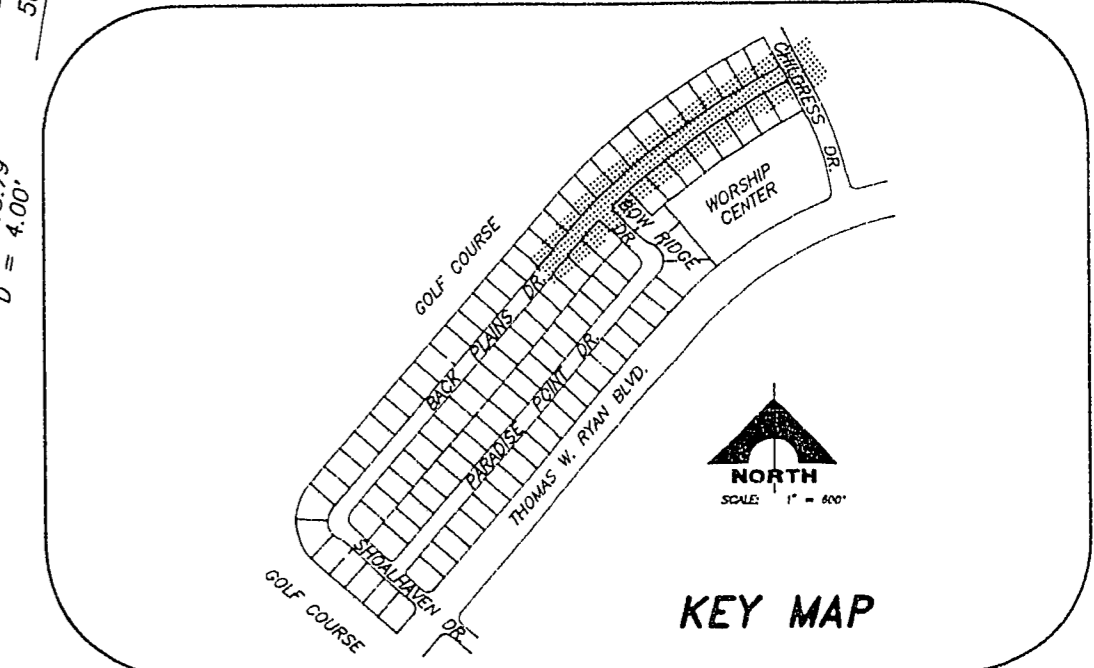

RECORD COPY
MICHAEL D. ROSS
P.E. NO. 6218
DATE: 10/10/93
G.C. WALLACE, INC.
Engineering/Architecture
1855 SOUTH RAINBOW BLVD., LAS VEGAS, NEVADA 89102

DEL WEBB COMMUNITIES, INC.
SUN CITY LAS VEGAS UNIT NO. 41 PHASE I
BACK PLAINS DRIVE
SHEET 9
OF 17 SHEETS

10-10-143 1074-4141-41