


SEWER AS-BUILTS

WITH ALL SEWER LINES AS OF DATE WHEN DRAWING MADE

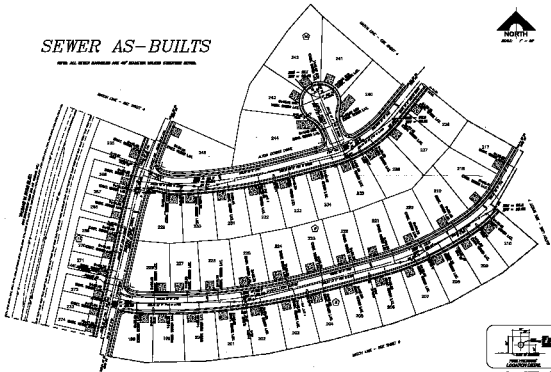

DATE: 11/15/11	PROJECT: 1111111111
DRAWN BY: J. WALKER, INC.	CHECKED BY: J. WALKER, INC.
SCALE: AS SHOWN	PROJECT: 1111111111
SHEET 5	