

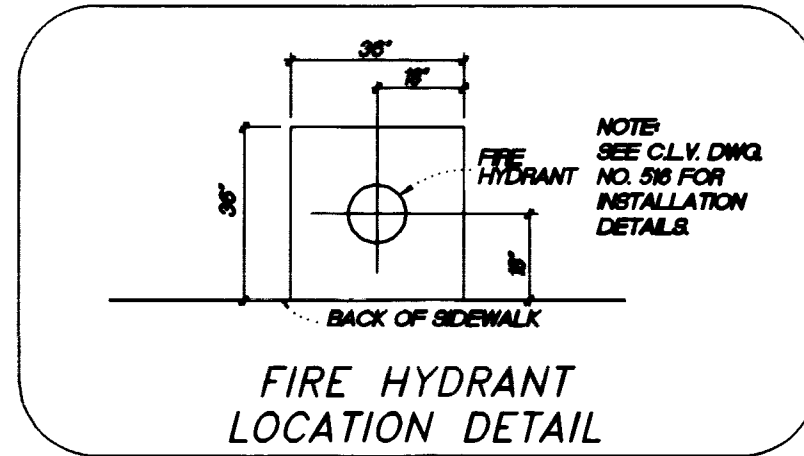


JOB NO. 10096 JOB# 3074-4141-42

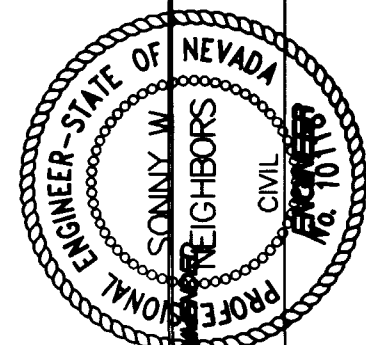

FIRE HYDRANT
LOCATION DETAIL

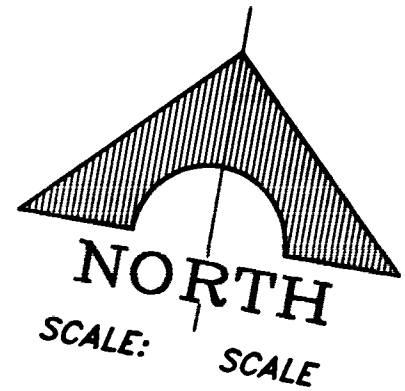



G.C. WALLACE, INC.
Engineering/Architecture
1555 SOUTH RAINBOW BLVD./LAS VEGAS, NEVADA 89102

DEL WEBB COMMUNITIES, INC.
SUN CITY LAS VEGAS UNIT NO. 42
UTILITY PLAN V

SHEET
8
OF 10 SHEETS

SEWER AS-BUILTS

NOTE: ALL SEWER MANHOLES ARE 48" DIAMETER UNLESS OTHERWISE NOTED.

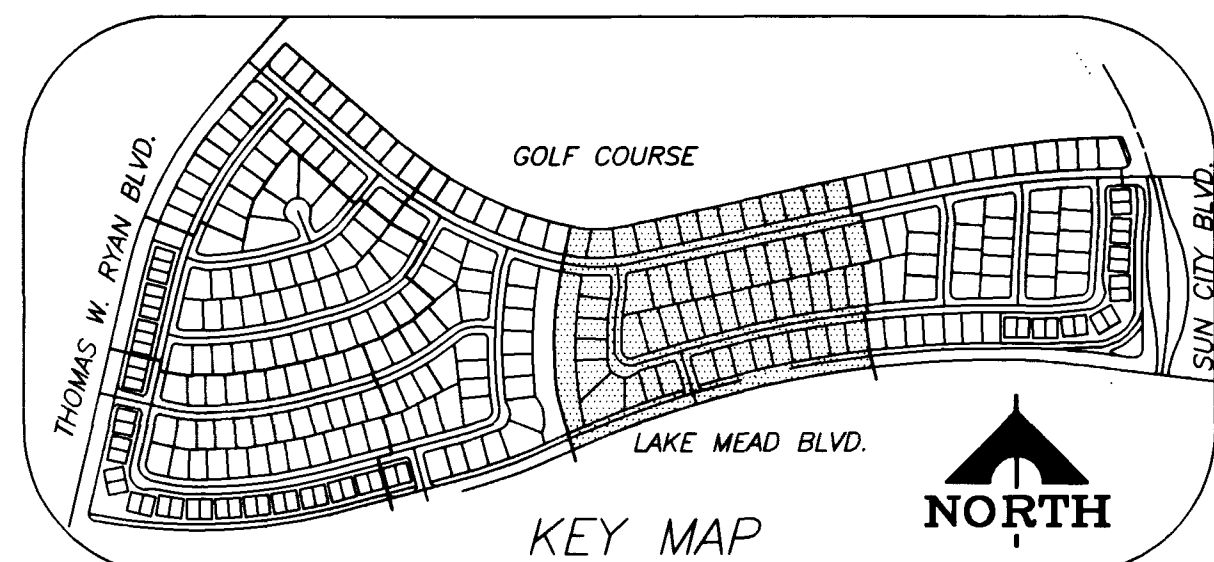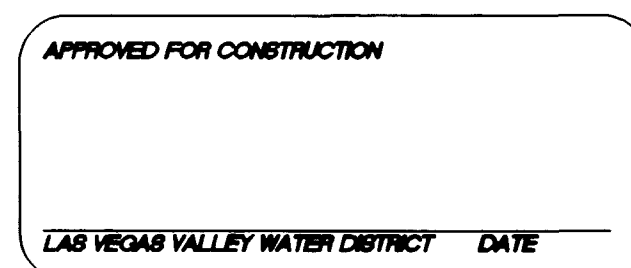

"As-Built" 3074-4141-42



BOLT COORDINATES



U.S. DEPARTMENT OF THE INTERIOR
BUREAU OF RECLAMATION
LAS VEGAS, NEVADA

UTILITY PLAN A

8

SEWER AS-BUILTS

NOTE: ALL SEWER MANHOLES ARE 48" DIAMETER UNLESS OTHERWISE NOTED.

