
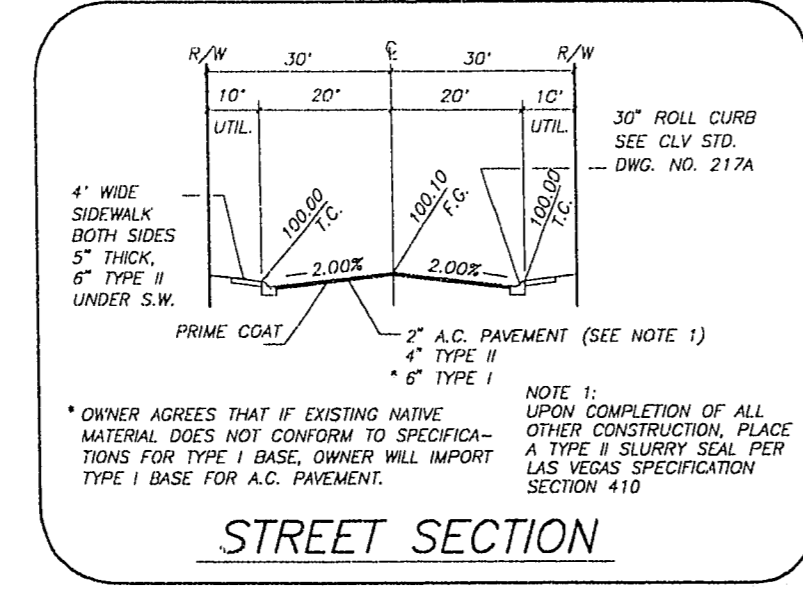
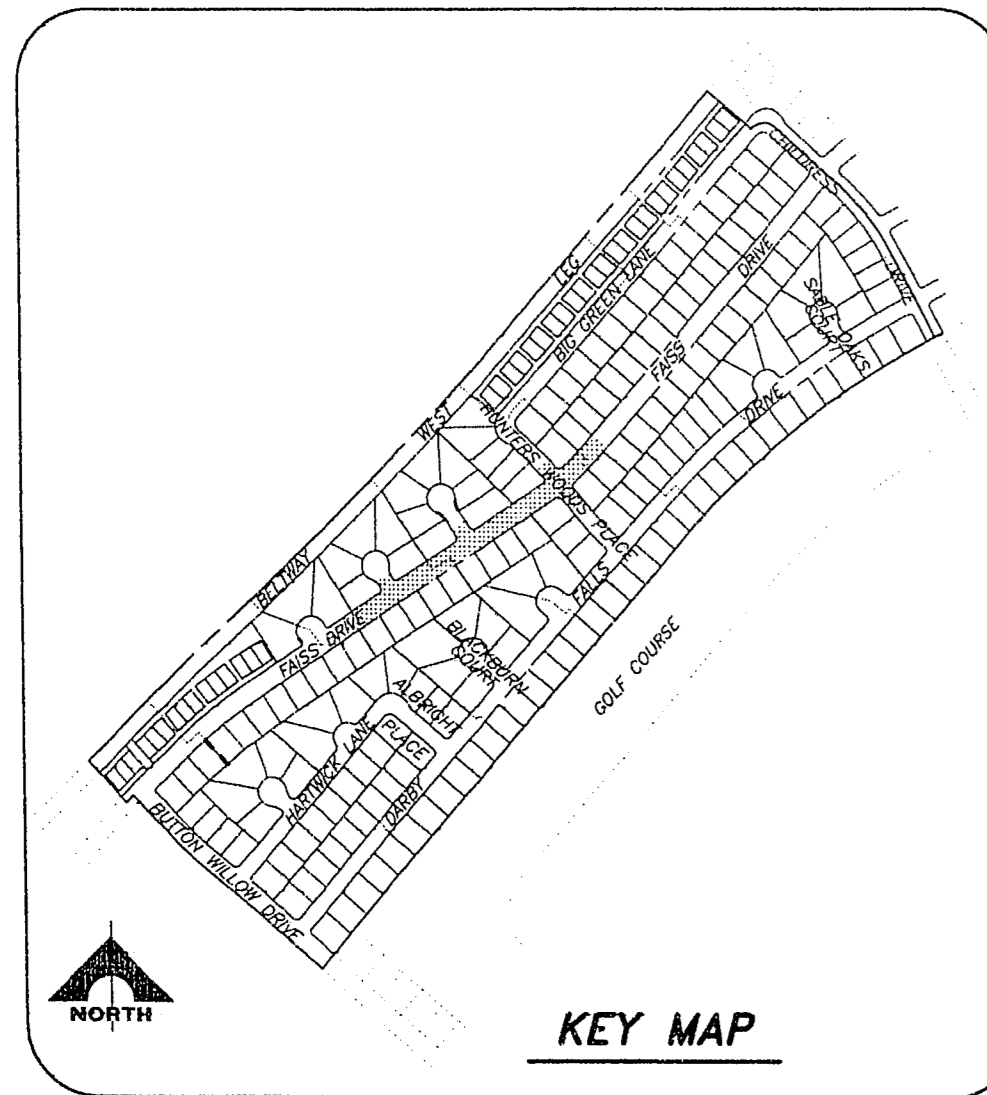


JOB NO. 701.184 PLOTTED 04/21/94 8:00 AM DRAWING C:\DRAWINGS\DWG\UNIT3\04-1-12 BY: SMC

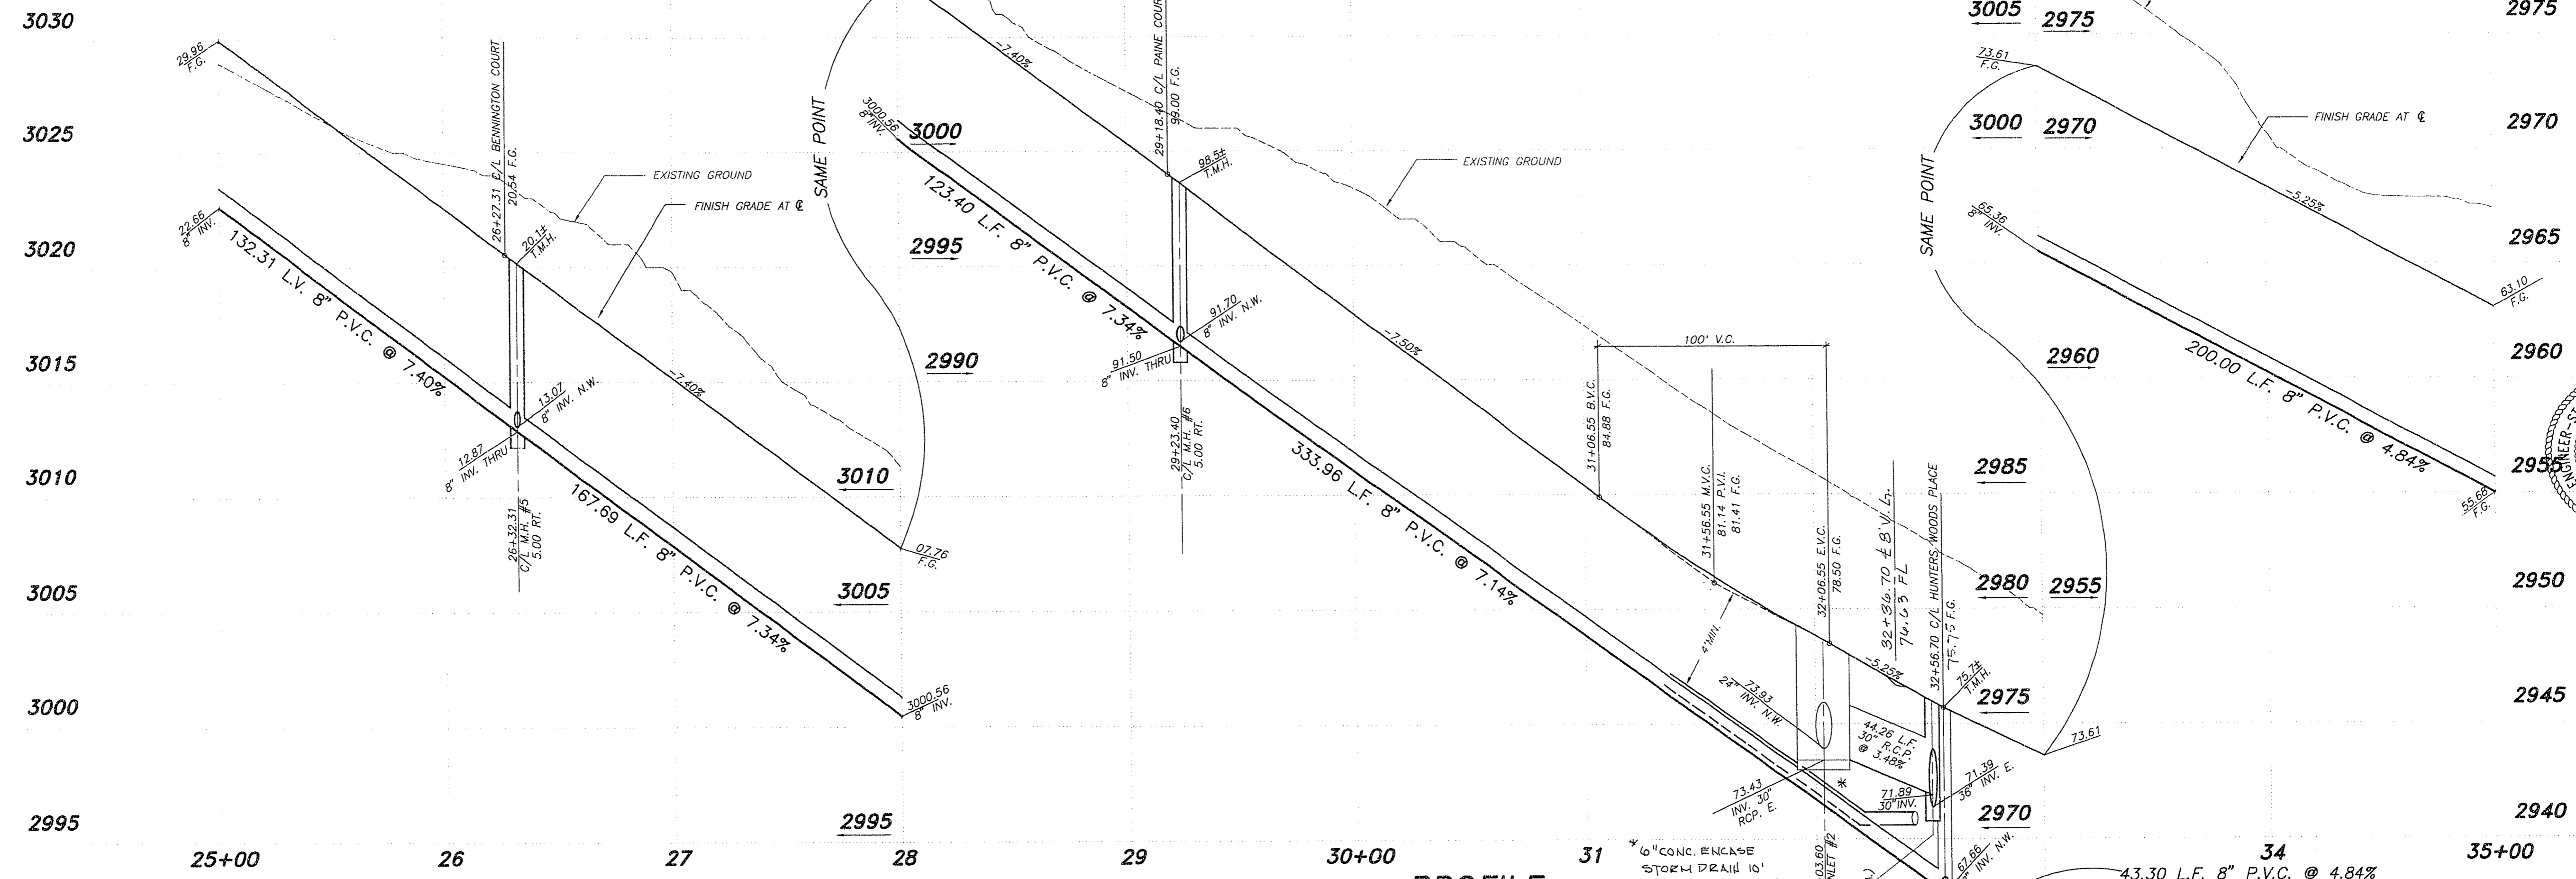

1 CURVE TABLE

CURVE	DELTA	RADIUS	LENGTH	TANGENT
1	90°00'00.00"	20.00'	31.42'	20.00'
2	03°52'29.68"	855.00'	37.95'	28.99'
3	83°56'42.31"	20.00'	32.74'	21.43'
4	04°07'55.35"	895.00'	64.55'	32.29'
5	87°37'11.35"	20.00'	30.59'	19.19'
6	31°21'24.17"	20.00'	31.89'	20.48'
7	16°00'00.00"	875.00'	244.35'	122.97'
8	04°58'53.24"	855.00'	74.34'	37.19'
9	03°52'00.35"	855.00'	80.40'	30.21'
10	08°53'43.24"	855.00'	102.95'	51.54'
11	07°06'27.35"	895.00'	111.03'	55.58'
12	01°55'02.00"	855.00'	28.61'	14.31'
13	03°14'27.00"	895.00'	50.62'	25.32'

MH COORDINATES

MH#	NORTH	EAST
5	532642.956	574492.246
6	532801.495	574736.374
7	532988.357	575012.795

SD MH COORDINATES

MH#	NORTH	EAST
2	532958.403	575031.016

SD INLET COORDINATES


INLET#	NORTH	EAST
1	532973.319	574953.201
2	532940.990	574976.742

SEWER LINE TABLE

LINE	BEARING	DISTANCE
5	S57°00'00"W	291.00'
6	S57°00'00"W	291.00'
7	S82°11'56"W	333.96'
8	S42°26'55"E	397.76'

SD LINE TABLE

LINE	BEARING	DISTANCE
1	S36°03'43"E	40.00'
2	N69°04'43"E	44.26'
15	N39°35'20"W	271.26'

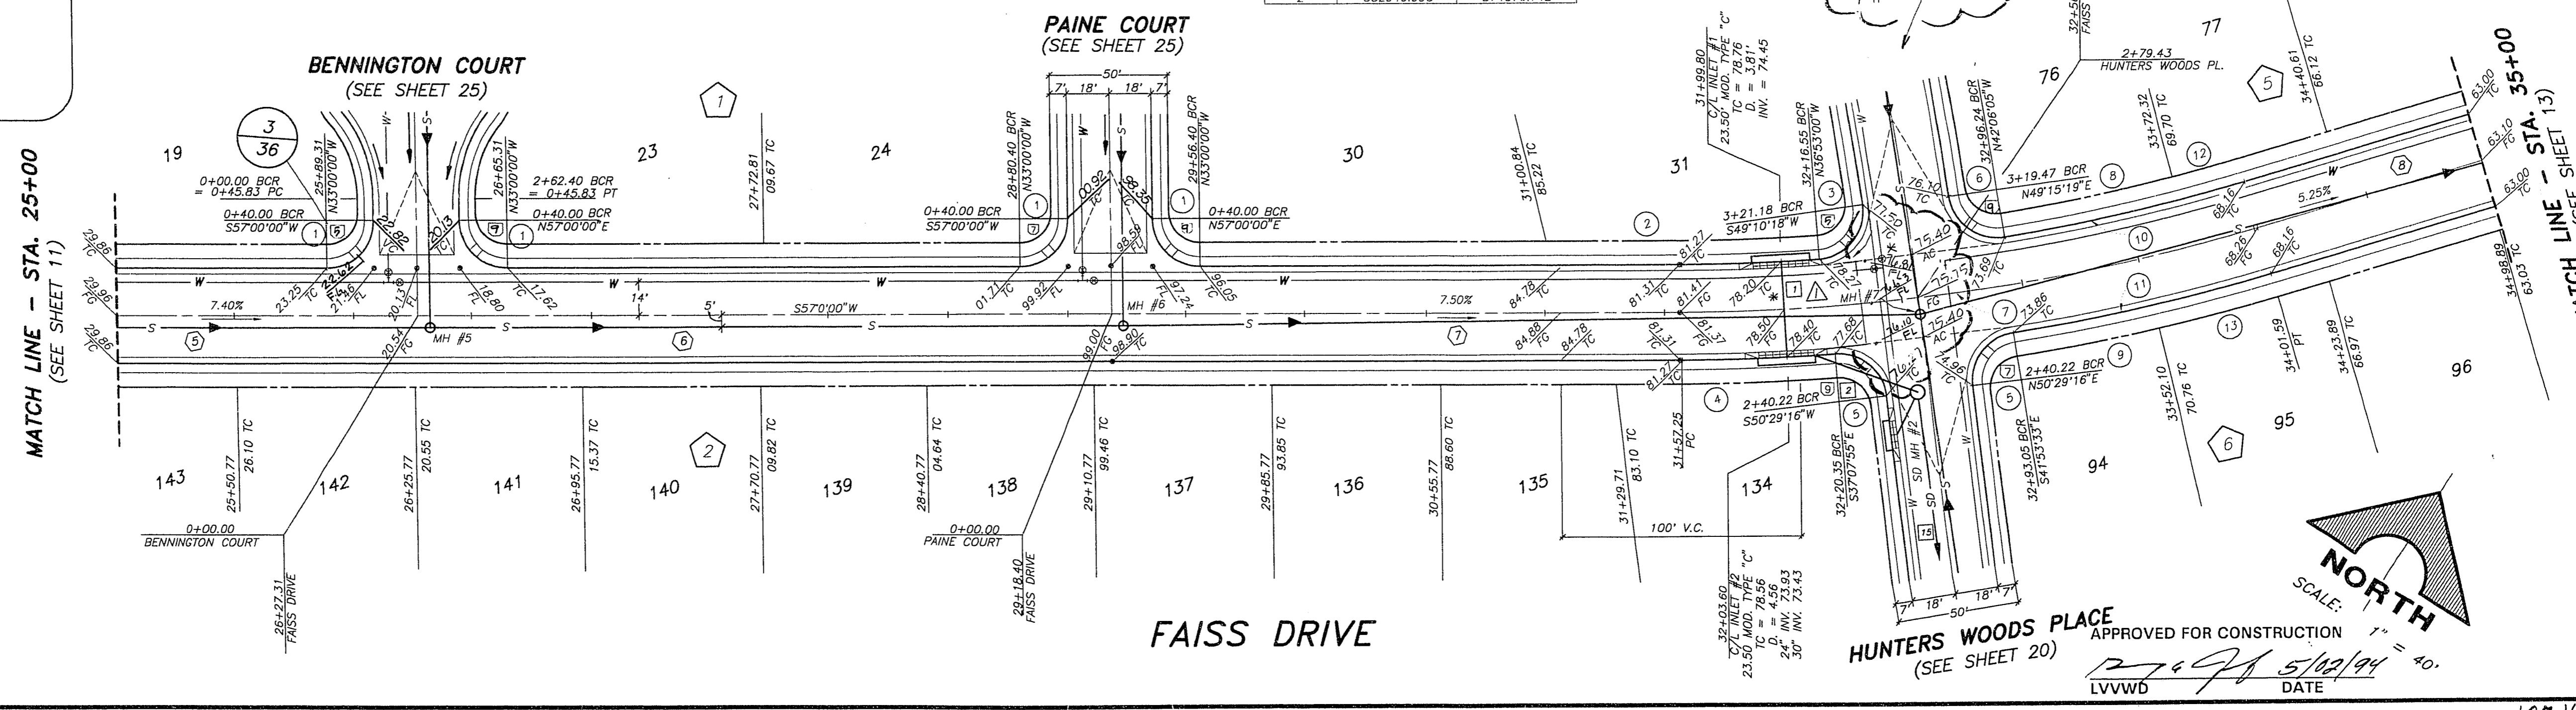

RECORD COPY

DATE: 5/12/94

PROJECT: SUN CITY LAS VEGAS UNIT NO. 43

DESIGNER: G. C. WALLACE, INC. Engineering/Architecture

1555 SOUTH RAINBOW BLVD./LAS VEGAS, NEVADA 89102

DATE: 5/12/94

PROJECT: SUN CITY LAS VEGAS UNIT NO. 43

DESIGNER: G. C. WALLACE, INC. Engineering/Architecture

1555 SOUTH RAINBOW BLVD./LAS VEGAS, NEVADA 89102

SHEET 12 OF 38 SHEETS

10-10-62

107Y-4/41-43