


MATCH LINE - SEE UTILITY PLAN IV SHEET 7

MATCH LINE - SEE UTILITY PLAN VI SHEET 9


MATCH LINE - SEE UTILITY PLAN I SHEET 4

MATCH LINE - SEE UTILITY PLAN V SHEET 8

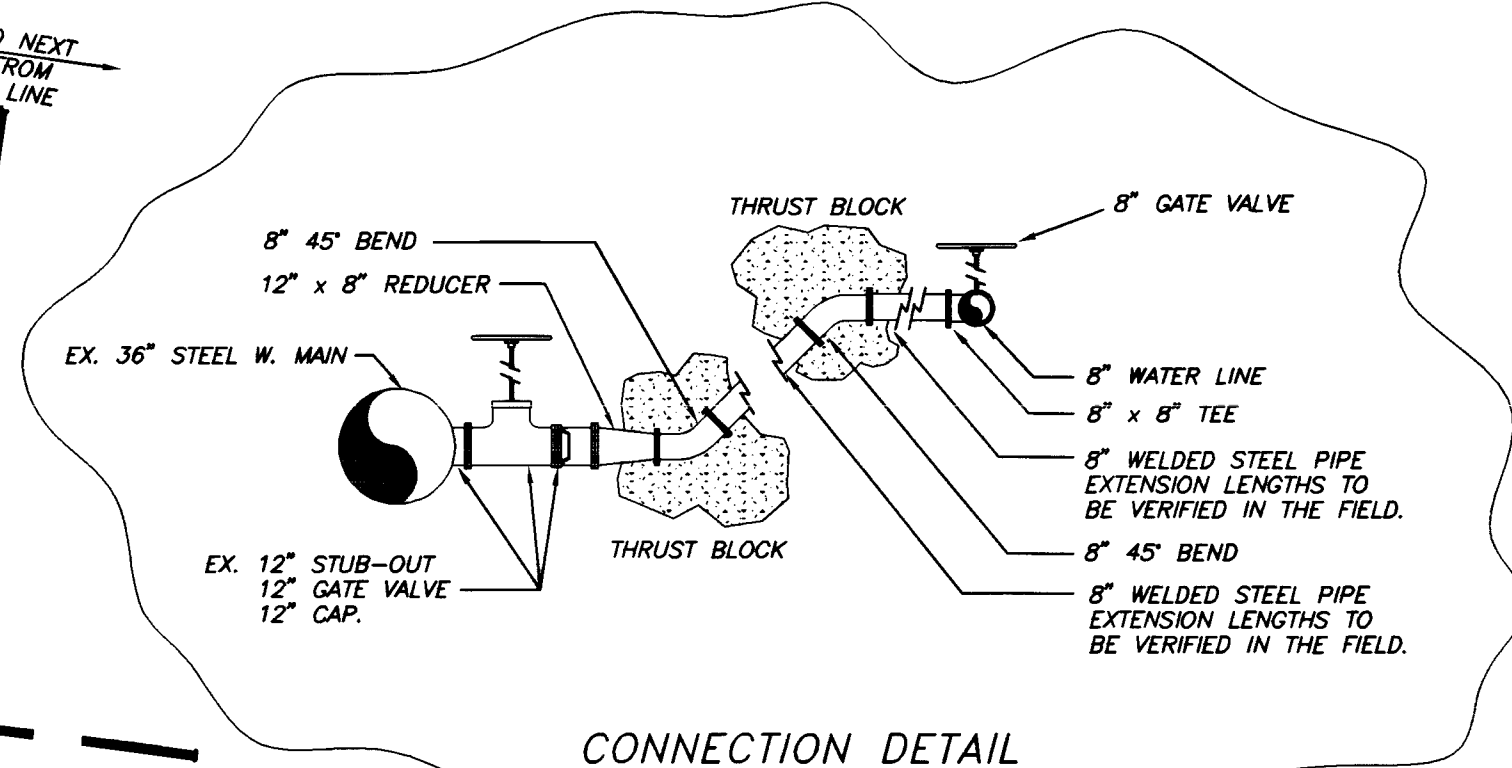

CONNECTION DETAIL

APPROVED FOR CONSTRUCTION  
LAS VEGAS VALLEY WATER DISTRICT DATE

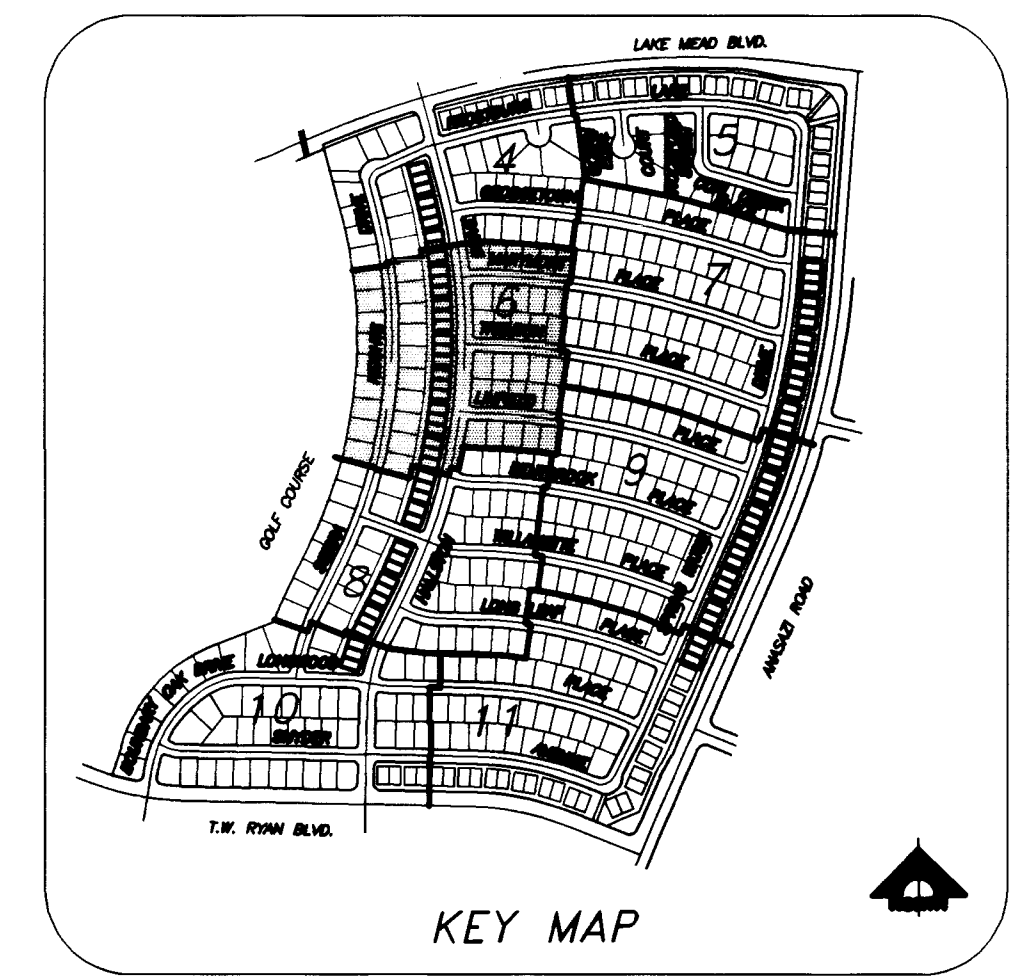


KEY MAP  
"As Built" 307Y-414/-46

ABANDONED VALVES:  
ALL ABANDONED VALVES SHALL BE ABANDONED IN THE CLOSED POSITION UNLESS SHOWN OTHERWISE BY REMOVING A MINIMUM OF THE TOP 12 INCHES OF THE VALVE BOX AND FILLING REMAINING PORTION OF THE VALVE BOX WITH CONCRETE HAVING A COMPRESSIVE STRENGTH AT LEAST 2,000 PSI.

# SEWER AS-BUILTS


ALL SEWER MANHOLES 48" DIAMETER UNLESS OTHERWISE NOTED

REV.	DATE	DESCRIPTION	BY	DATE

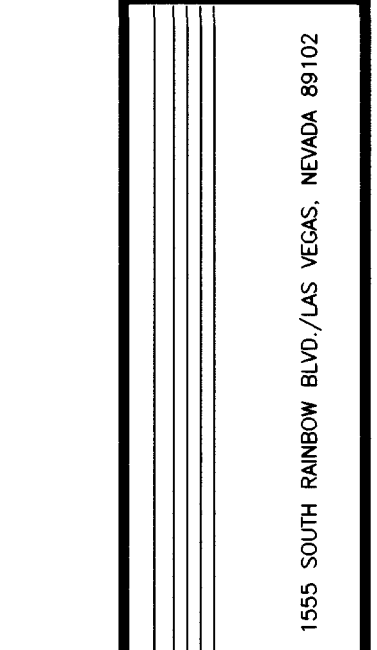

G.C. WALLACE, INC.  
Engineering/Architecture  
1555 SOUTH RAINBOW BLVD./LAS VEGAS, NEVADA 89102

DEL WEBB COMMUNITIES, INC.  
SUN CITY LAS VEGAS UNIT NO. 46  
UTILITY PLAN III

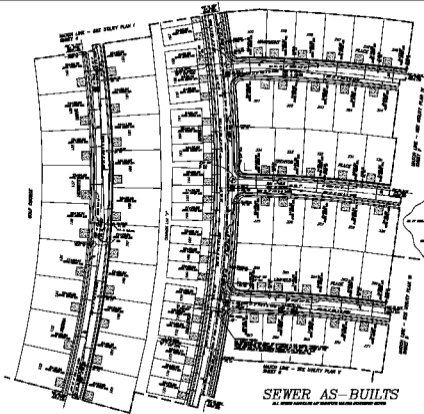

### SEWER AS-BUILTS

ALL DIMENSIONS UNLESS OTHERWISE SPECIFIED



J.C. WILLIAMS, INC.  
Professional Engineers

NO. 1000 CONGRESS ST.  
S.E. CITY OKLA. 73104

SHEET PLAN 18