

MATCH LINE SEE UTILITY PLAN V SHEET 4



MATCH LINE SEE UTILITY PLAN V SHEET 6

MATCH LINE - SEE UTILITY PLAN II SHEET 5


MATCH LINE - SEE UTILITY PLAN VI SHEET 9

SEWER AS-BUILTS

ALL SEWER MANHOLES 48" DIAMETER UNLESS OTHERWISE NOTED

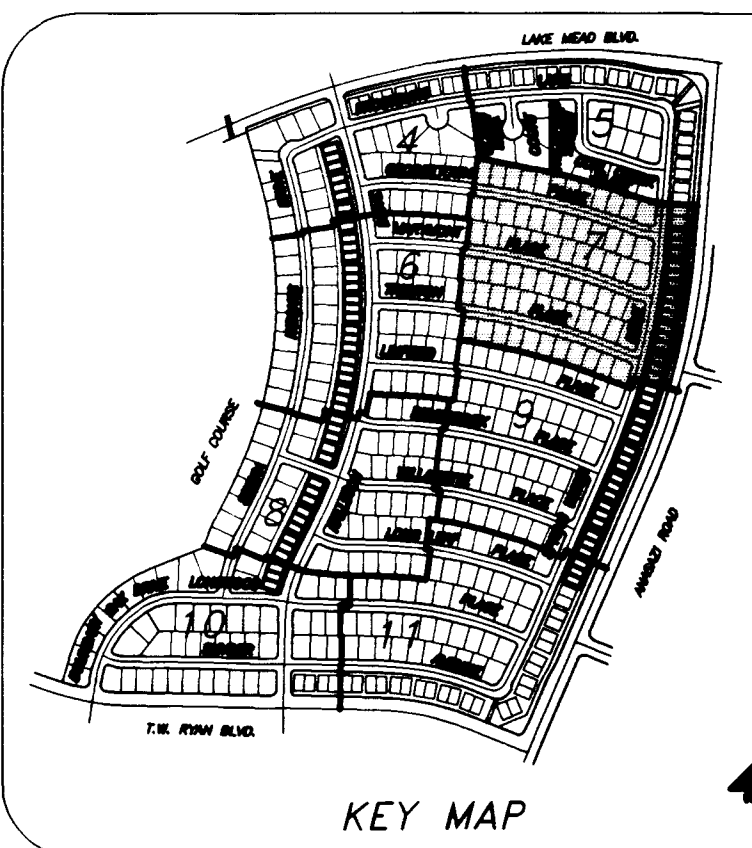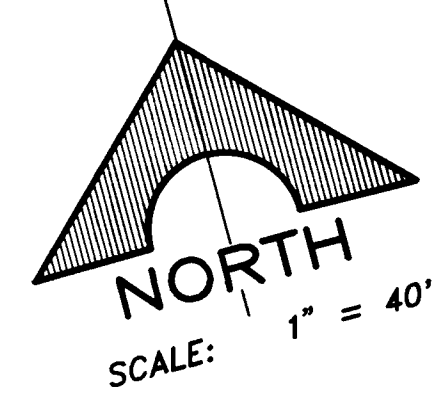

APPROVED FOR CONSTRUCTION
LAS VEGAS VALLEY WATER DISTRICT DATE

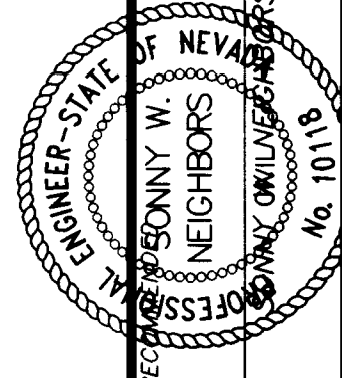

DEL WEBB COMMUNITIES, INC.
SUN CITY LAS VEGAS UNIT NO. 46

UTILITY PLAN IV

SHEET 7

G.C. WALLACE, INC.
Engineering/Architecture
1555 SOUTH RAINBOW BLVD./LAS VEGAS, NEVADA 89102

ANASAZI ROAD
(SEE IMPROVEMENT PLANS PER G.C. WALLACE, INC.)

PROPOSED PERIMETER BLOCKWALL
(SEE IMPROVEMENT PLANS PER G.C. WALLACE, INC.)

"As Built" 307Y-4141-46

OF 48 SHEETS

