

MATCH LINE - SEE UTILITY PLAN IV SHEET 7


MATCH LINE - SEE UTILITY PLAN III SHEET 6

MATCH LINE - SEE UTILITY PLAN V SHEET 8

MATCH LINE - SEE UTILITY PLAN VIII SHEET 11


SEWER AS-BUILTS

ALL SEWER MANHOLES 48" DIAMETER UNLESS OTHERWISE NOTED

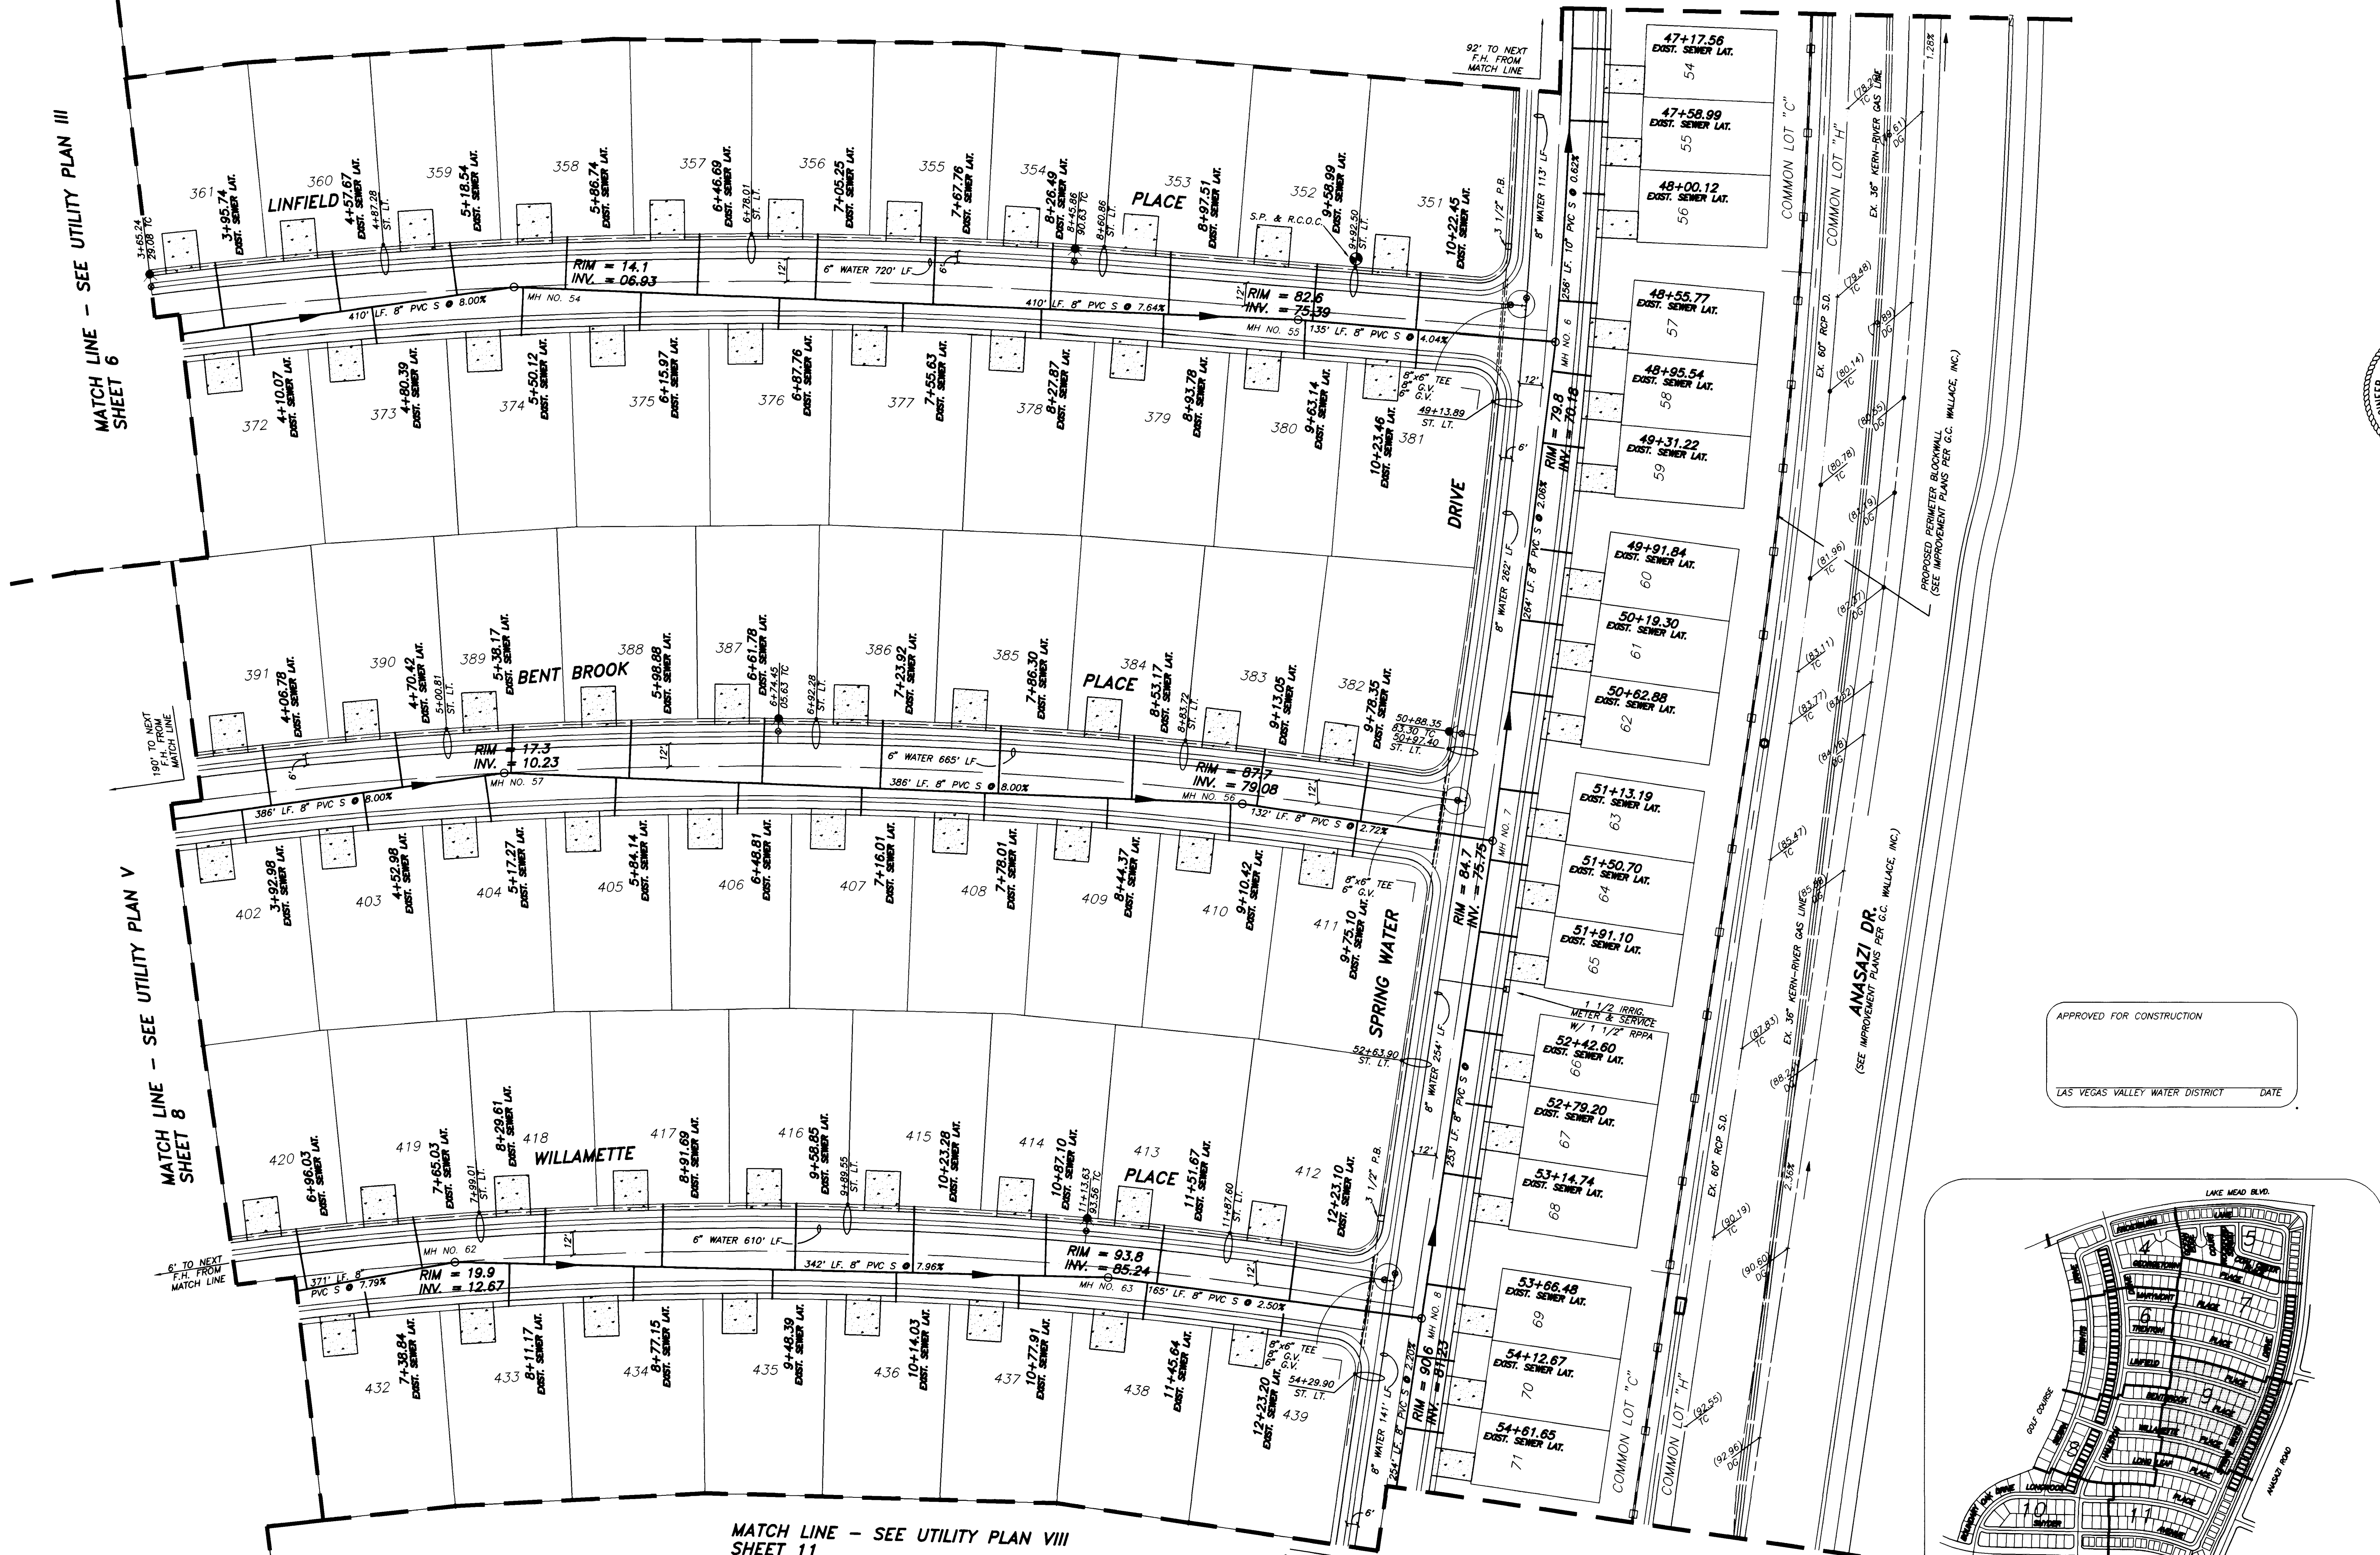

APPROVED FOR CONSTRUCTION

LAS VEGAS VALLEY WATER DISTRICT _____ DATE _____

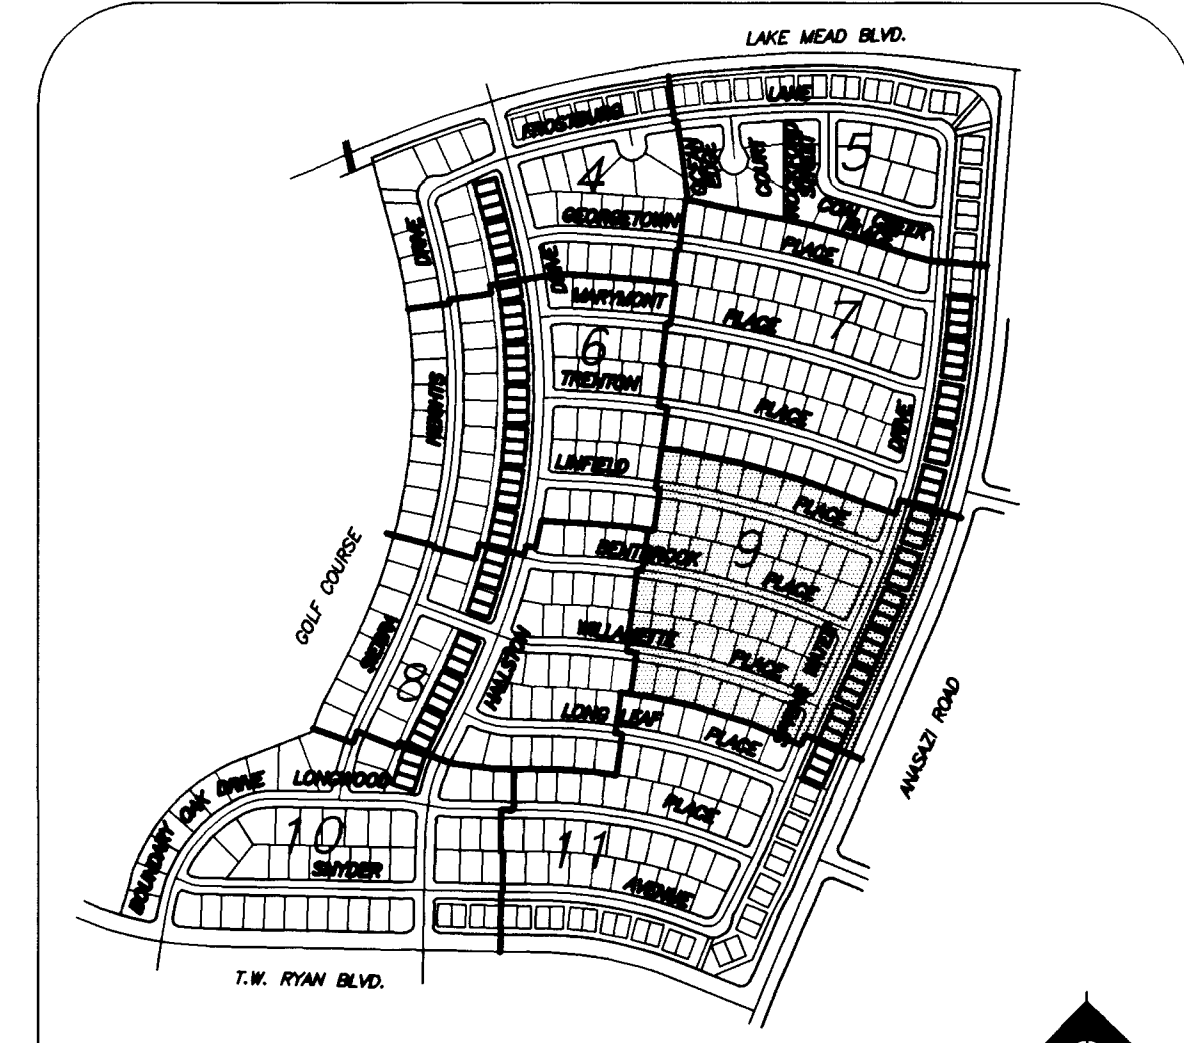

| REV. | DATE | DESCRIPTION | CL. | DATE |
|------|------|-------------|-----|------|
| | | | | |
| | | | | |
| | | | | |

REGISTERED PROFESSIONAL ENGINEER - STATE OF NEVADA
 SONNY W. WALLACE
 P.E. NO. 10118
 No. 10118

G.C. WALLACE, INC.
 Engineering/Architecture
 1555 SOUTH RAINBOW BLVD., LAS VEGAS, NEVADA 89102


DEL WEBB COMMUNITIES, INC.
 SUN CITY LAS VEGAS UNIT NO. 46
 UTILITY PLAN VI

SHEET
9
 OF 48 SHEETS

"As Built" 307Y-4141-46

SEE SHEET 10 - SEE UTILITY PLAN 10
SHEET 7

SEE SHEET 9 - SEE UTILITY PLAN 9

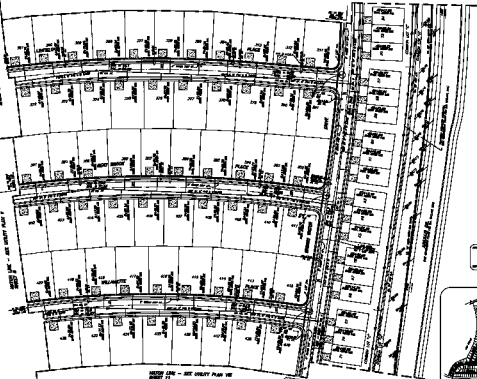

SEE SHEET 8 - SEE UTILITY PLAN 8

SEE SHEET 11 - SEE UTILITY PLAN 11
SHEET 11

SEWER AS-BUILTS

ALL DIMENSIONS UNLESS OTHERWISE NOTED



KEY MAP



W.C. WALLACE, INC.
Professional Engineer
1000 W. 10th St., Suite 100
Oklahoma City, Oklahoma 73106
Tel: (405) 233-1111

SEE SHEET 10 - SEE UTILITY PLAN 10
SEE SHEET 11 - SEE UTILITY PLAN 11
SEE SHEET 9 - SEE UTILITY PLAN 9
SEE SHEET 8 - SEE UTILITY PLAN 8
SEE SHEET 7 - SEE UTILITY PLAN 7