


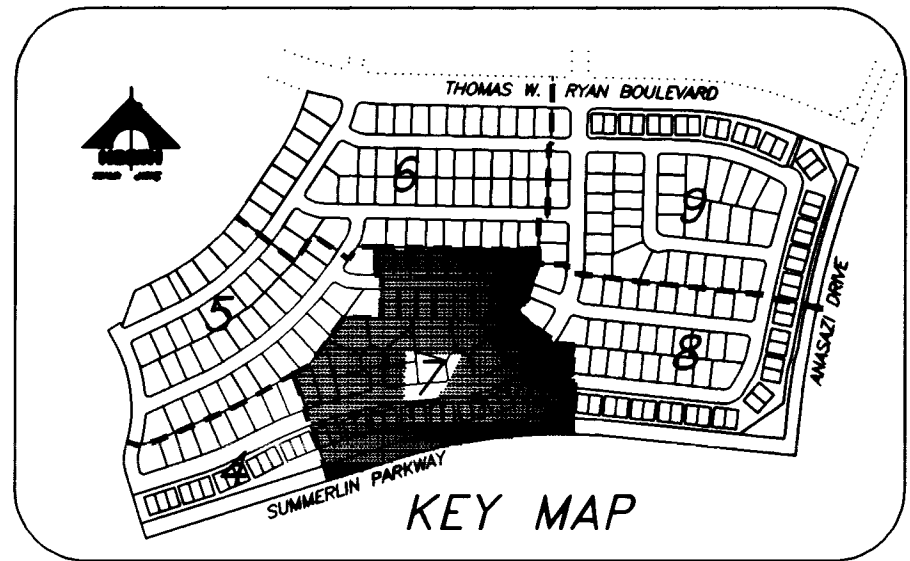

NOTE:
ALL SEWERS SHOWN ON THIS SHEET
ARE PUBLIC SEWERS.

APPROVED FOR CONSTRUCTION

LAS VEGAS VALLEY WATER DISTRICT DATE

"As Built" 3074-4141-47

SEWER AS-BUILTS

WATSON LOAF - DUTY PLAN IV
SEE SHEET A

20000 PSI

2000 PROBLEMS



— 70.9
— 41.4

2000

MATCH LINE - UTILITY PLAN
 SEE SHEET 6

SWITCH LINE - SEE PLAN 2
SHEET 2

WATSON LEE STREET & VILLAGE PLAZA

Figure 1

CONSTITUTIONAL PART

2005 4457

1000

STANLEY ABE

ALL KNOW SPAN ON THE SPAT



0					
1					
2					
3					
4					
5					
6					
7					
8					
9					

D.C. WALLACE, INC.
Engineering/Construction
100 WEST PARK BLVD. NEW YORK, NY 10019

TRE COMPANY, INC., REG.
ADDRESS - UNIT NO. 47
STREET NAME

	DATE	TIME	TESTER