
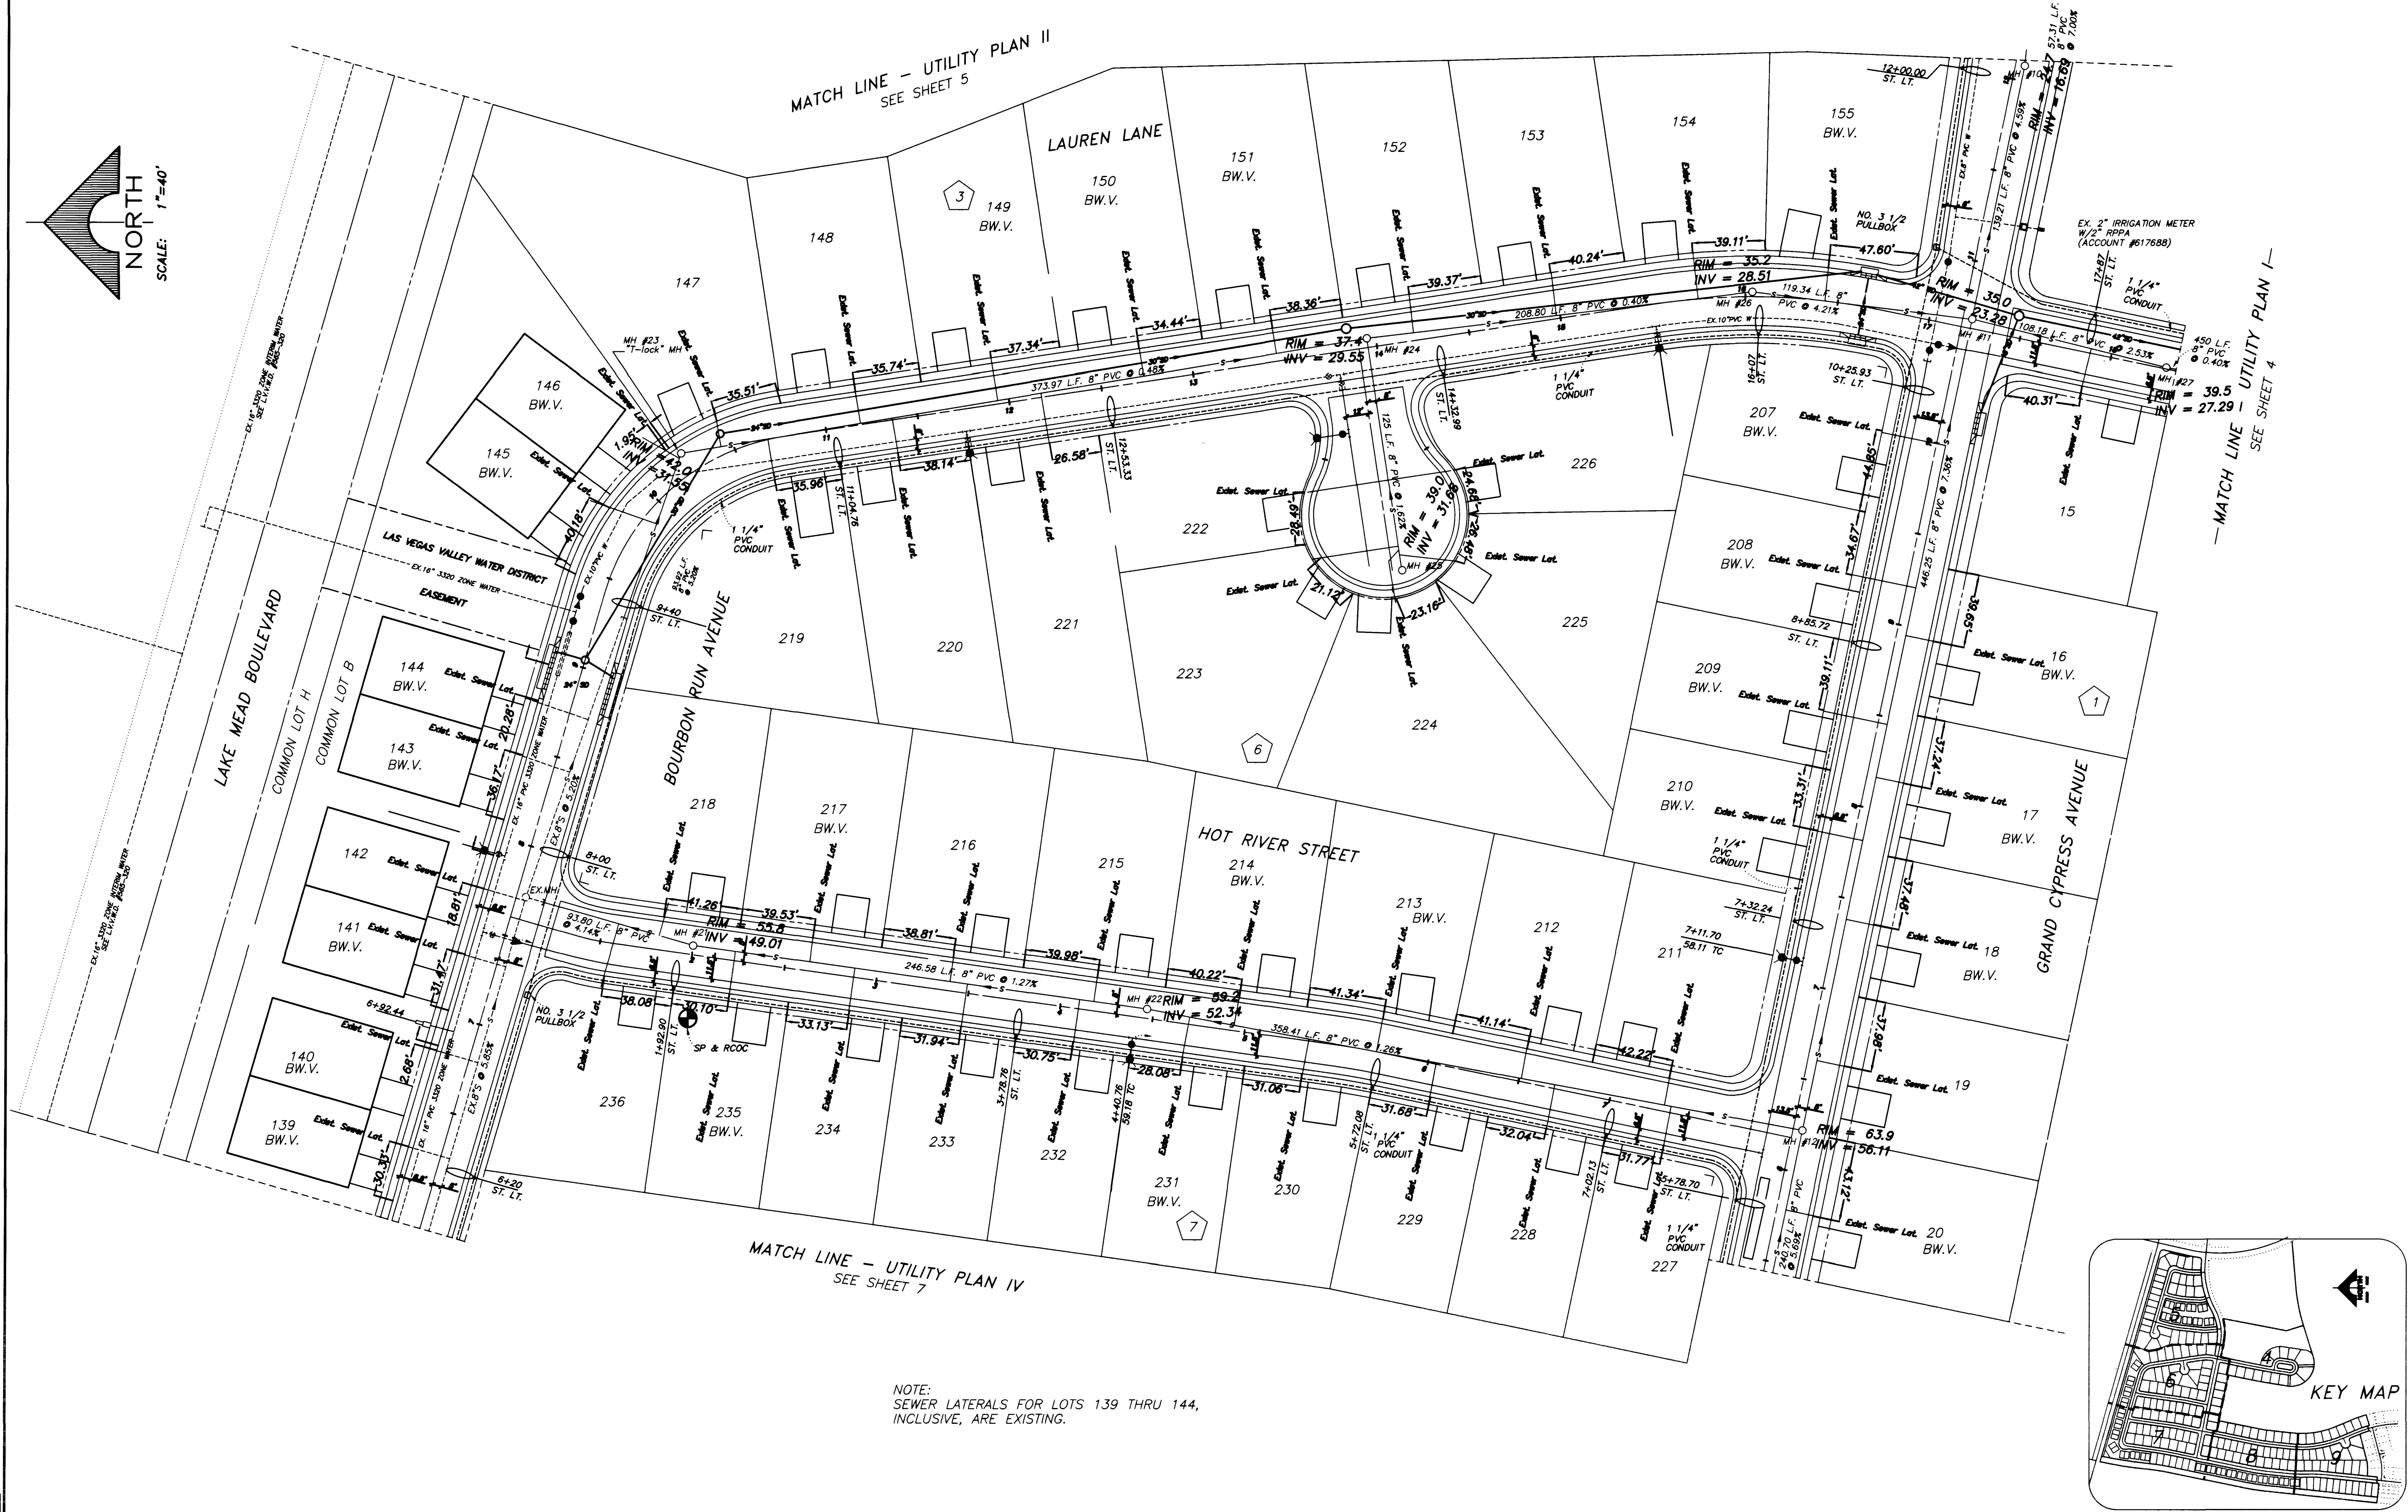


JOB NO. 701.248 PLOTTED: 03/25/97 11:51 am DRAWING: C:\UTILITY\081-6 BY: C. Powell

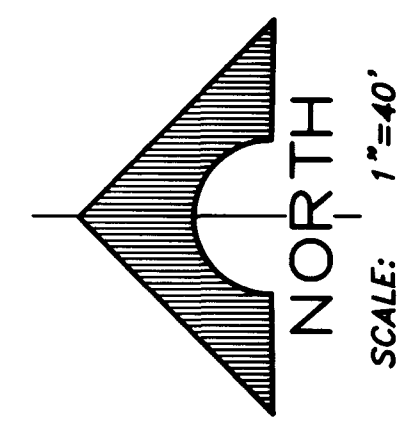


MATCH LINE - UTILITY PLAN II
SEE SHEET 5

MATCH LINE UTILITY PLAN I -
SEE SHEET 4

MATCH LINE - UTILITY PLAN IV
SEE SHEET 7

NOTE:
SEWER LATERALS FOR LOTS 139 THRU 144,
INCLUSIVE, ARE EXISTING.

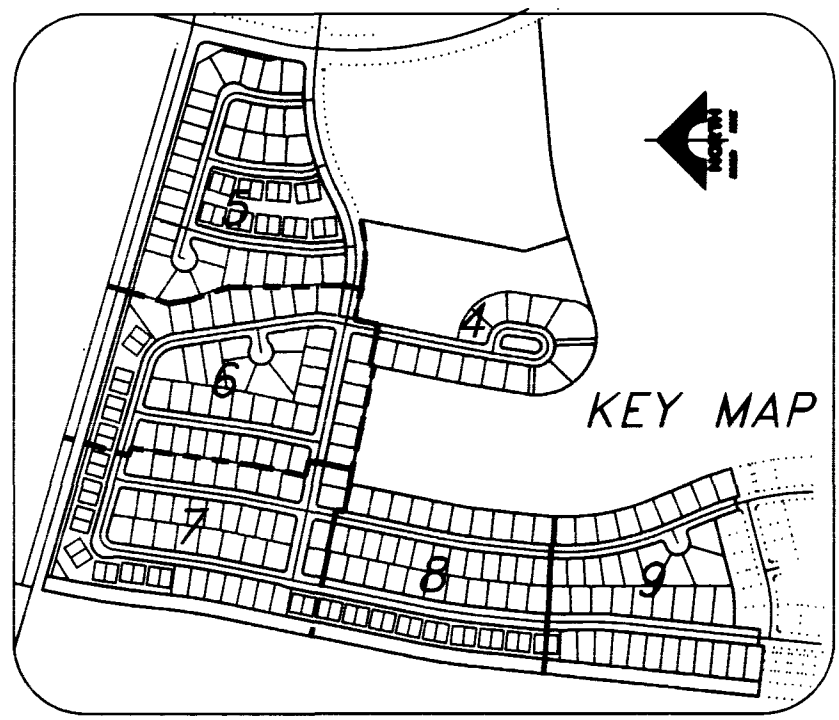

SEWER AS-BUILTS

ALL SEWER MANHOLES 48" DIAMETER UNLESS OTHERWISE NOTED

APPROVED FOR CONSTRUCTION
CITY OF LAS VEGAS FIRE DEPARTMENT DATE

APPROVED FOR CONSTRUCTION
LAS VEGAS VALLEY WATER DISTRICT DATE

RECOMMENDED	DATE	10/18
	REV	DATE
	DESCRIPTION	
SONNY W. NEIGHBORS P.E. NO. DATE		
G. C. WALLACE, INC. Engineering/Architecture 1555 SOUTH RAINBOW BLVD./LAS VEGAS, NEVADA 89102		
DEL WEBB COMMUNITIES, INC. SUN CITY SUMMERLIN - UNIT NO. 51 UTILITY PLAN III		
SHEET 6 OF 37 SHEETS		

"As-Built" 3074-4141-51

