



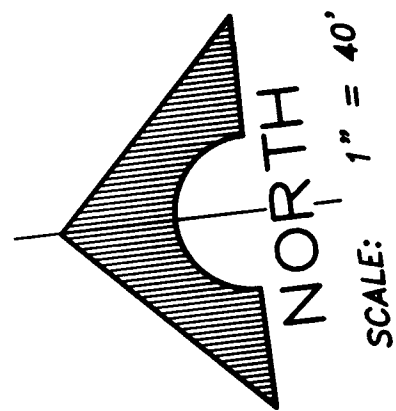


MATCH LINE - UTILITY PLAN III
SEE SHEET 6

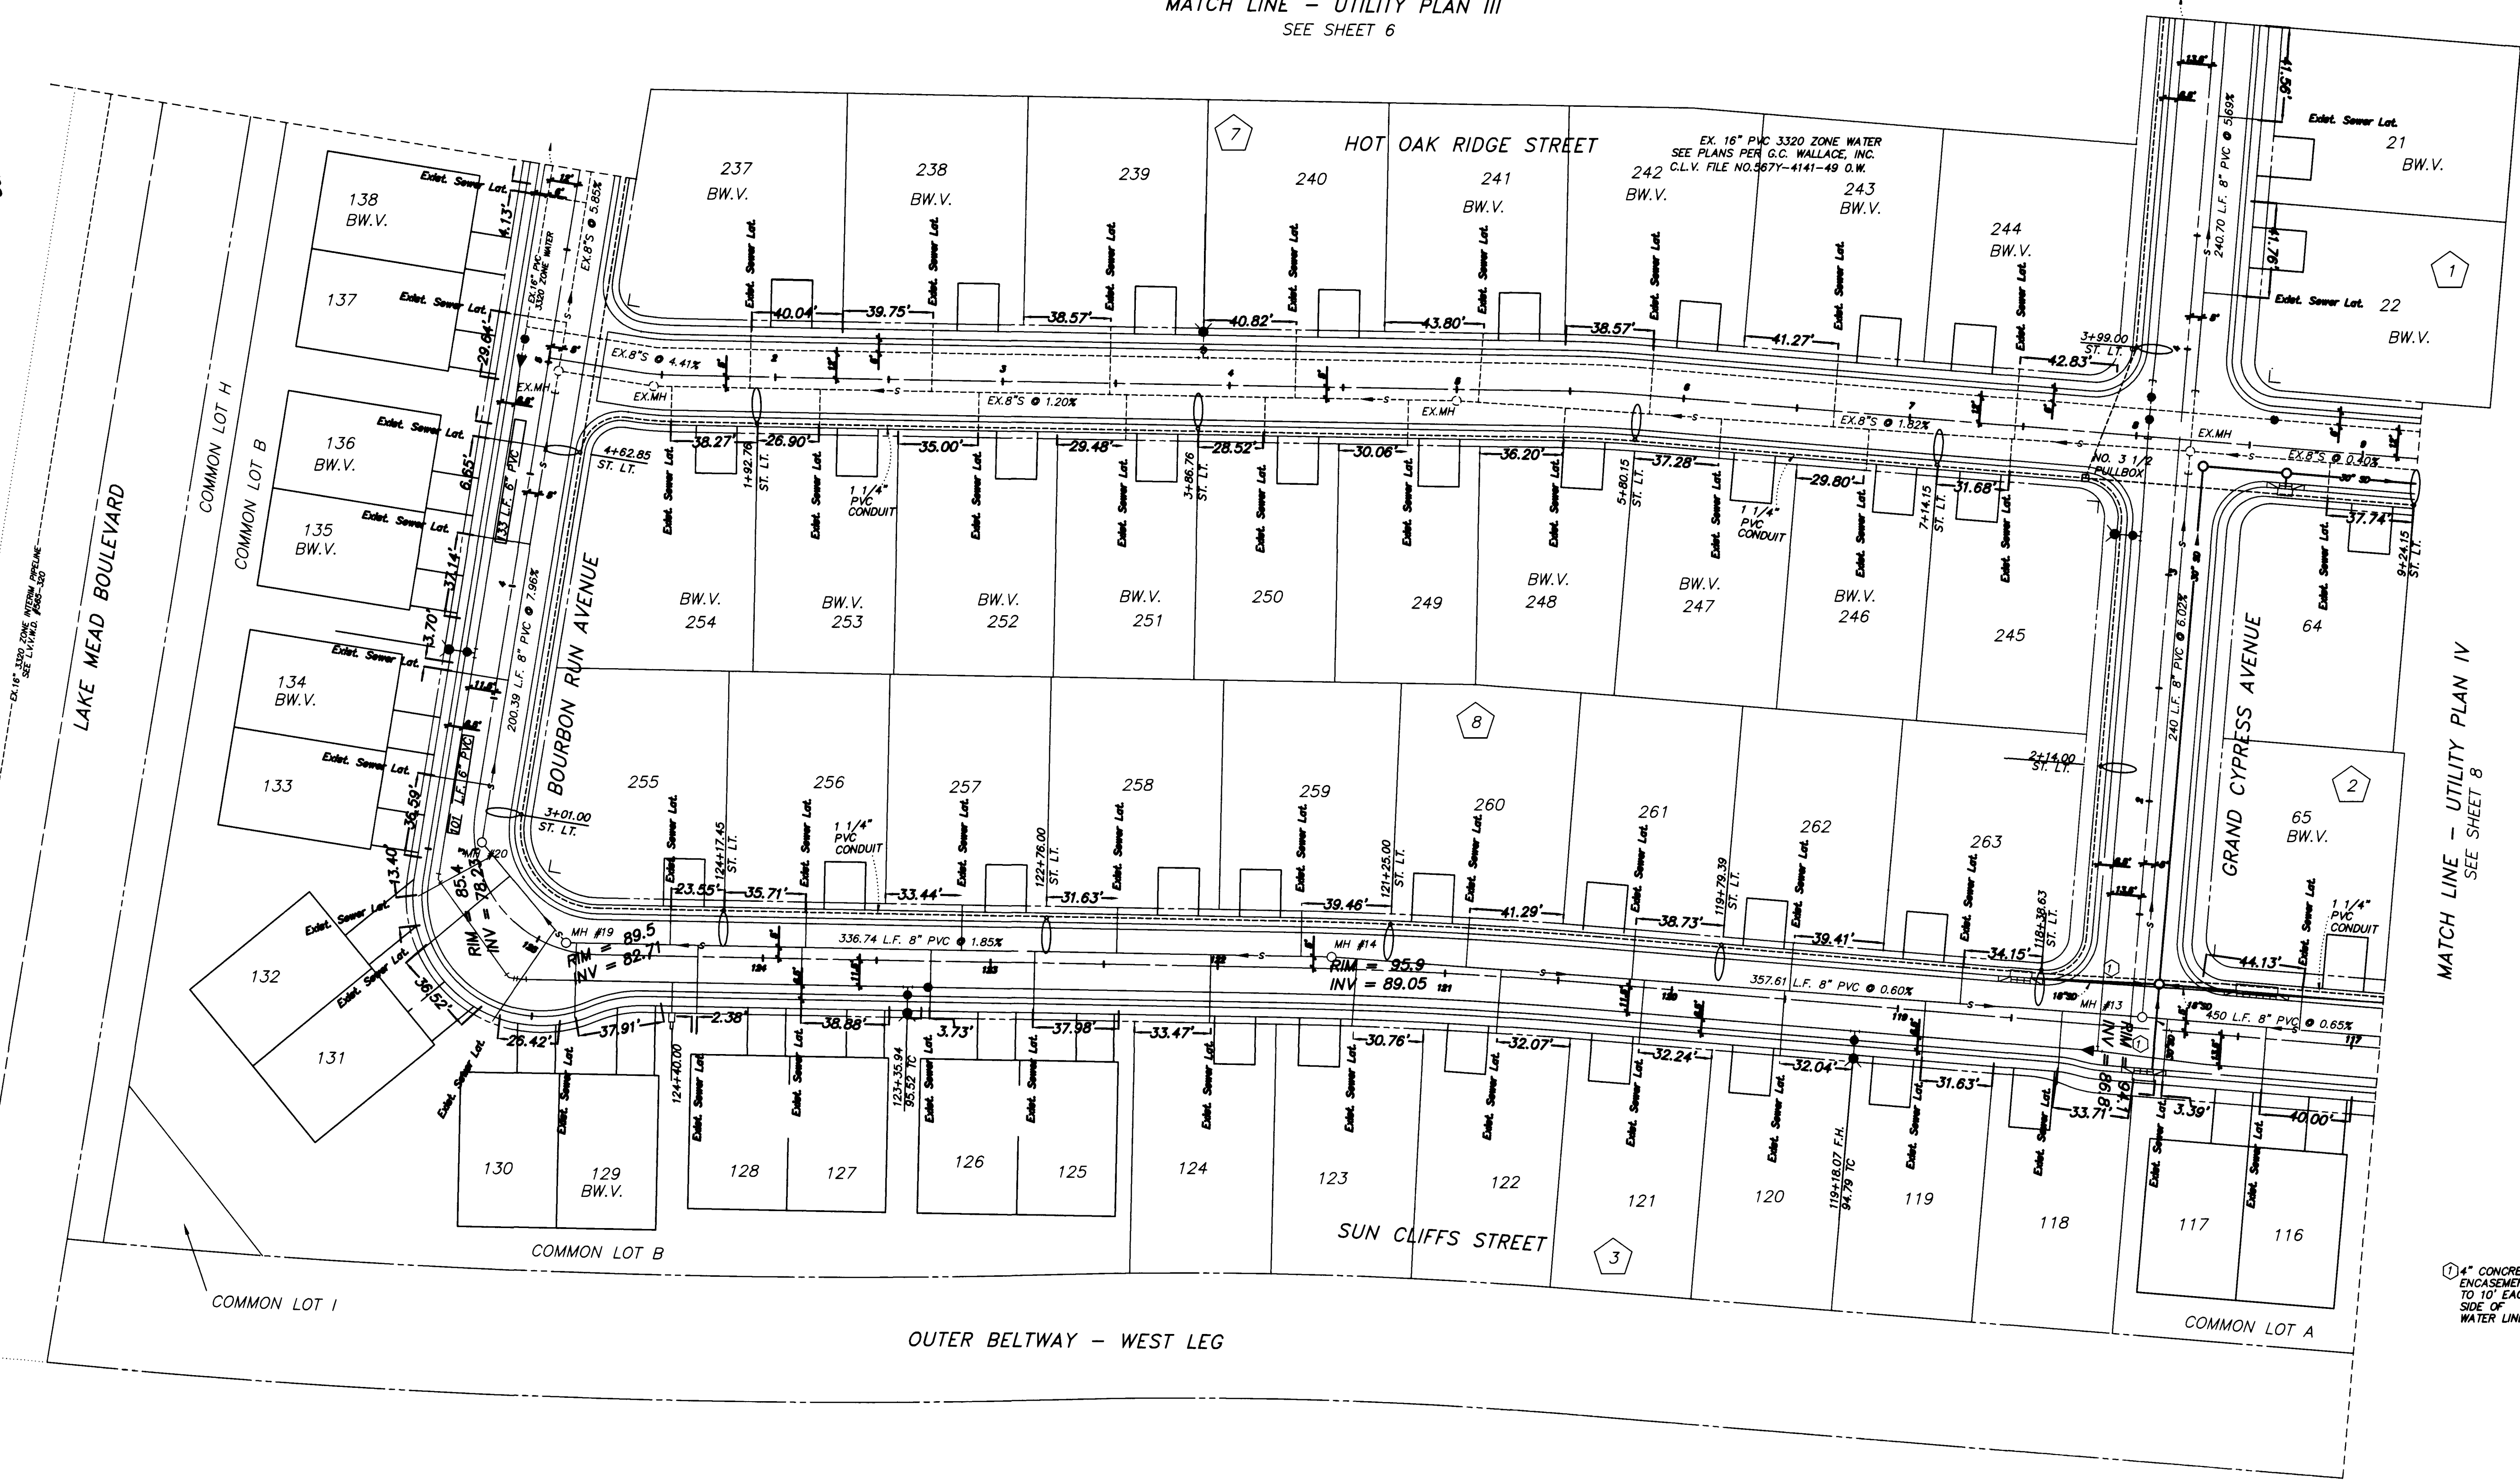

MATCH LINE - UTILITY PLAN IV
SEE SHEET 8

4" CONCRETE
ENCASEMENT
TO 10" EACH
SIDE OF
WATER LINE

NOTE:
SEWER LATERALS FOR LOT 64, LOT 137, LOT 138 AND
LOTS 237 THRU 254, INCLUSIVE, ARE EXISTING.

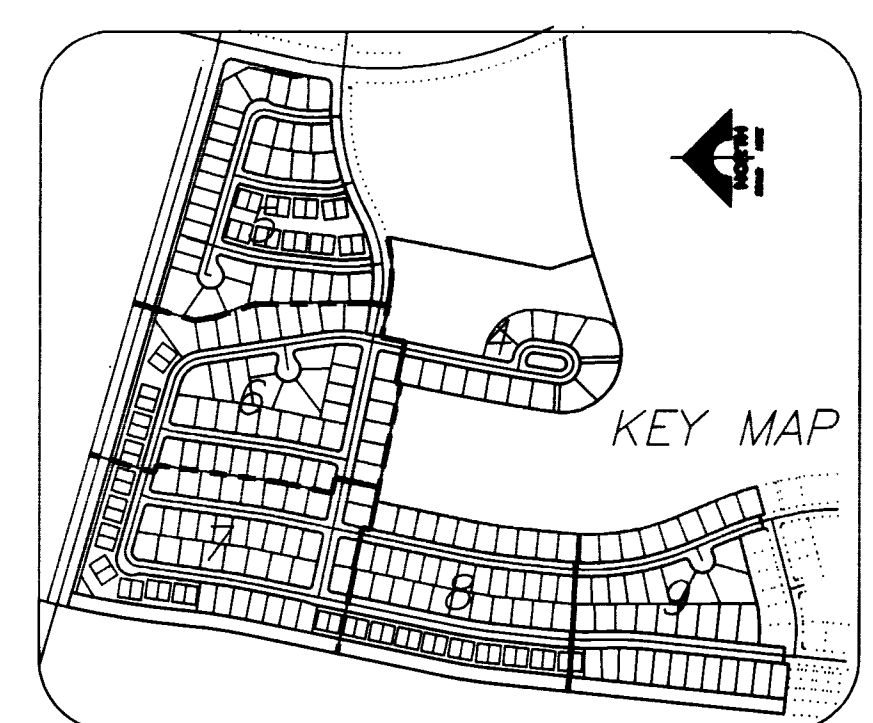

APPROVED FOR CONSTRUCTION	
CITY OF LAS VEGAS FIRE DEPARTMENT	DATE
APPROVED FOR CONSTRUCTION	
LAS VEGAS VALLEY WATER DISTRICT	DATE

SEWER AS-BUILTS

ALL SEWER MANHOLES 48" DIAMETER UNLESS OTHERWISE NOTED

RECOMMENDED	
SONNY W. NEIGHBORS	10118
P.L.E. NO.	DATE
G.C. WALLACE, INC. Engineering/Architecture	
1555 SOUTH RAINBOW BLVD., LAS VEGAS, NEVADA 89102	
DEL WEBB COMMUNITIES, INC.	
SUN CITY SUMMERLIN - UNIT NO. 51	
UTILITY PLAN IV	
SHEET 7	
OF 37 SHEETS	

